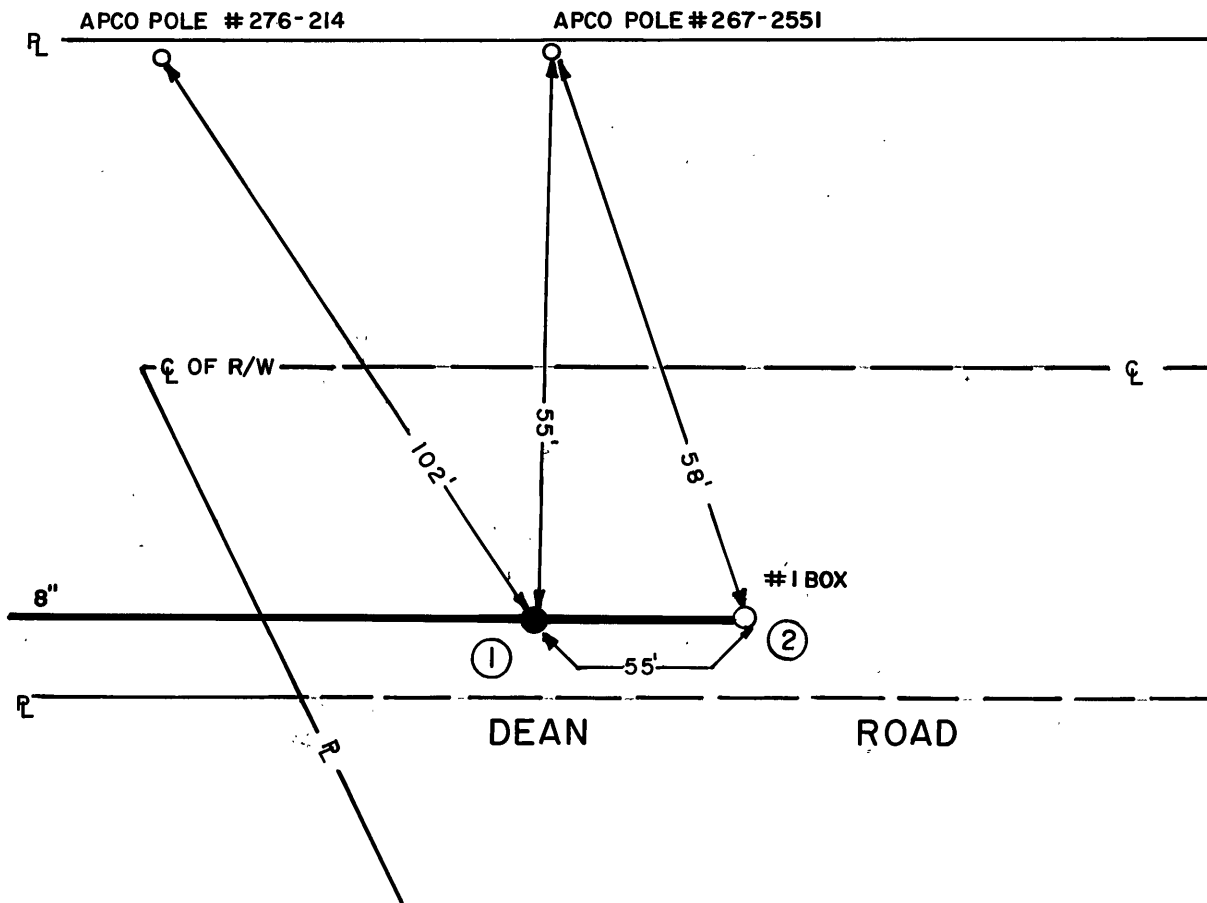
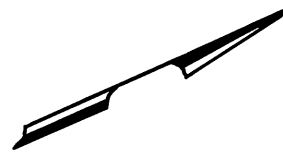


1625

[illegible]

7/93 NP

**CITY OF ROANOKE - WATER DEP'T.**

## VALVE DIAGRAM

1625 DEAN ROAD

SEC. MAP 512

**S.W.**

DATE:

**PAGE NO. .**