


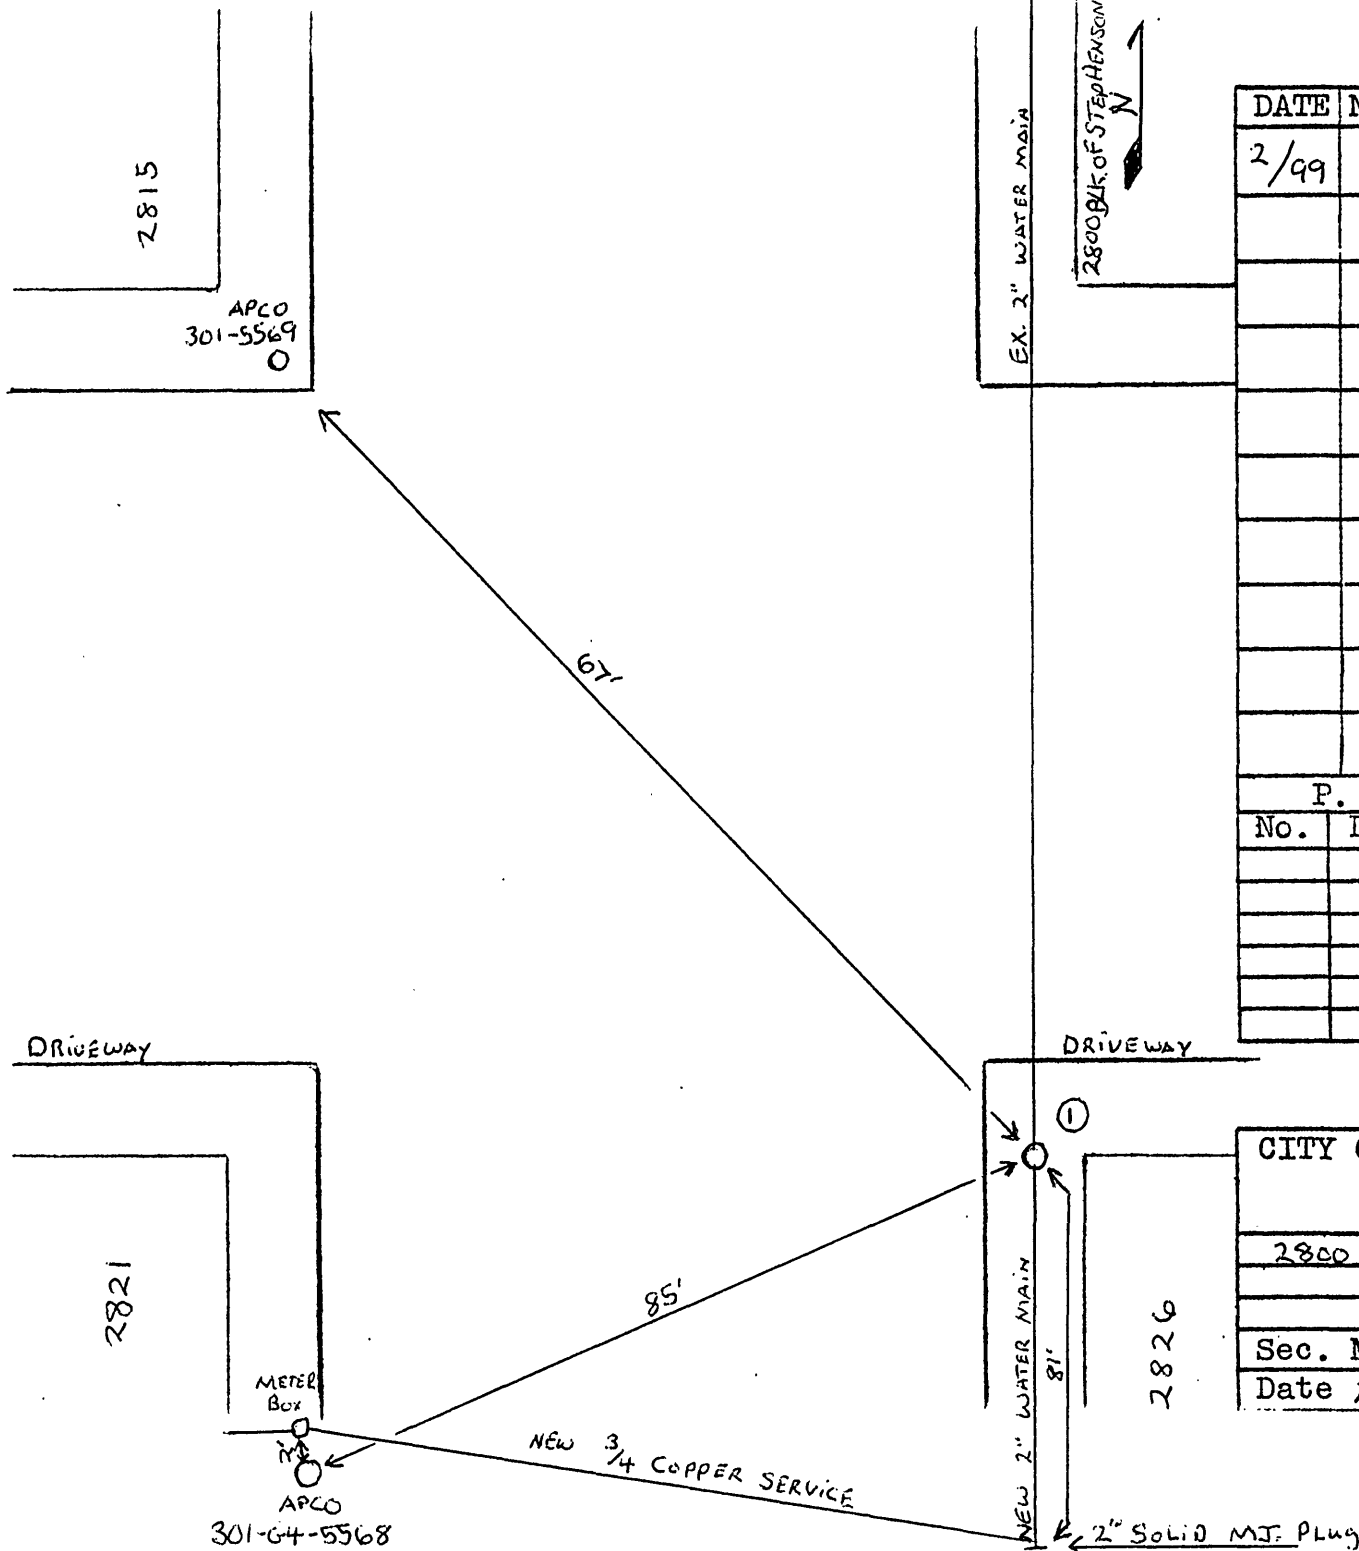

DATE	NO.	SIZE	MAKE	OPEN	TURNS
2/99	1	2"	MULL	R	5

P. L. Measurements		
No.	Distance	Direction

CITY OF ROANOKE - WATER DEPT.	
VALVE DIAGRAM	
2800 Block of STEPHENSON AVE SW.	
Sec. Map 106	
Date 2-5-99	Page No.