


CARTER
ROAD

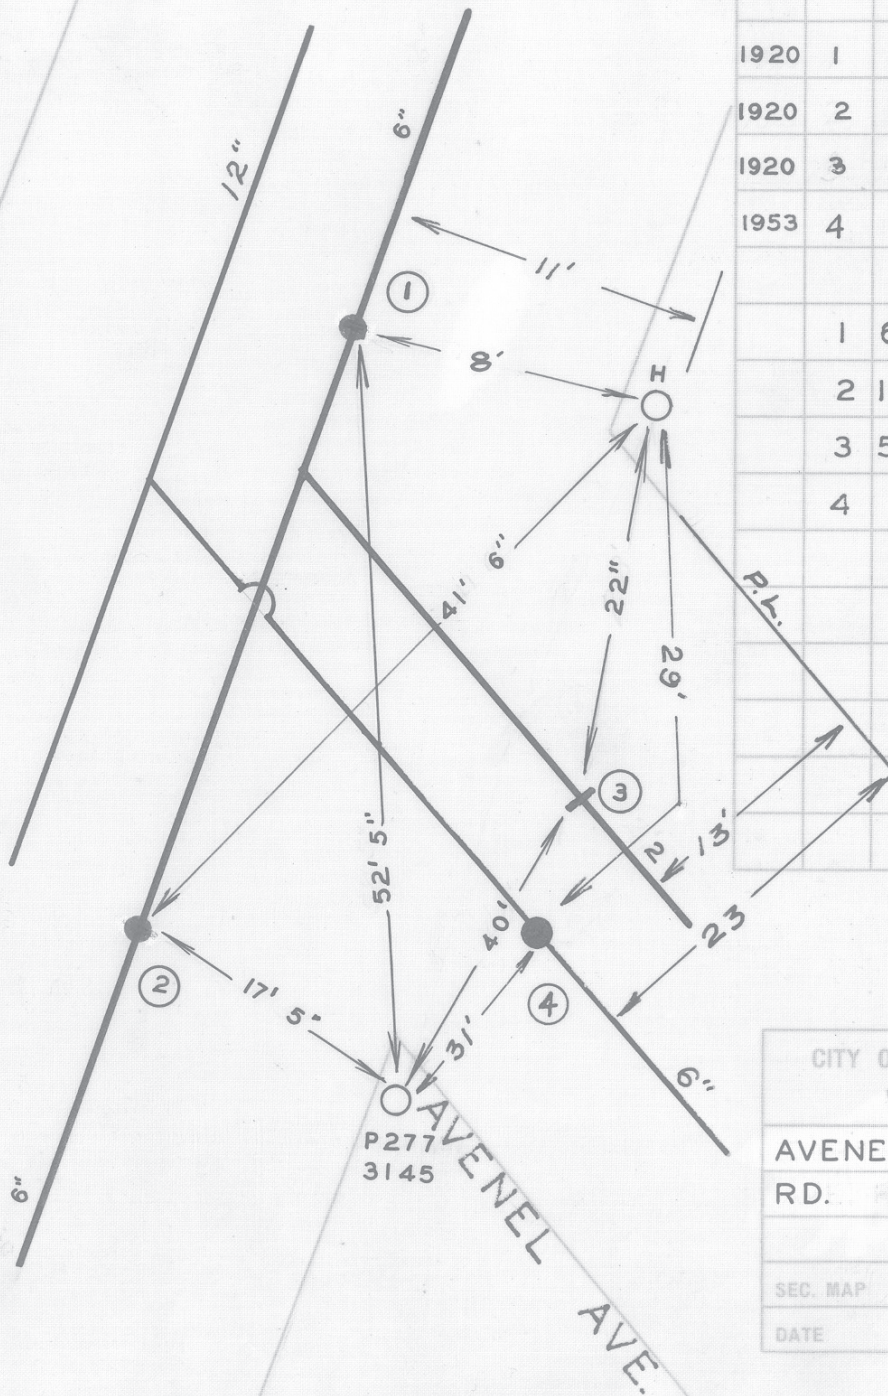

DATE	NO.	SIZE	MAKE	OPEN	TURNS
1920	1	6"		R	20 1/2
1920	2	6"		R	20 1/2
1920	3	2"		R	7
1953	4	6"			
1 6'-S NPL					
2 16'-N SPL					
3 5'-E EPL					
4 0 EPL					

CITY OF ROANOKE—WATER DEPT
VALVE DIAGRAM

AVENEL AVE. & CARTER
RD. S.W.

SEC. MAP 154

DATE

PAGE NO. S.W.446

10/22/42 JHW
CEH