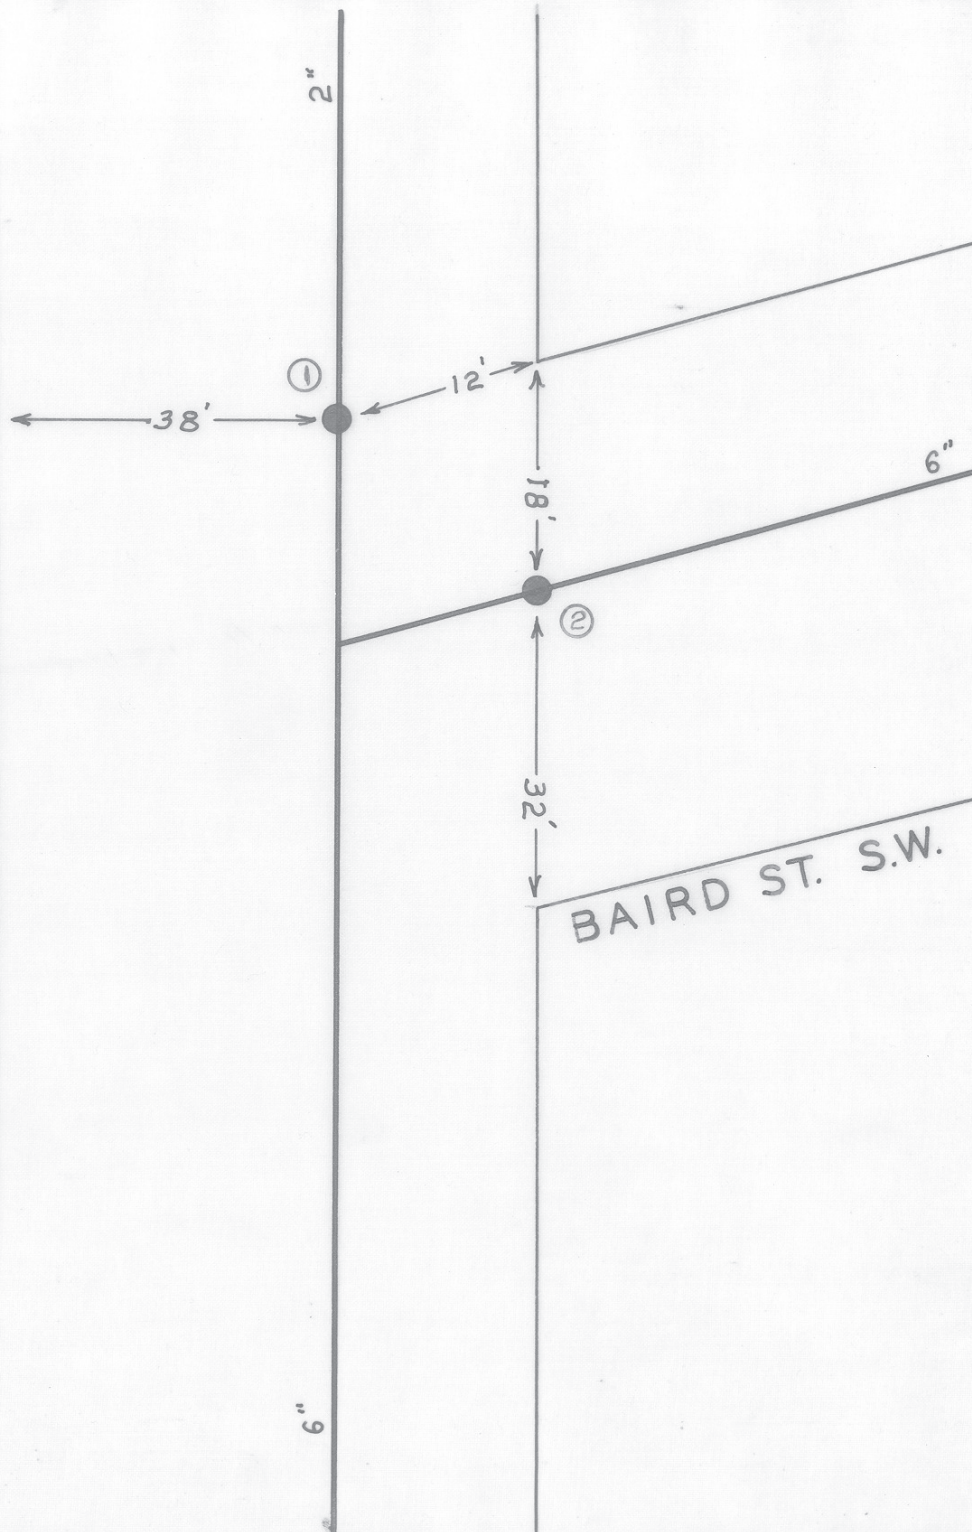


MALVERN ROAD

[illegible]

CITY OF ROANOKE—WATER DEPT.  
VALVE DIAGRAM

BAIRD STREET &  
MALVERN ROAD S.W.

SEC. MAP 161

DATE \_\_\_\_\_

PAGE NO.