


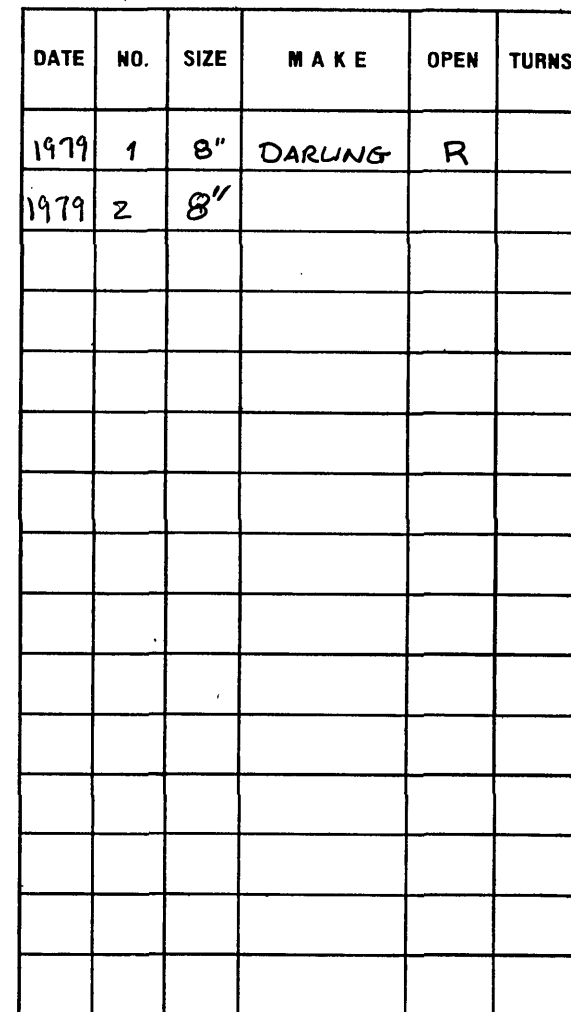

PAGE NO.