


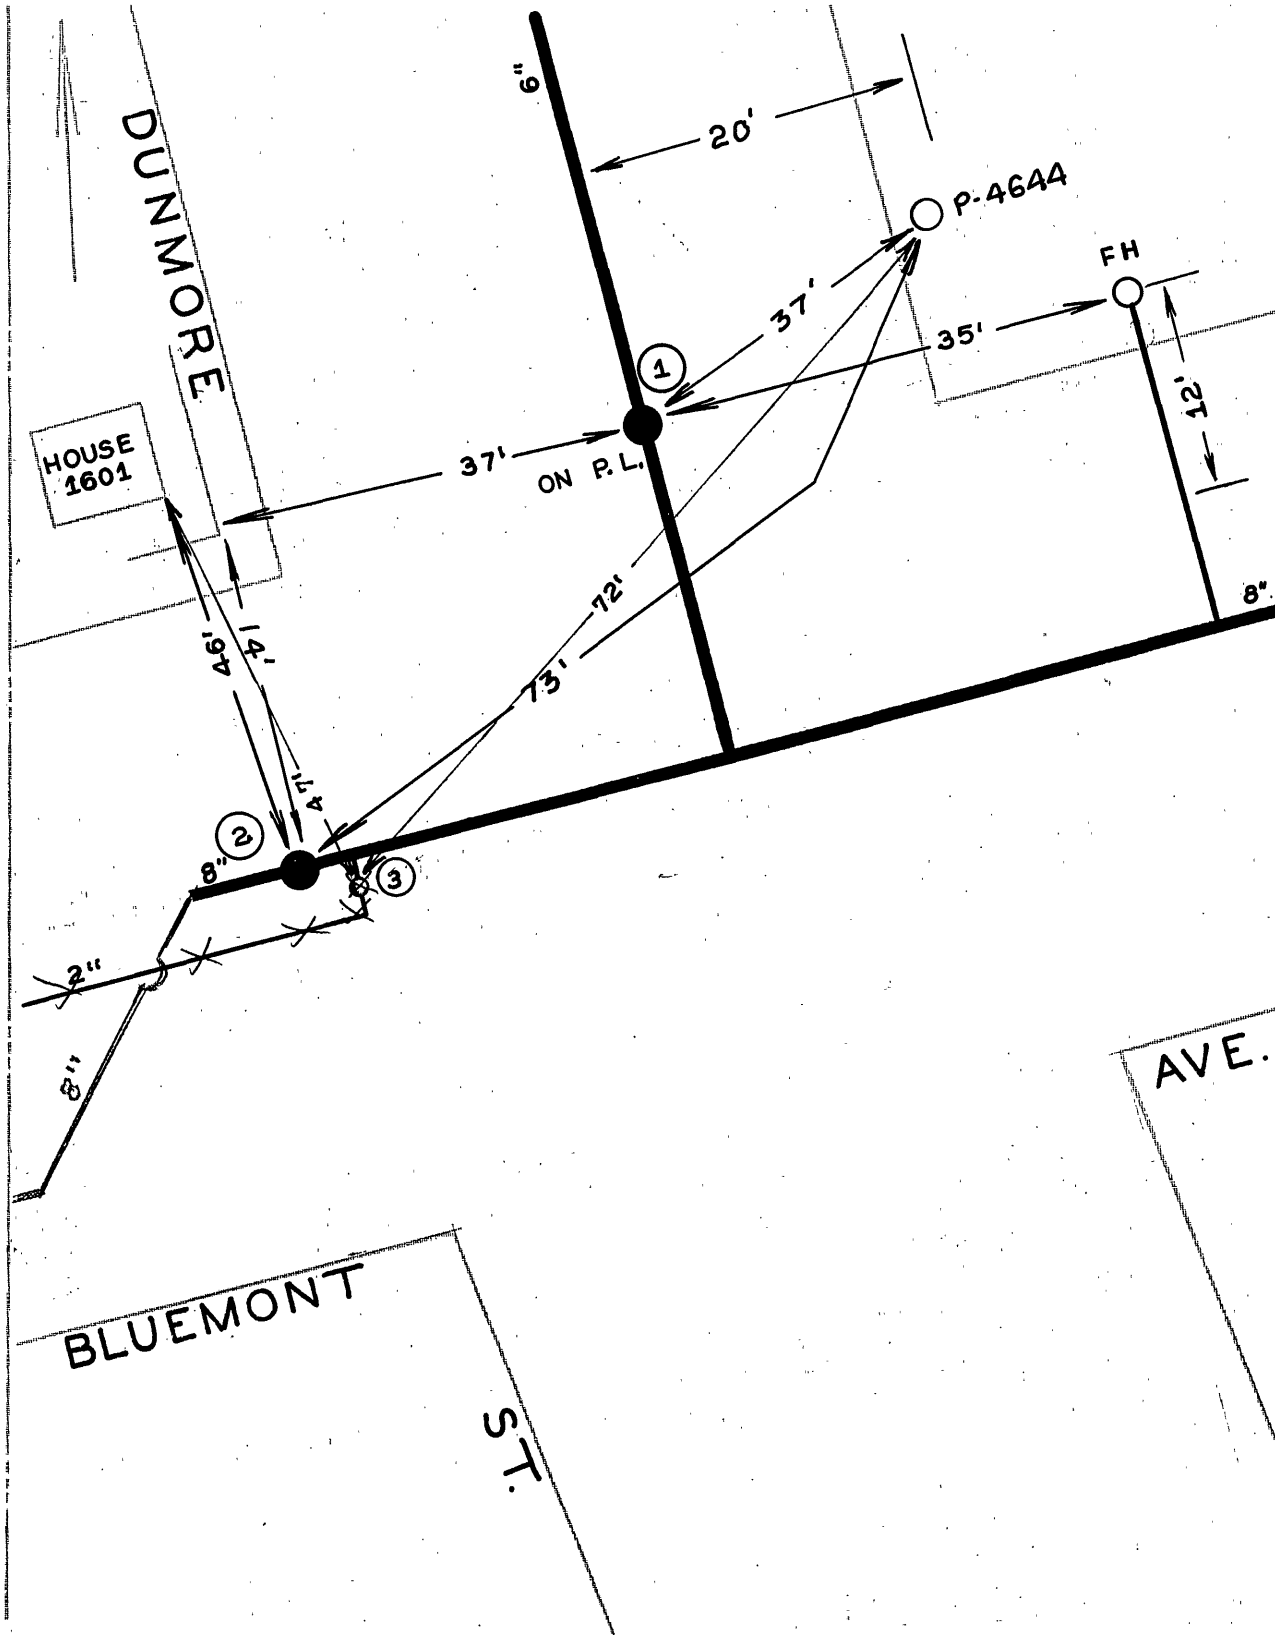

DATE	NO.	SIZE	MAKE	OPEN	TURNS
1950	1	6"	DARLING	R	20
1950	2	8"	DARLING	R	27
8-63	3	2"	GRANE	L	8½

CITY OF DOANOK—WATER DEPT	
VALVE DIAGRAM	
BLUEMONT AVENUE &	
DUNMORE STREET S.W.	
SEC. MAP 123	
DATE	PAGE NO. SW593