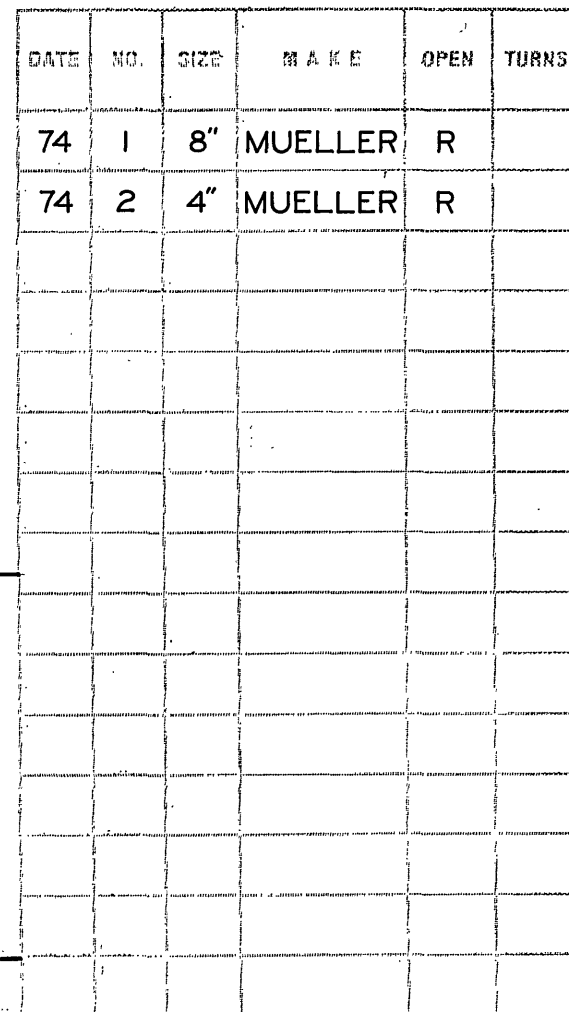



$$\begin{array}{c} \text{C}_{60}\text{H}_2 \\ \text{C}_{60}\text{H}_2 \\ \text{C}_{60}\text{H}_2 \end{array} \quad \begin{array}{c} \text{C}_{60}\text{H}_2 \\ \text{C}_{60}\text{H}_2 \\ \text{C}_{60}\text{H}_2 \end{array}$$