


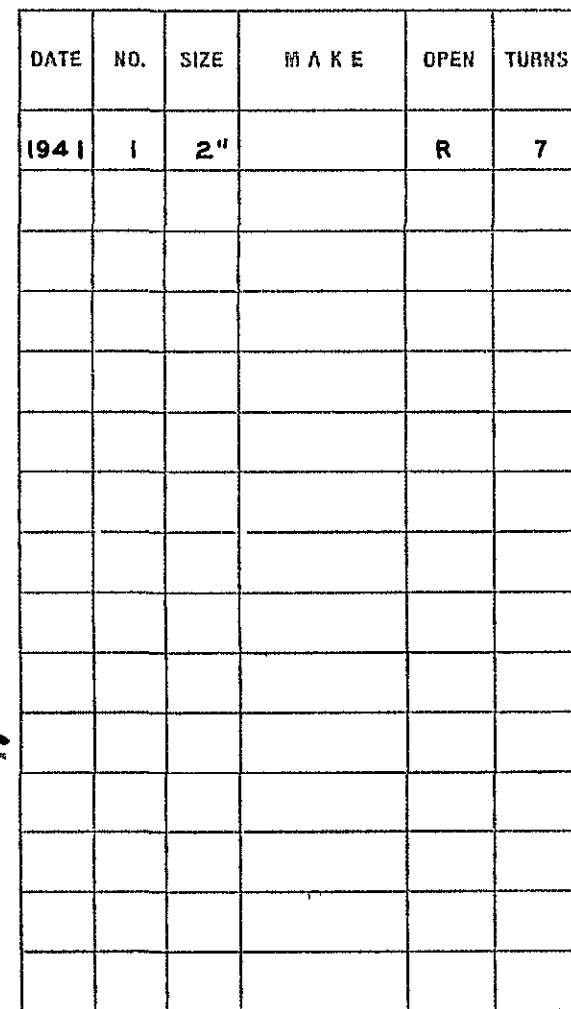

10/7/42 - J.H.I.V.
12/29/42 C.E.H