


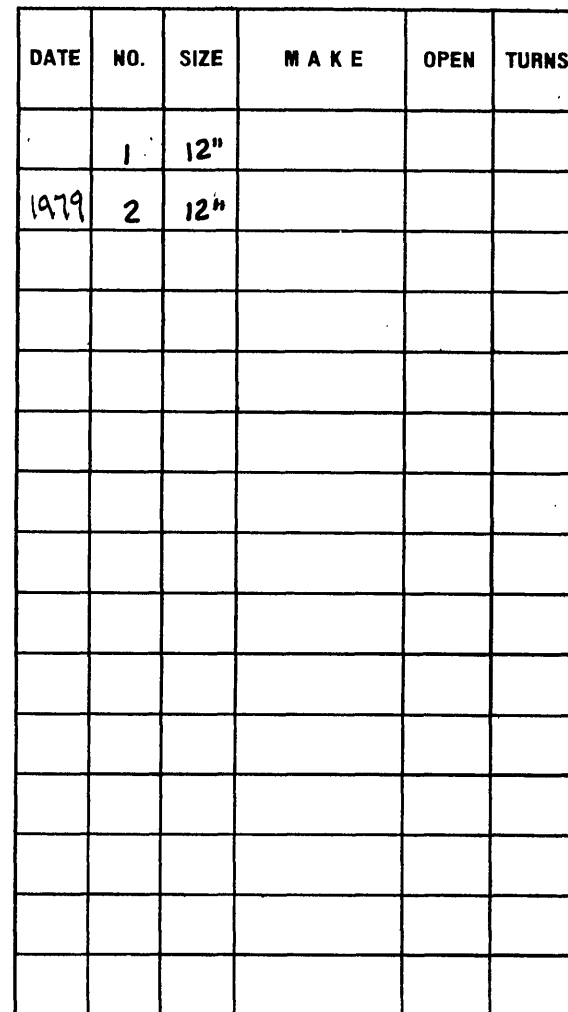

PAGE NO.

GARST MILL RD.