


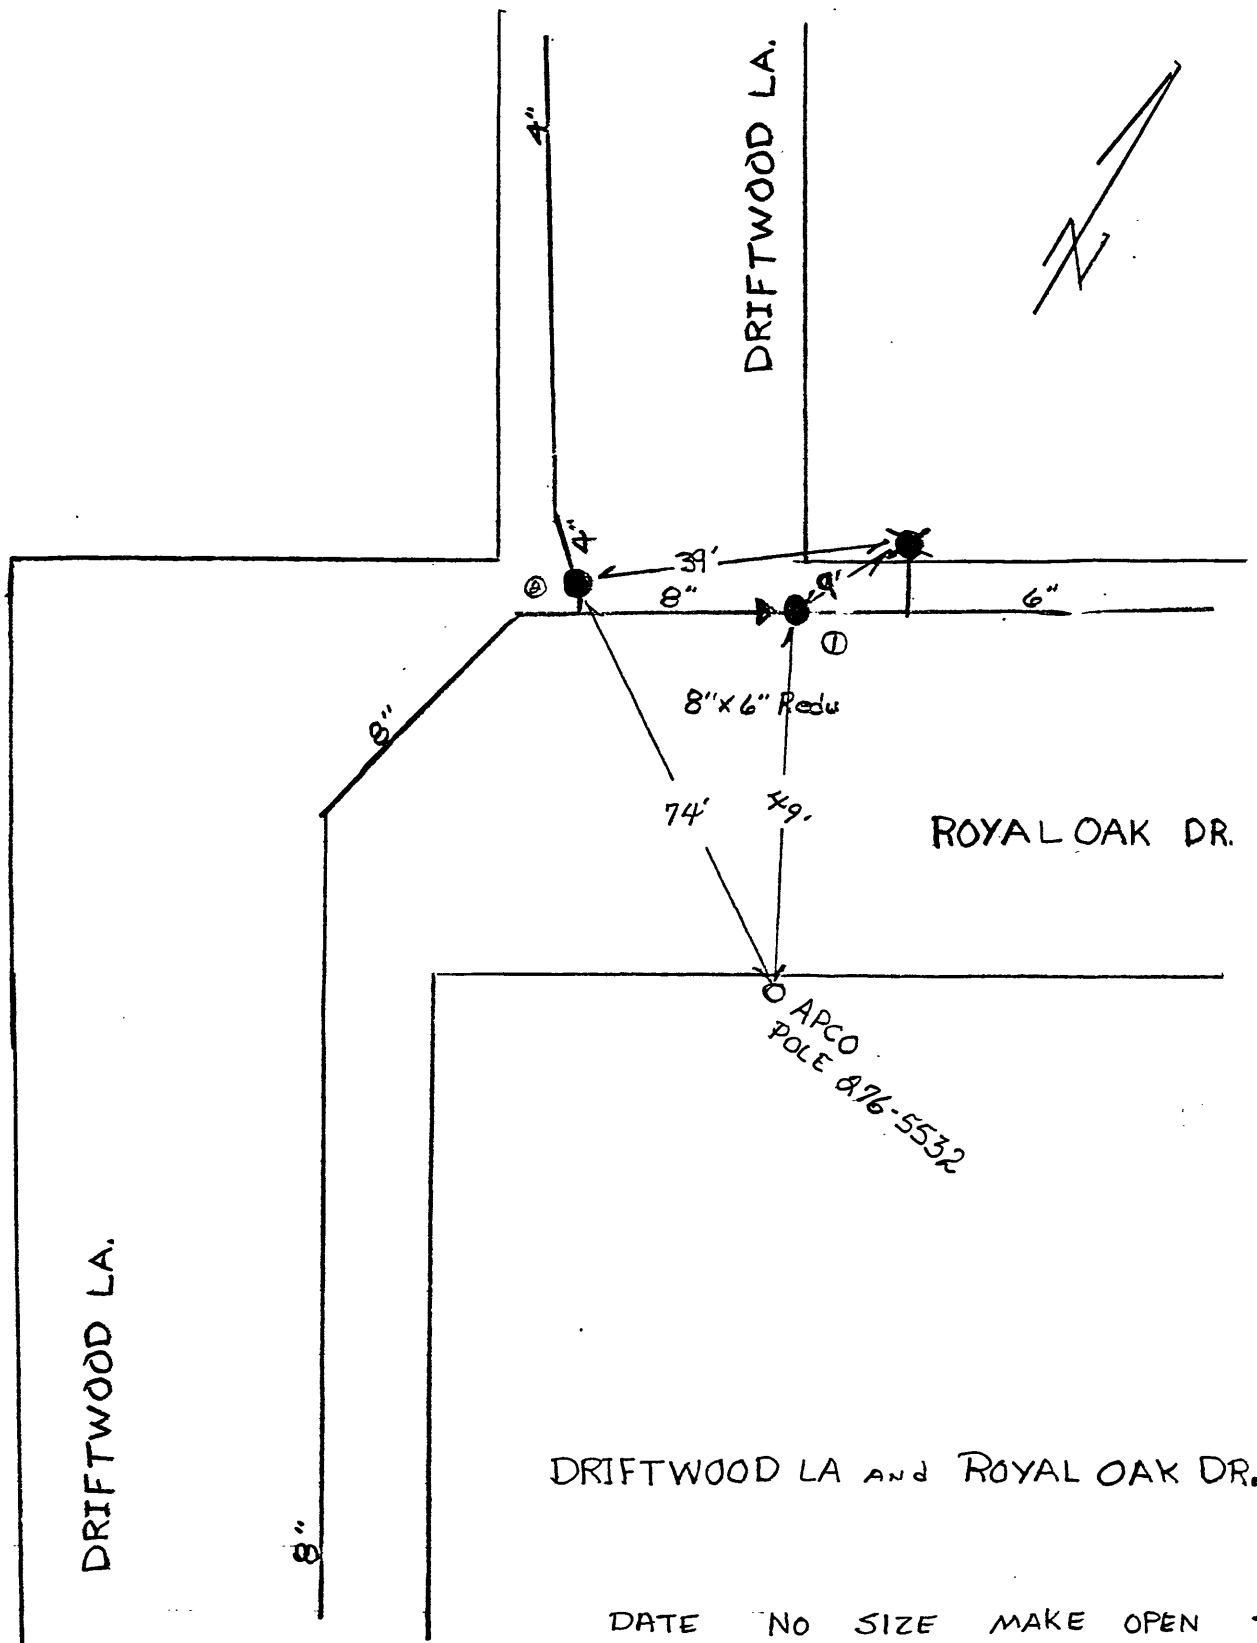

DRIFTWOOD LA AND ROYAL OAK DR. S.W.

DATE	NO	SIZE	MAKE	OPEN	TURNS
3-92	1	6"	DARL.	R	21
3-92	2	4"	Muel.	R	15