


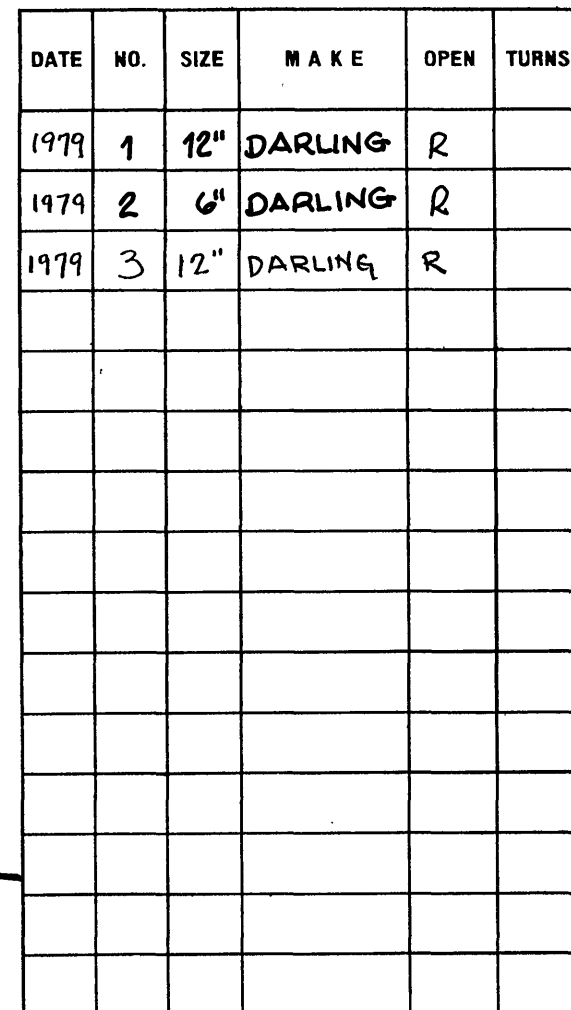

PAGE NO.

SEC. MAP 501