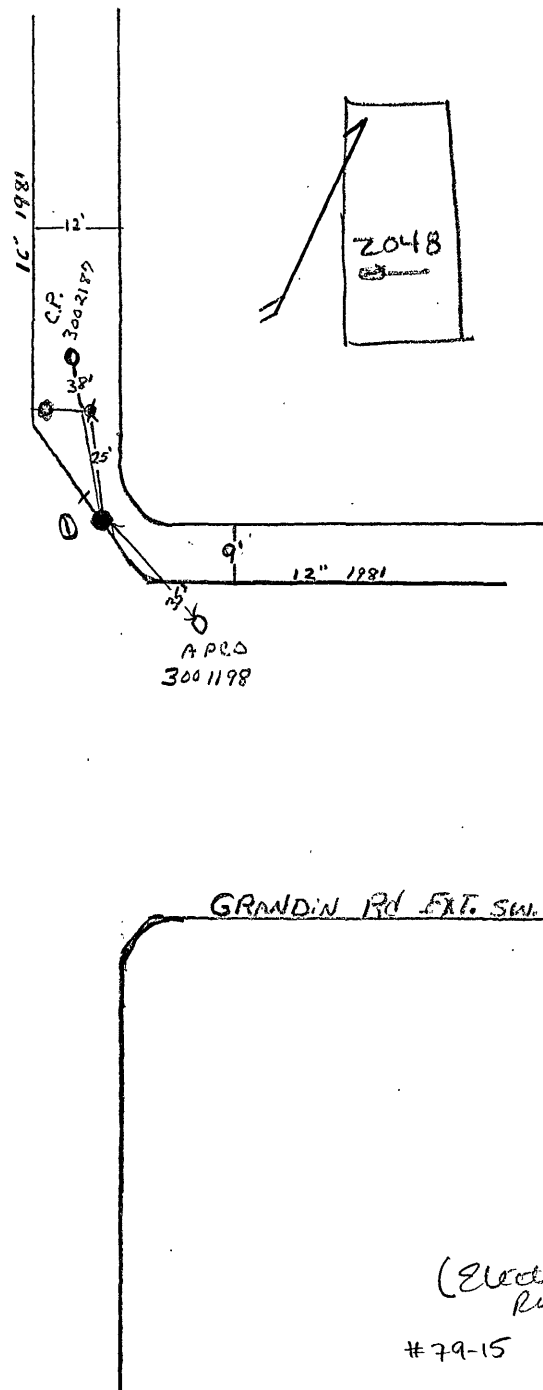


STATE RT. 419 - Electric Rd.

[illegible]

(Electric)

#79-15

CITY OF ROANOKE—WATER DEPT	
VALVE DIAGRAM	
419 1/2 Grandin Rd EXT.	
SEC. MAP 509	SW
DATE 8-81	PAGE NO.