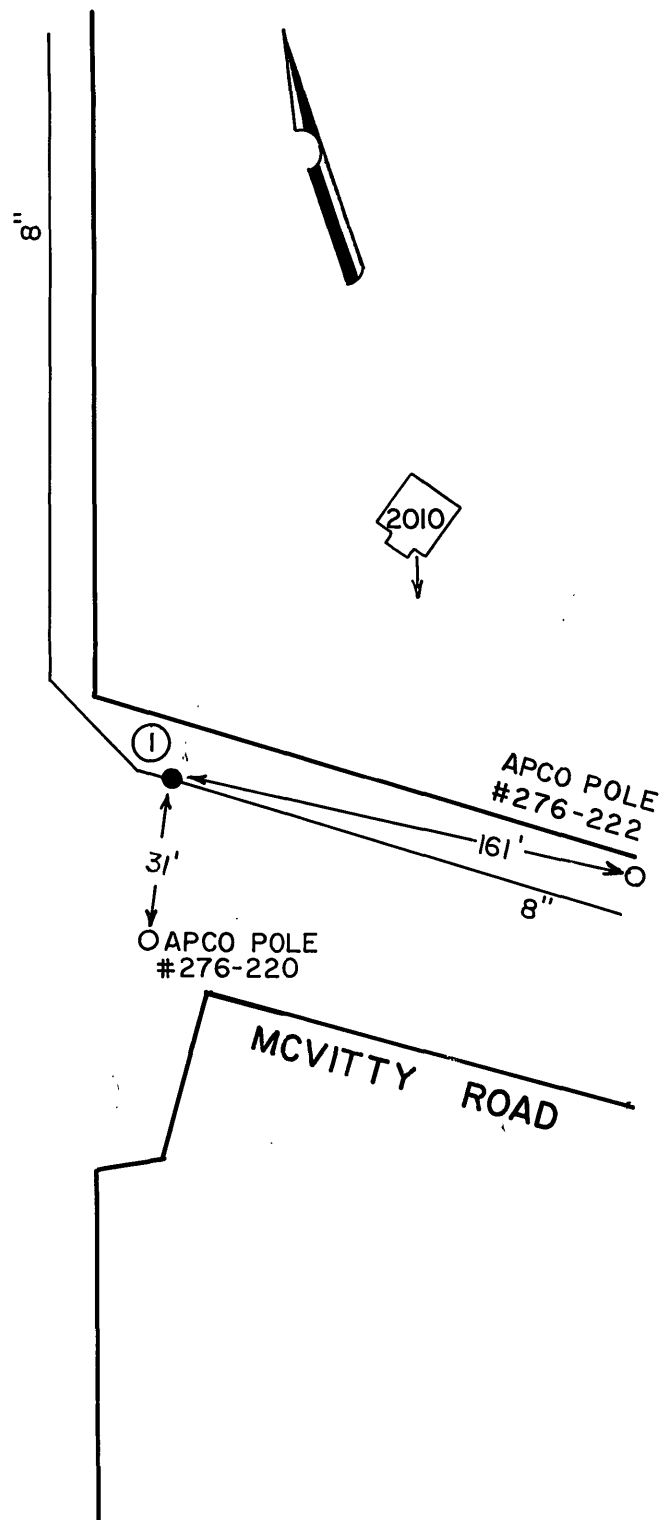


ELECTRIC ROAD

1/2001 JH

[illegible]

CITY OF ROANOKE - WATER DEP'T.

VALVE DIAGRAM

**ELECTRIC ROAD (RT. 419) &
MCVITTY ROAD**

SEC. MAP 510

S.W.

DATE:

PAGE NO.