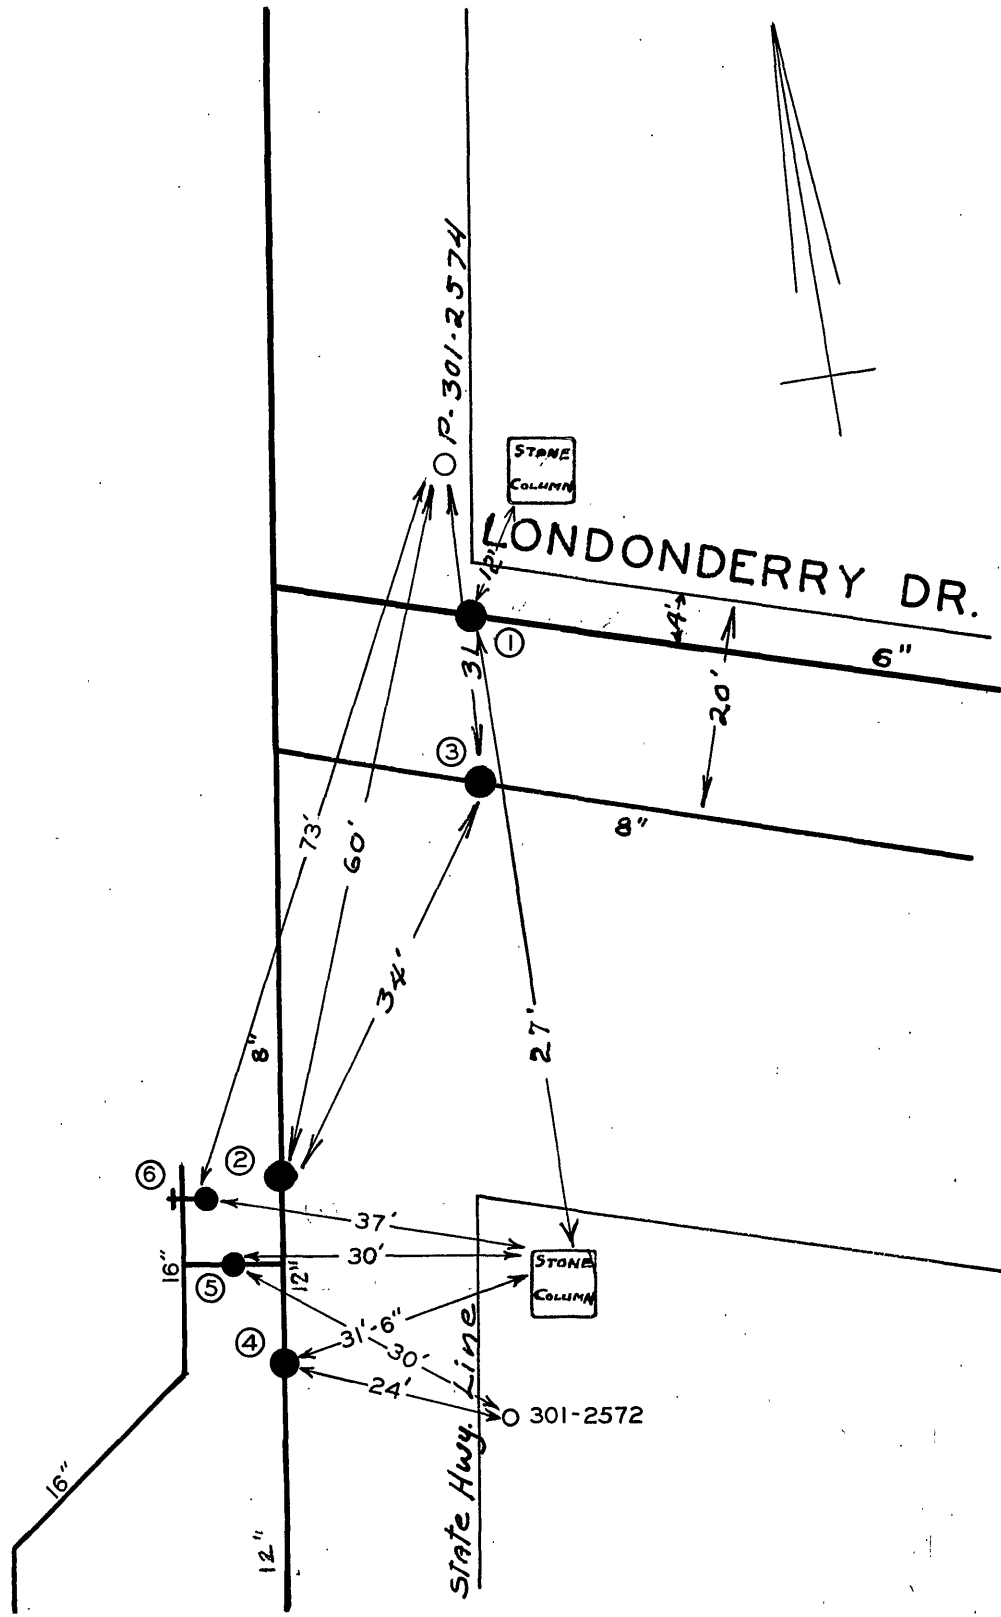


FRANKLIN ROAD

[illegible]

CITY OF ROANOKE - WATER DEPT.
VALVE DIAGRAM
FRANKLIN RD. &
LONDONDERRY DR. S.W.
SEC. MAP 35 & 117, 11D
DATE PAGE NO.