




## CONCRETE BRIDGE RAIL

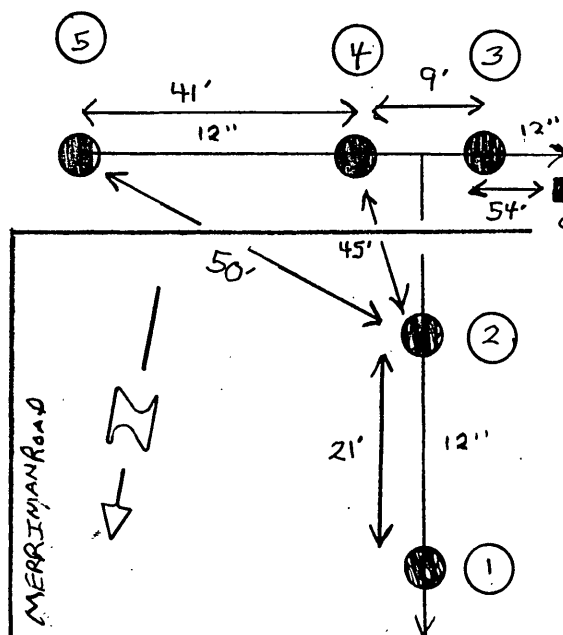

DATE 11-17-06