


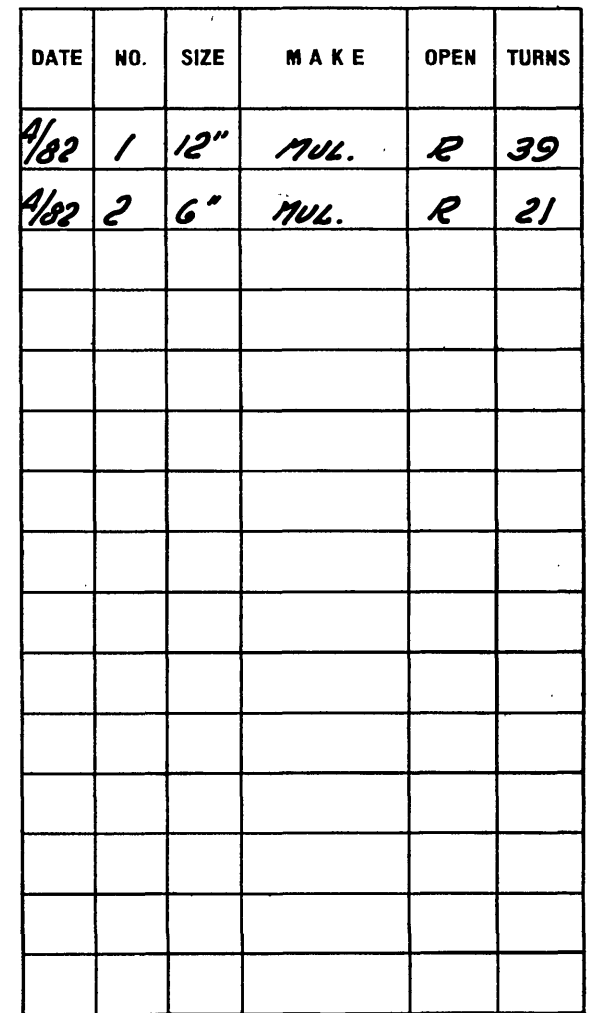

DATE **6-26-85** PAGE NO. **1**