


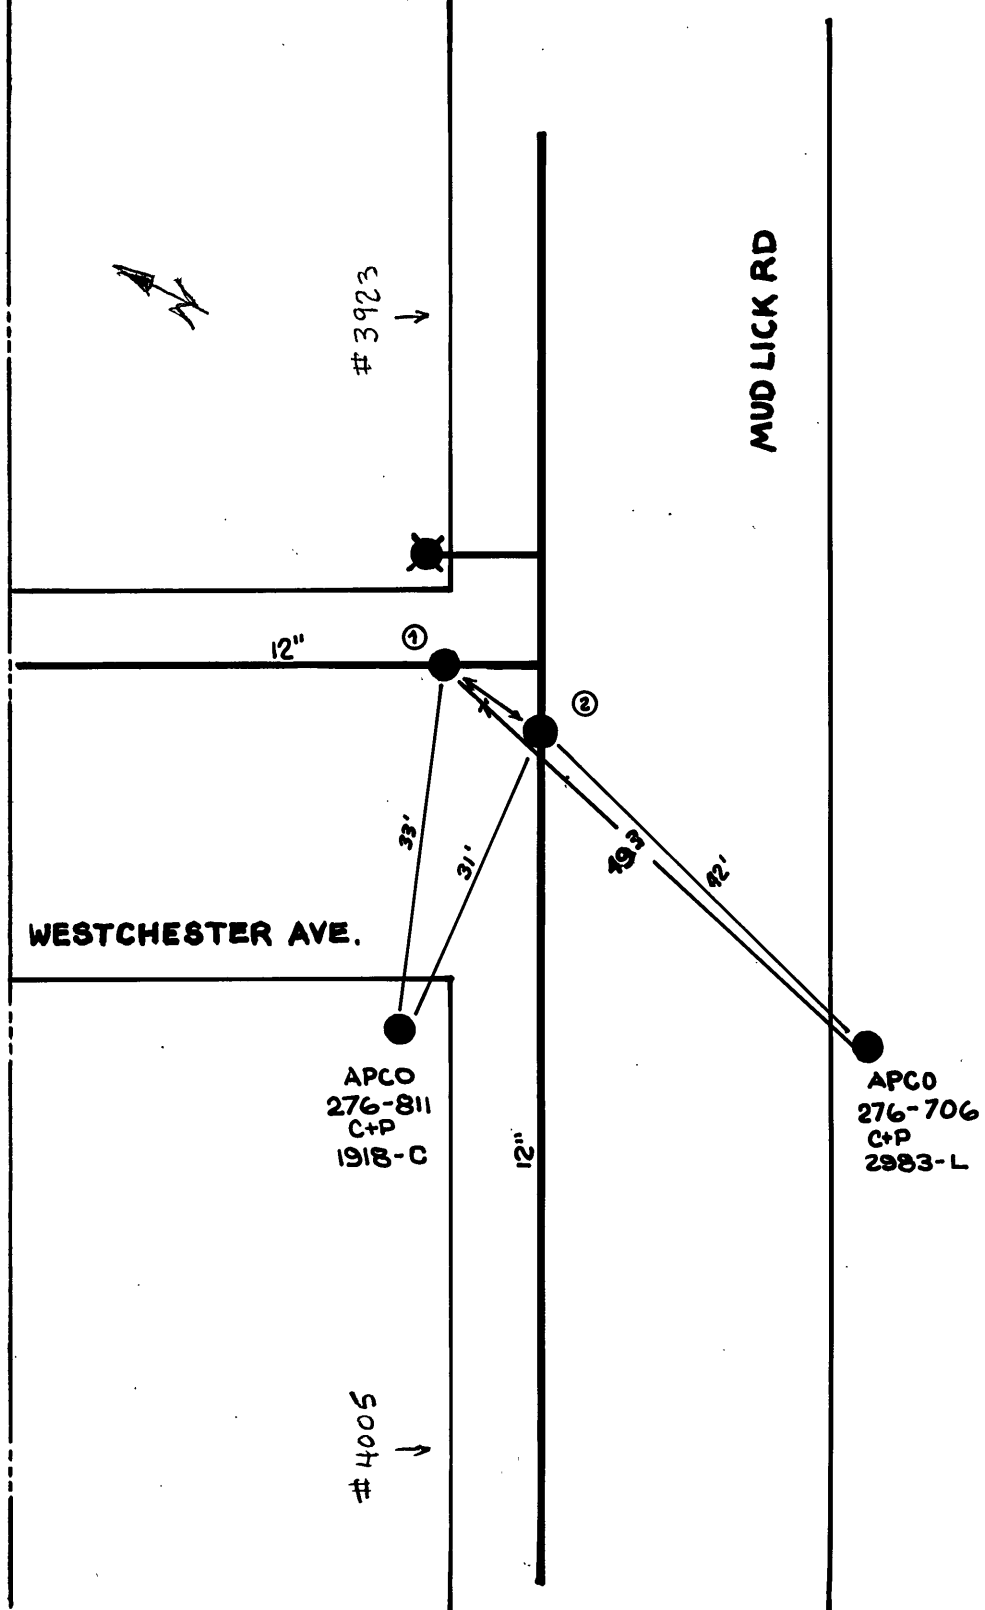

DATE	NO.	SIZE	MAKE	OPEN	TURNS
1979	1	12"	DARLING	R	38
1979	2	12"	DARLING	R	38

CITY OF ROANOKE—WATER DEP'T VALVE DIAGRAM	
MUD LICK RD. AND WESTCHESTER AVE SW	
SEC. MAP 506	
DATE 7/14/80	PAGE NO.