


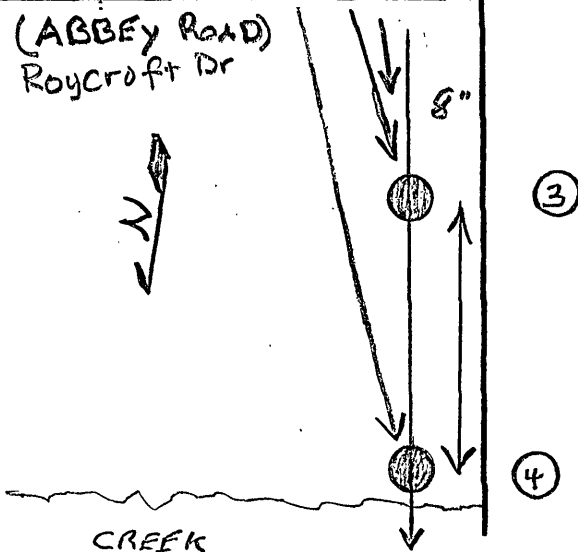

Two Ford Road

Abbey is now called
Roycroft Dr

WESTERN VIRGINIA WATER AUTHORITY

VALVE DIAGRAM

ABBEY ROAD AND TWO FORD ROAD

Roycroft Dr And Two Ford Rd

6-8-06 SW County