


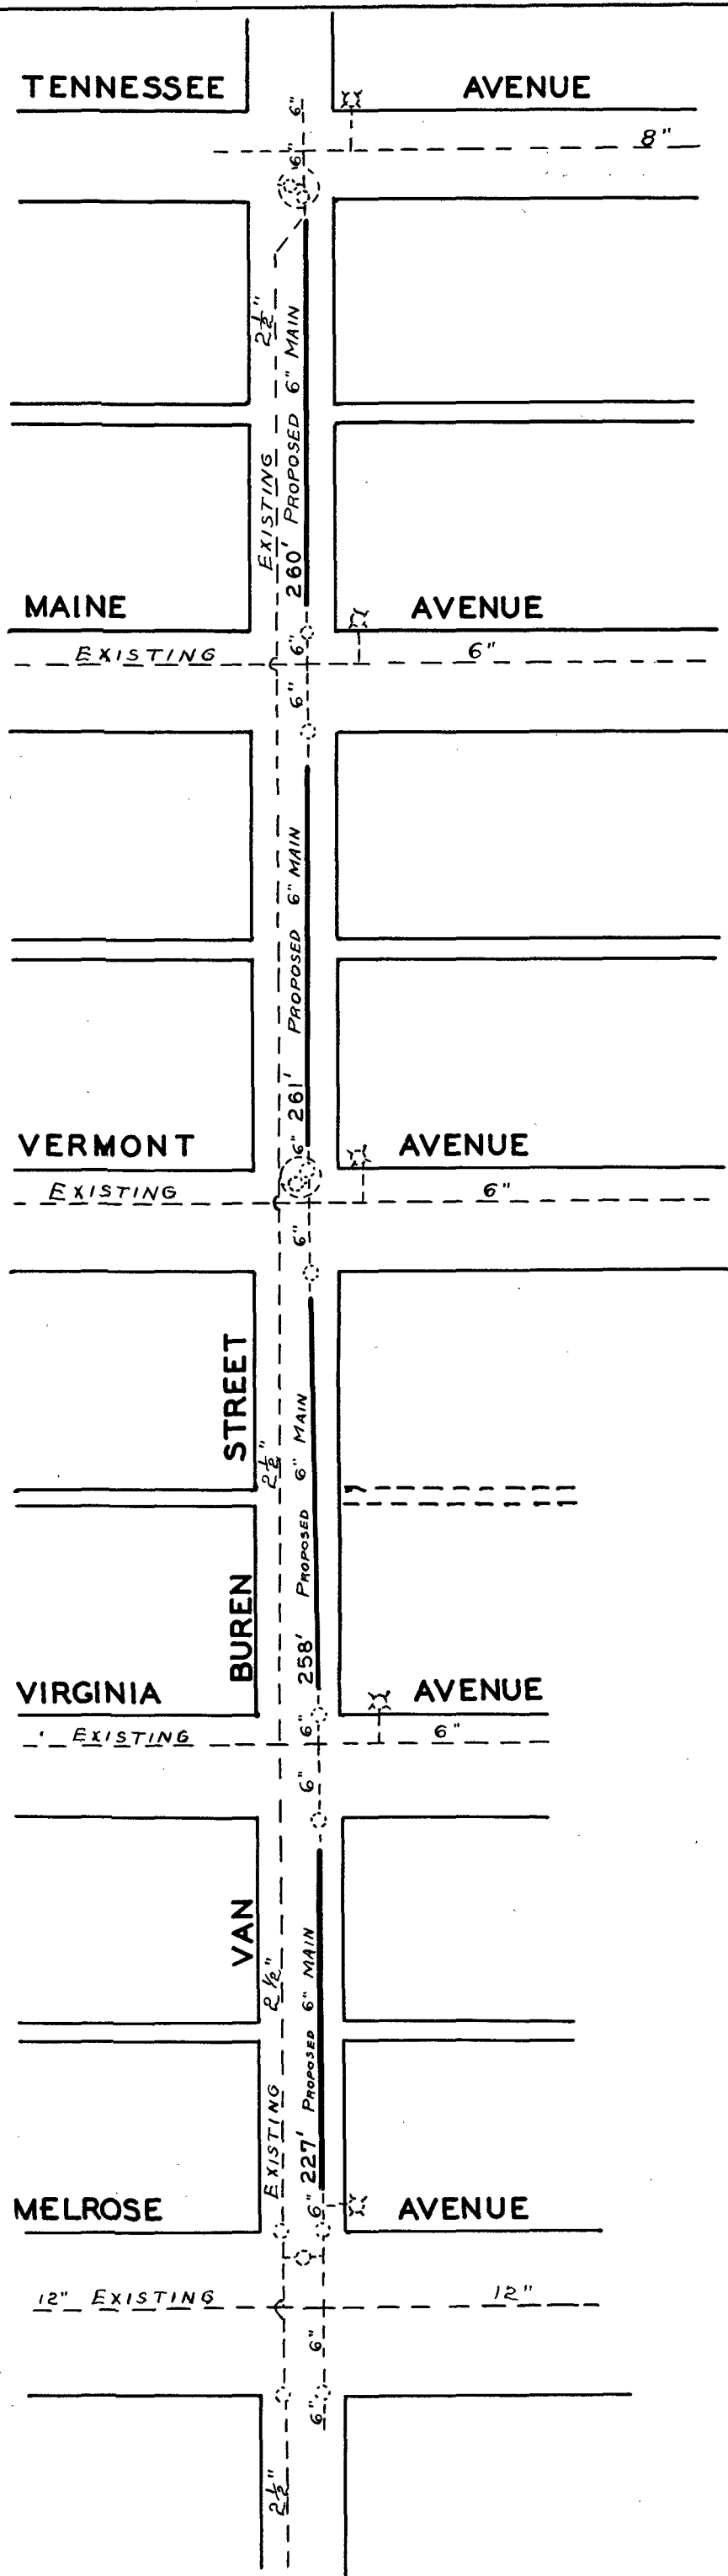

|                            |      |       |       |     |
|----------------------------|------|-------|-------|-----|
| DATE STARTED FEB. 20, 1962 |      |       |       |     |
| DATE COMP. MAR. 2, 1962    |      |       |       |     |
| FEET MAIN                  | SIZE | VALVE | VAULT | BOX |
| 1006'                      | 6"   |       |       |     |
|                            |      |       |       |     |
|                            |      |       |       |     |
| F. H. COMP.                |      |       |       |     |
| F. H. STUB ONLY            |      |       |       |     |
| SERV. INS. BY:             |      |       |       |     |
| MAINS INS. BY: B.R.H.      |      |       |       |     |
| NO. 3/4" SERV. INS.        |      |       |       |     |
| CITY OR CO. CITY           |      |       |       |     |
| DEPT. INSP.                |      |       |       |     |

WATER DEPARTMENT  
CITY OF ROANOKE, VA.  
VAN BUREN STREET

SCALE - 1"=100'  
DRAWN BY E.L.A. FEB., 16 1962