


DATE STARTED	4-2-97
DATE COMP	6-25-97
FEET MARK	12
SIZE	12
VALVE WALL	12
RC	12
F.H. COMP	8.3
F.H. STUD	6
ONLY	6
SERV. INS. BY	
MAIN INS. BY	
LOC. BY SERV. INS.	
CITY OR CO.	
DEPT. INSP	

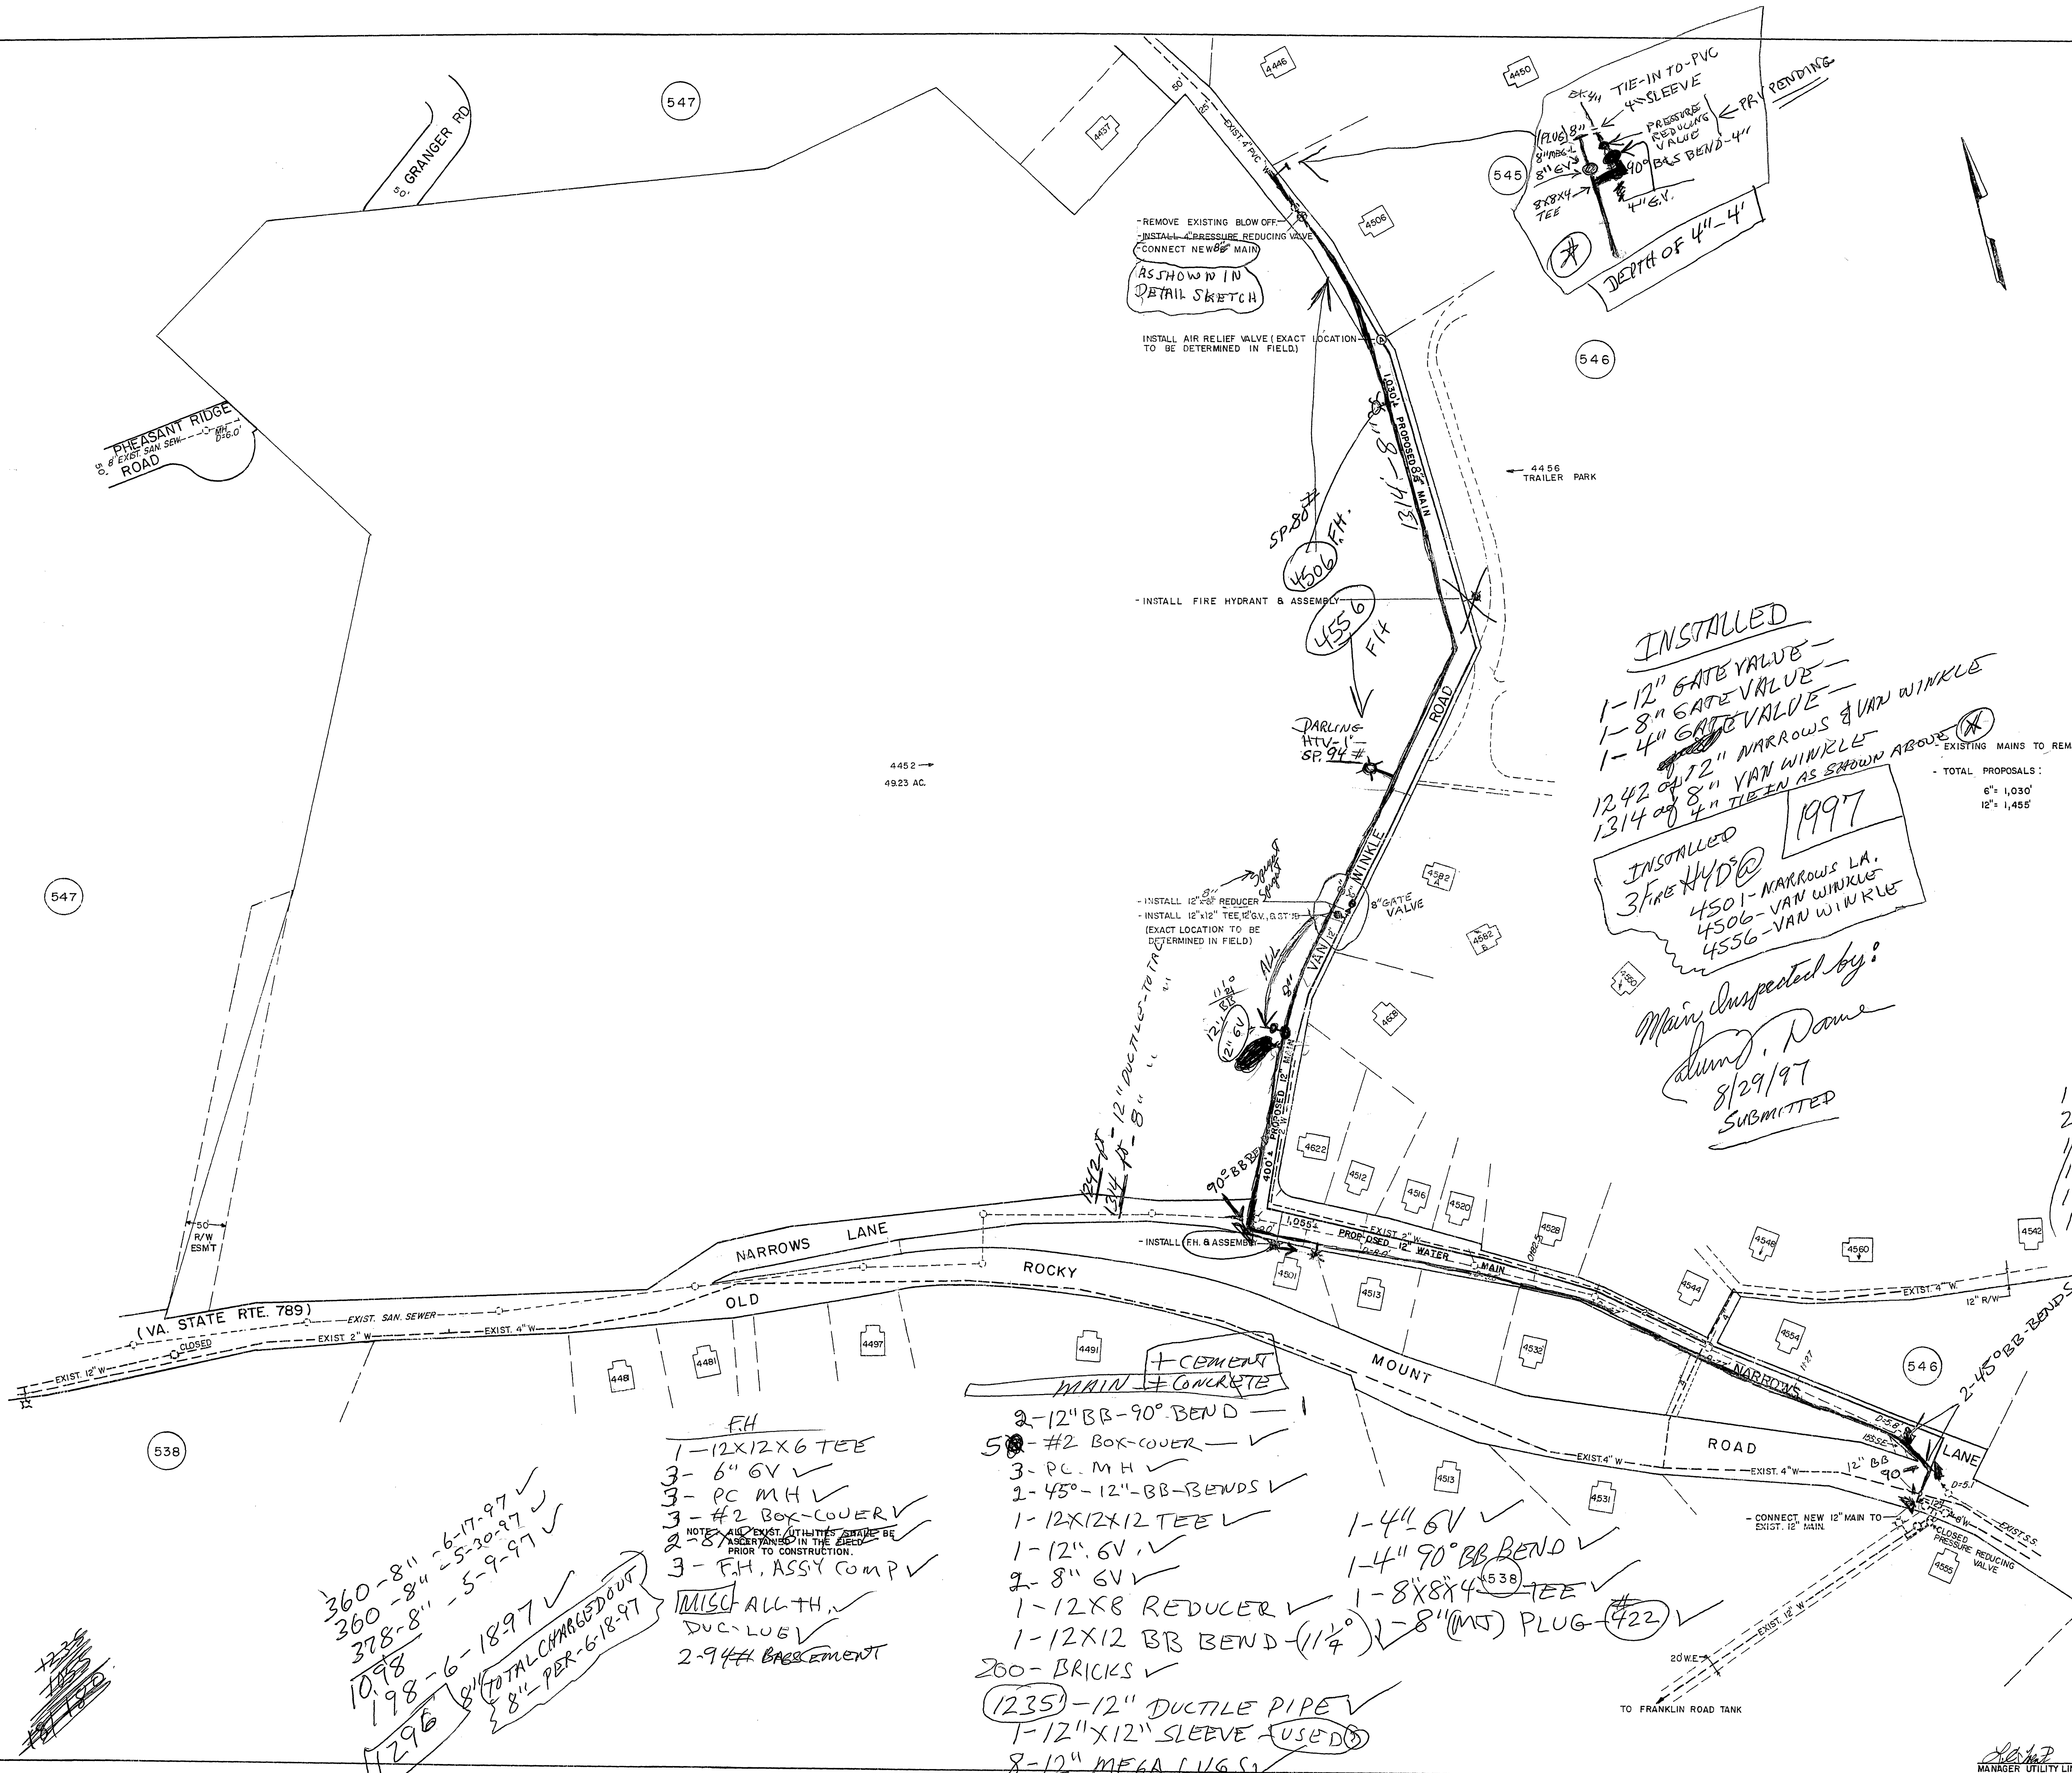

INSTALLED
 1-12" GATE VALVE
 1-8" GATE VALVE
 1-4" GATE VALVE
 1242 12" NARROWS VAN WINKLE
 1314 8" VAN WINKLE
 1314 4" TIE-IN AS SHOWN ABOVE

INSTALLED 1997
 3 FIRE HYD@
 4501-NARROWS LA.
 4506-VAN WINKLE
 4556-VAN WINKLE

Main Inspected by:
 [Signature]
 8/29/97
 SUBMITTED

EXISTING MAINS TO REMAIN (NO ABANDONMENTS)
 TOTAL PROPOSALS:
 6" 1,030'
 12" 1,455'

1-90° 12" BENDS - BB
 2-45° 12" BENDS - BB
 1-90° 12" BEND - BB
 1-12X12X12 TEE
 1-12X12X8 TEE - FH
 1-12X8 REDUCER

FH
 1-12X12X6 TEE
 3- 6" GV ✓
 3- PC M.H. ✓
 3- #2 BOX-COVER ✓
 3- #2 BOX-COVER ✓
 3- F.H. ASSY COMP ✓

MISC. ALL TH.
 DUC. LUG ✓
 2-9/4" CEMENT

MAIN + CONCRETE
 2-12" BR-90° BEND
 5- #2 BOX-COVER ✓
 3- PC M.H. ✓
 2-45° 12" BB-BENDS ✓
 1-12X12X12 TEE ✓
 1-12" 6V ✓
 2- 8" GV ✓
 1-12X8 REDUCER ✓
 1-12X12 BB BEND (1 1/4") ✓
 260- BRICKS ✓

1235-12" DUCTILE PIPE ✓
 1-12"X12" SLEEVE (USED) ✓
 8-12" MEGA LUGS ✓
 1-1 1/2" CORP STOP ✓
 (BAG) 4- CEMENT ✓

1-4" 6V ✓
 1-4" 90° BB BEND ✓
 1-8X8X4 TEE ✓
 1-8" (MT) PLUG (422) ✓

360-8" - 6-17-97 ✓
 360-8" - 5-30-97 ✓
 378-8" - 5-9-97 ✓
 1098-6-18-97 ✓
 198-6-18-97 ✓
 1296-8" TOTAL CHARGED OUT
 8" PER 6-18-97

WATER DEPARTMENT	
ROANOKE	VIRGINIA
NARROWS LANE	
OLD ROCKY MOUNT ROAD	
VAN WINKLE ROAD, SW.	
SCALE: 1"=100'	INCHES UTILITIES & OPERATIONS DATE
DATE: 9/30/96	DATE: 9/30/96
DIST. MAP: 530/545	DATE: 9/30/96
PLAN NO. 96-12	INCHES OF PUBLIC WORKS DATE

MANAGER UTILITY LINE SERVICES