



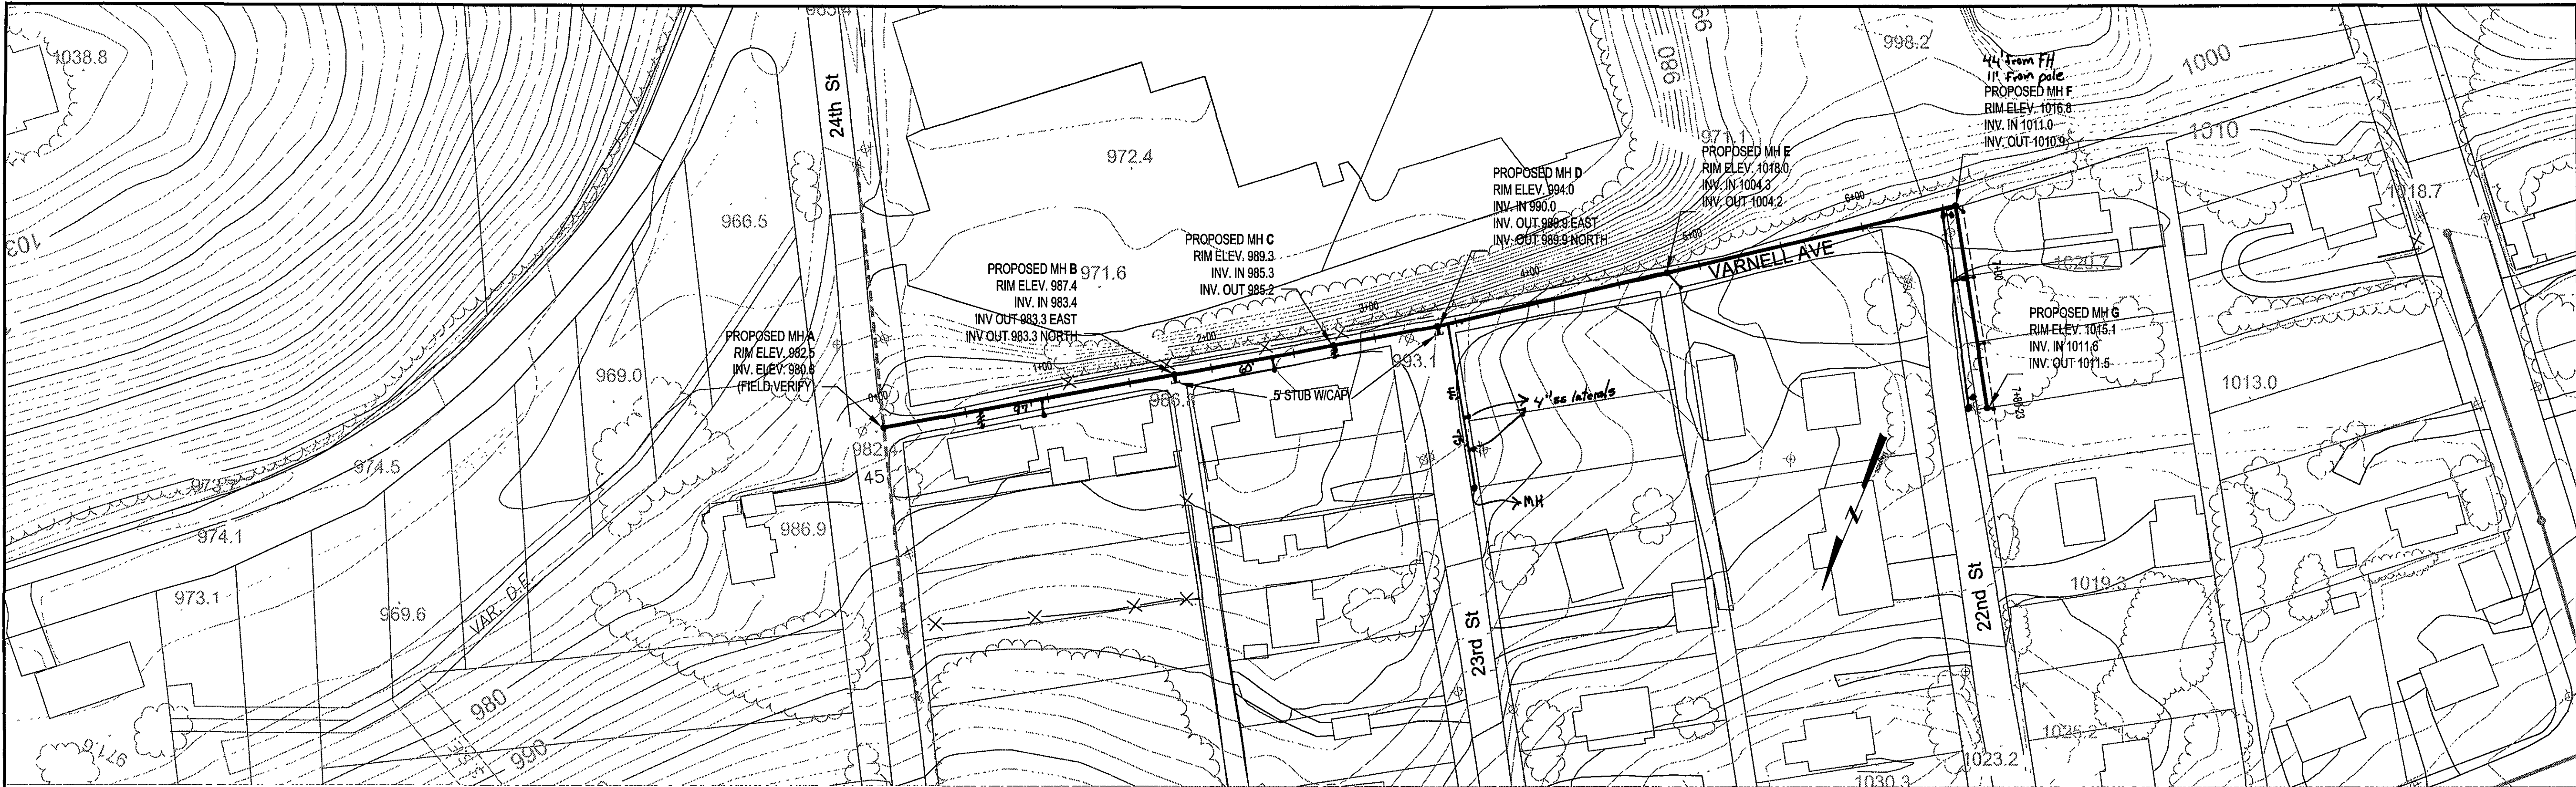


LEGEND

- EXISTING SANITARY SEWER
- PROPOSED SANITARY SEWER
- EXISTING SANITARY SEWER MANHOLE
- PROPOSED SANITARY SEWER MANHOLE
- PROPOSED SANITARY SEWER EASEMENT
- PROPERTY LINE
- EXISTING FENCELINE

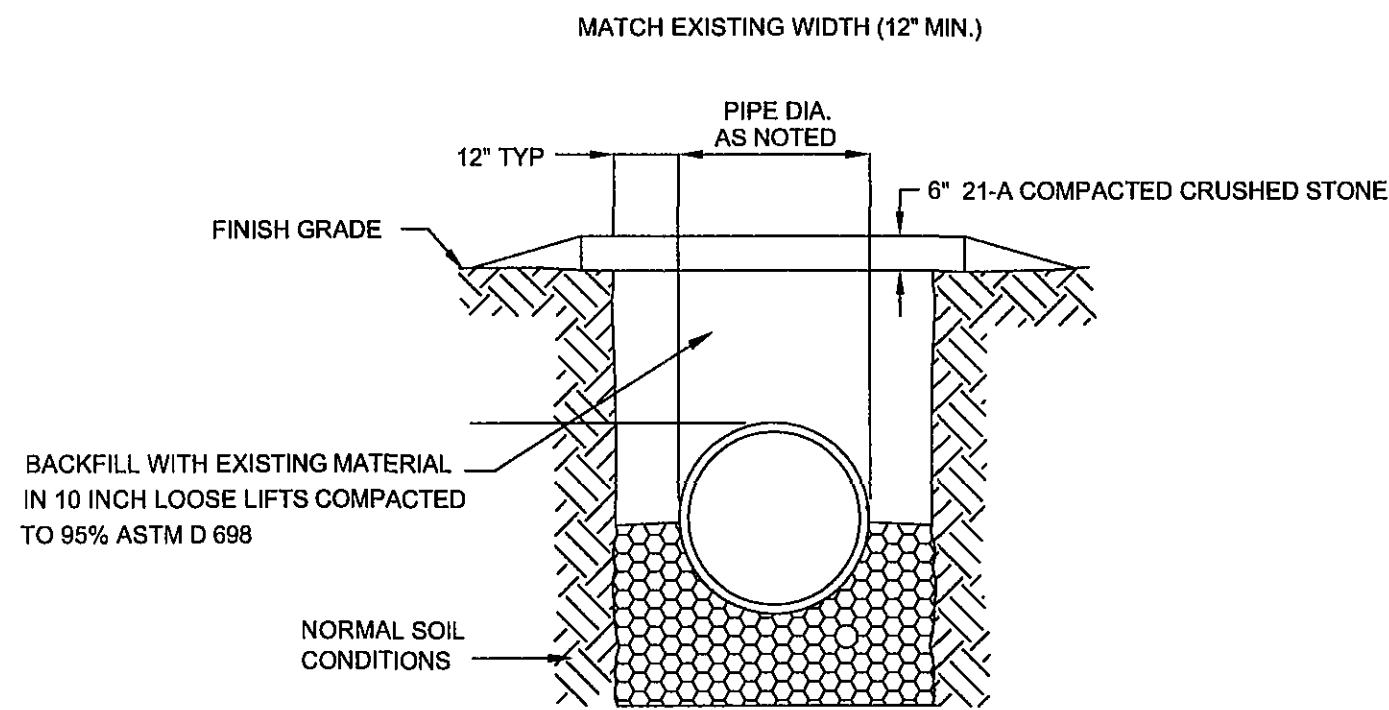


NOTES:
1. ALL WORK SHALL CONFORM TO WESTERN VIRGINIA WATER AUTHORITY DESIGN & CONSTRUCTION STANDARDS LATEST EDITION.

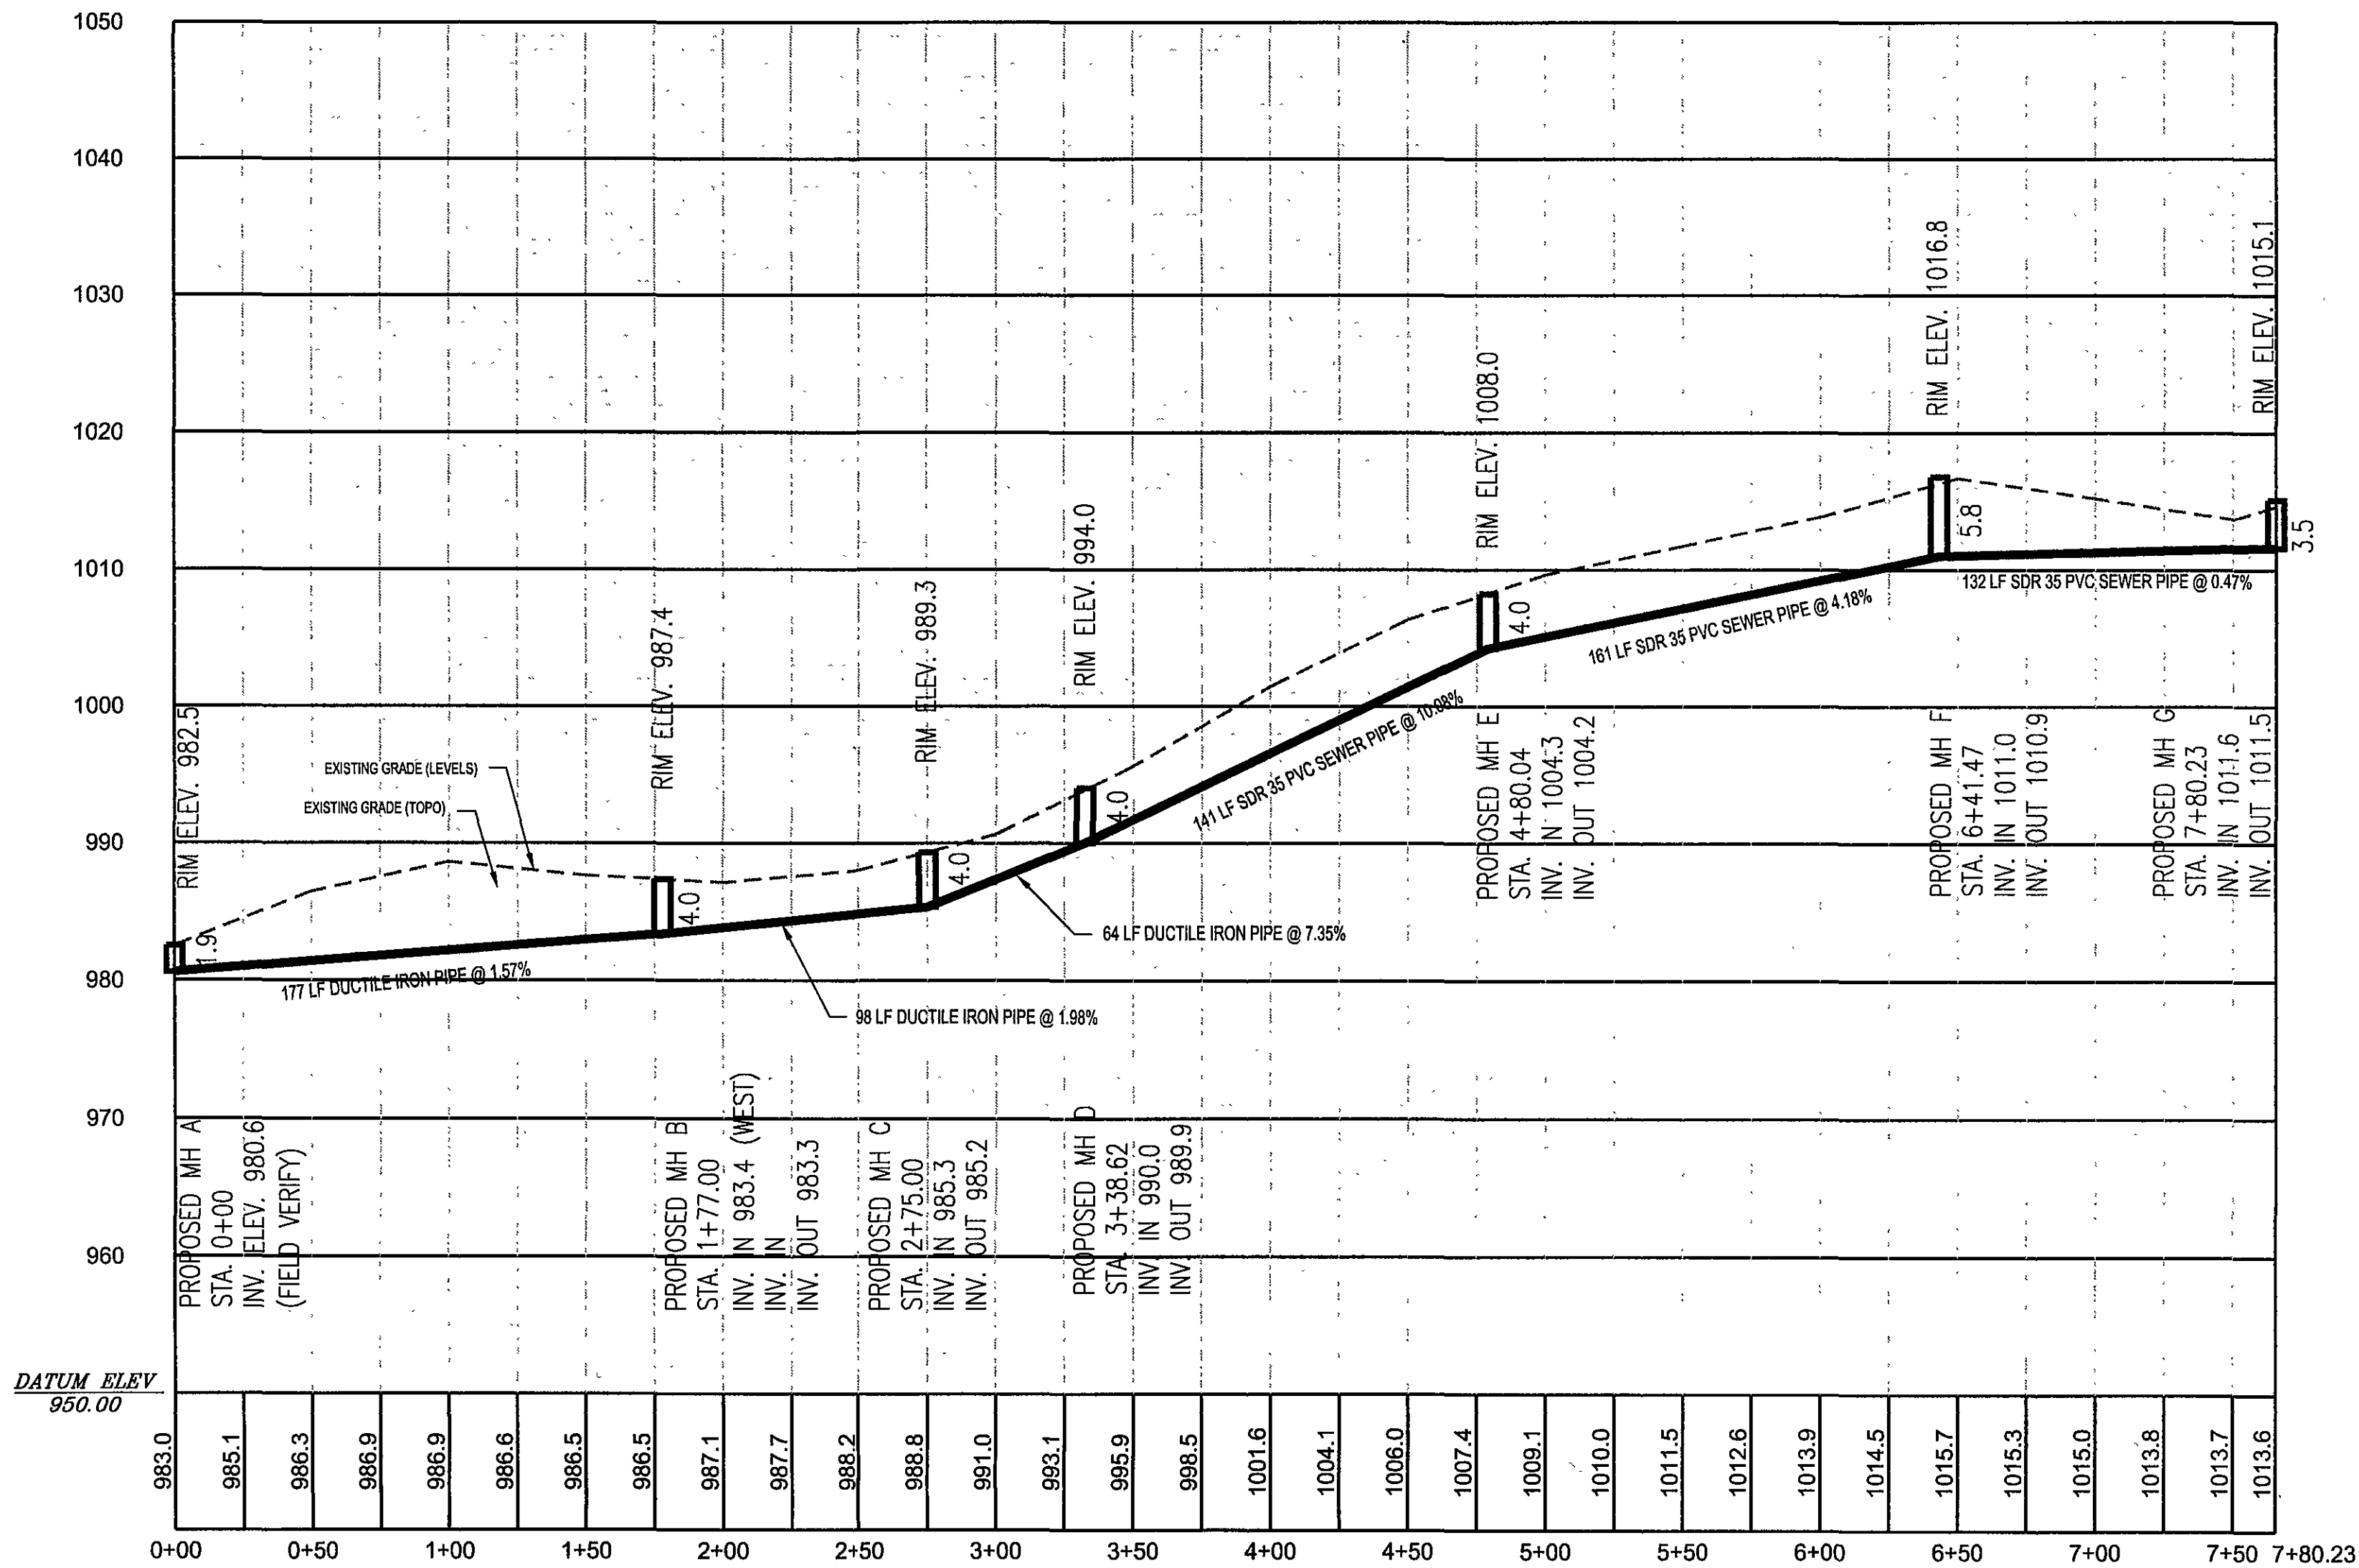

AS-BUILT
4/19/2005

SCALE: HOR. 1 IN. = 50 FT.
VERT. 1 IN. = 10 FT.

WWW.ID# 8KBMGC

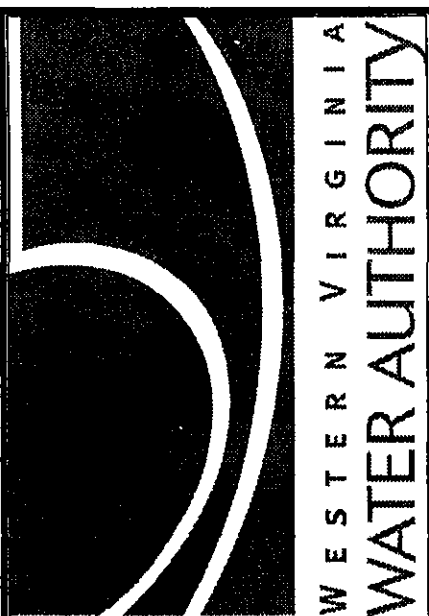

ENGINEERING SERVICES
2012 SOUTH JEFFERSON STREET
ROANOKE, VIRGINIA 24014
PHONE: (540) 853-5641



24th TO 22nd STREET, NE
PROPOSED SEWER EXTENSION

Designed By:	JAD
Drawn By:	JAD
Checked By:	JGR
Date:	12/16/04
Scale:	1" = 50'
Plan #:	04-07
Sheet:	1 OF 3