


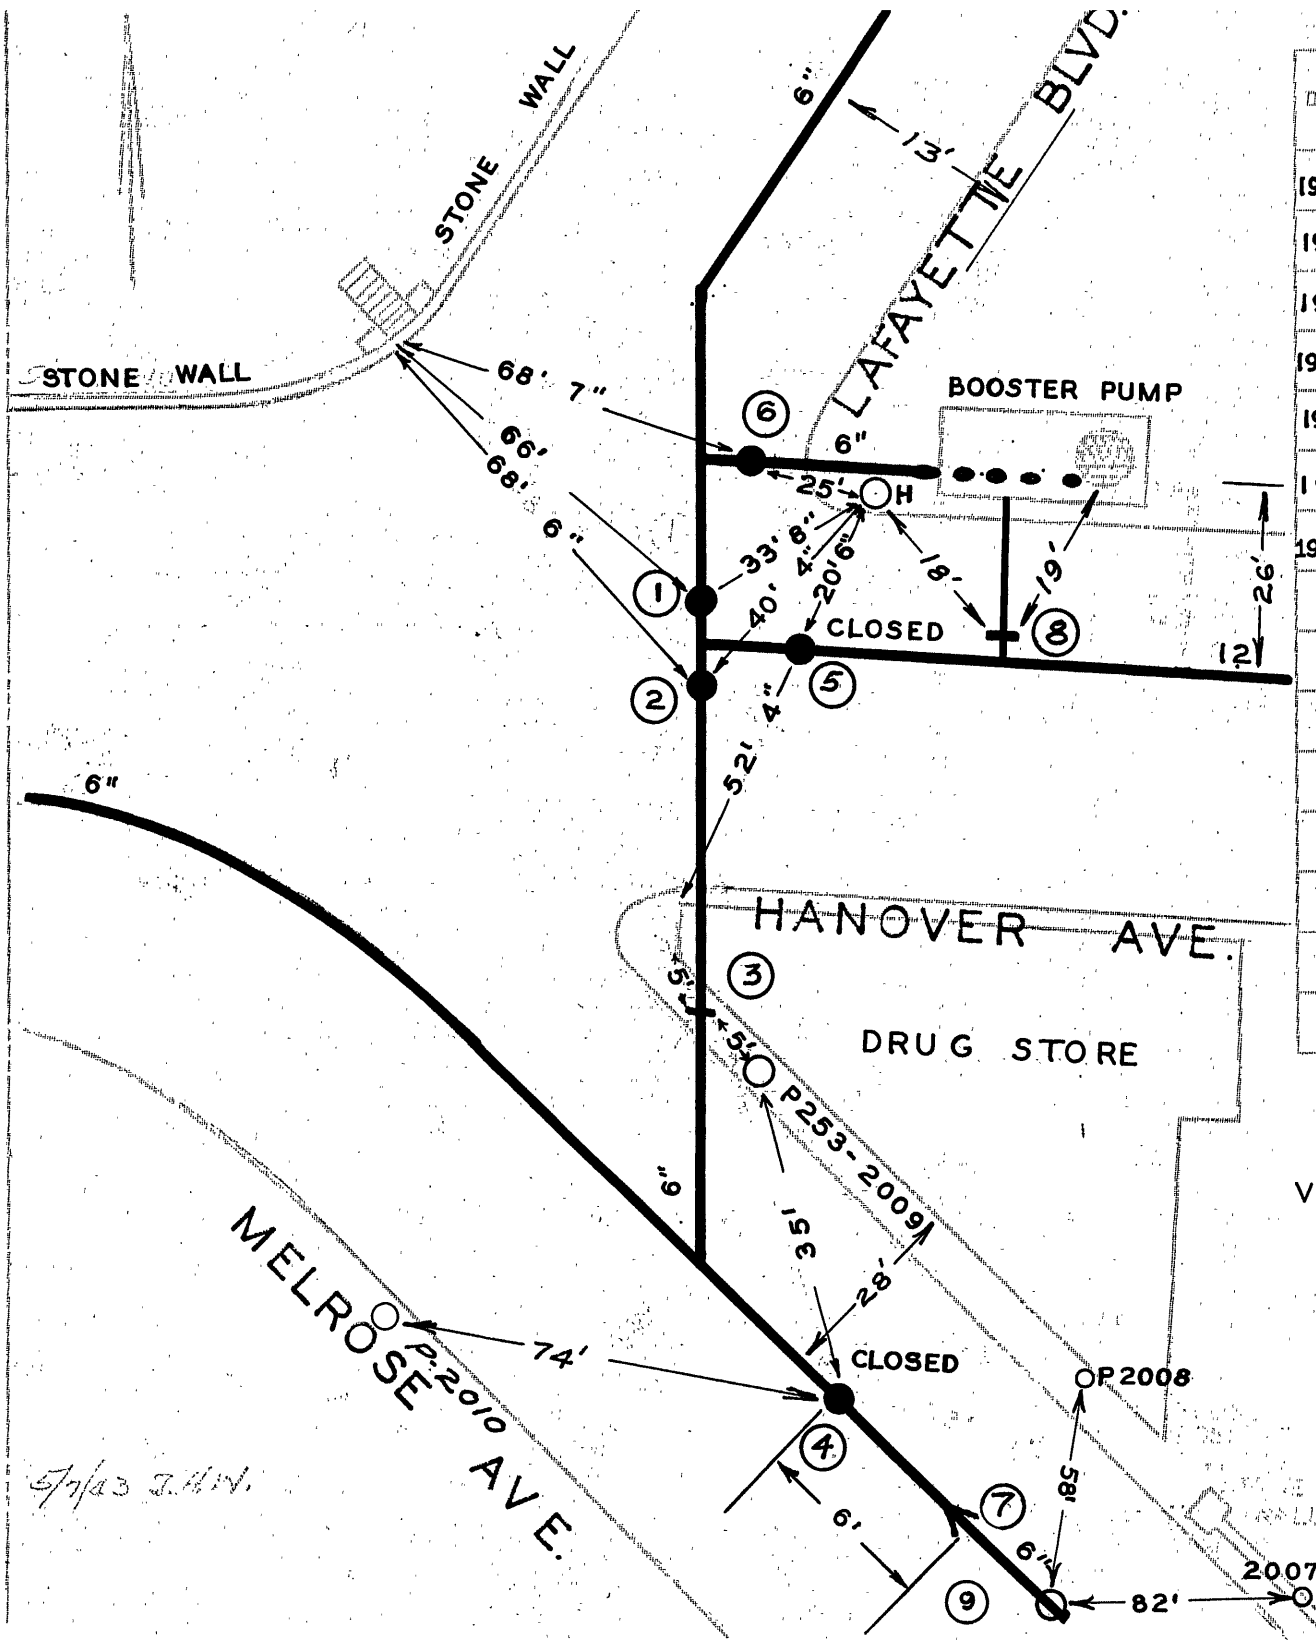

DATE	NO.	SIZE	MAKE	OPEN	TURNS
1906	1	6"		R	14
1926	2	6"		R	21
1927	3	6"		R	13
1927	4	6"		R	20
1926	5	12"		R	39
1927	6	6"		R	20
1947	7	6"	CHECK VALVE		
	8	6"			
	9	1"	PITOT STA.		
	1	26'S	NPL		
	2	23'N	SPL		
	3	0	EPL		
	4	34'E	EPL		
	5	19'E	EPL		
	6	9'W	EPL		
	7	40'E	EPL		

VILLA HEIGHTS PUMPING STATION

CITY OF ROANOKE - WATER DEPT.
VALVE DIAGRAM

HANOVER AVENUE -
LA FAYETTE BLVD. &
MELROSE AVE. N.W.

SEC. MAP 242

DATE

PAGE NO. NW 244

5/7/03 J.H.W.