

012106 VILLAGE CT

SEWER ASBUILTS


VILLAGE COURT As-Built

F&W Chuck Clark U.S. Inspector

1/14/2004

01/27/06 VILLAGE COURT

- GPS 36 GPS POINTS W&S

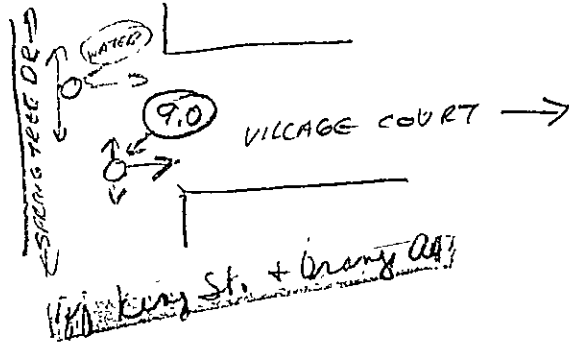

- 555 MH
- 12 ss Laterals
- WATER

