

DATE	April 1, 2010
REVISIONS	April 26, 2010


**PIERSON
ENGINEERING
&
SURVEYING**

P.O. BOX 311
1324 ROADNOKE ROAD
DALEVILLE, VA 24083


(540) 966-3027 TEL
(540) 966-5906 FAX
e-mail: rpierson@rlonnet.com

**THE VILLAGE GREEN
PHASE I**
ROANOKE COUNTY, VIRGINIA

**LITTLE WALK
ROAD &
MIDDLE
PARK LANE
PROFILES**

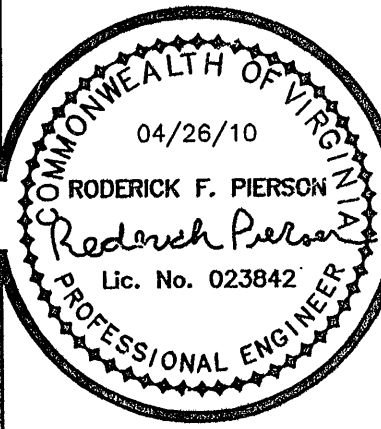

COMMISSION No.
XXXXX
SHEET
C-6

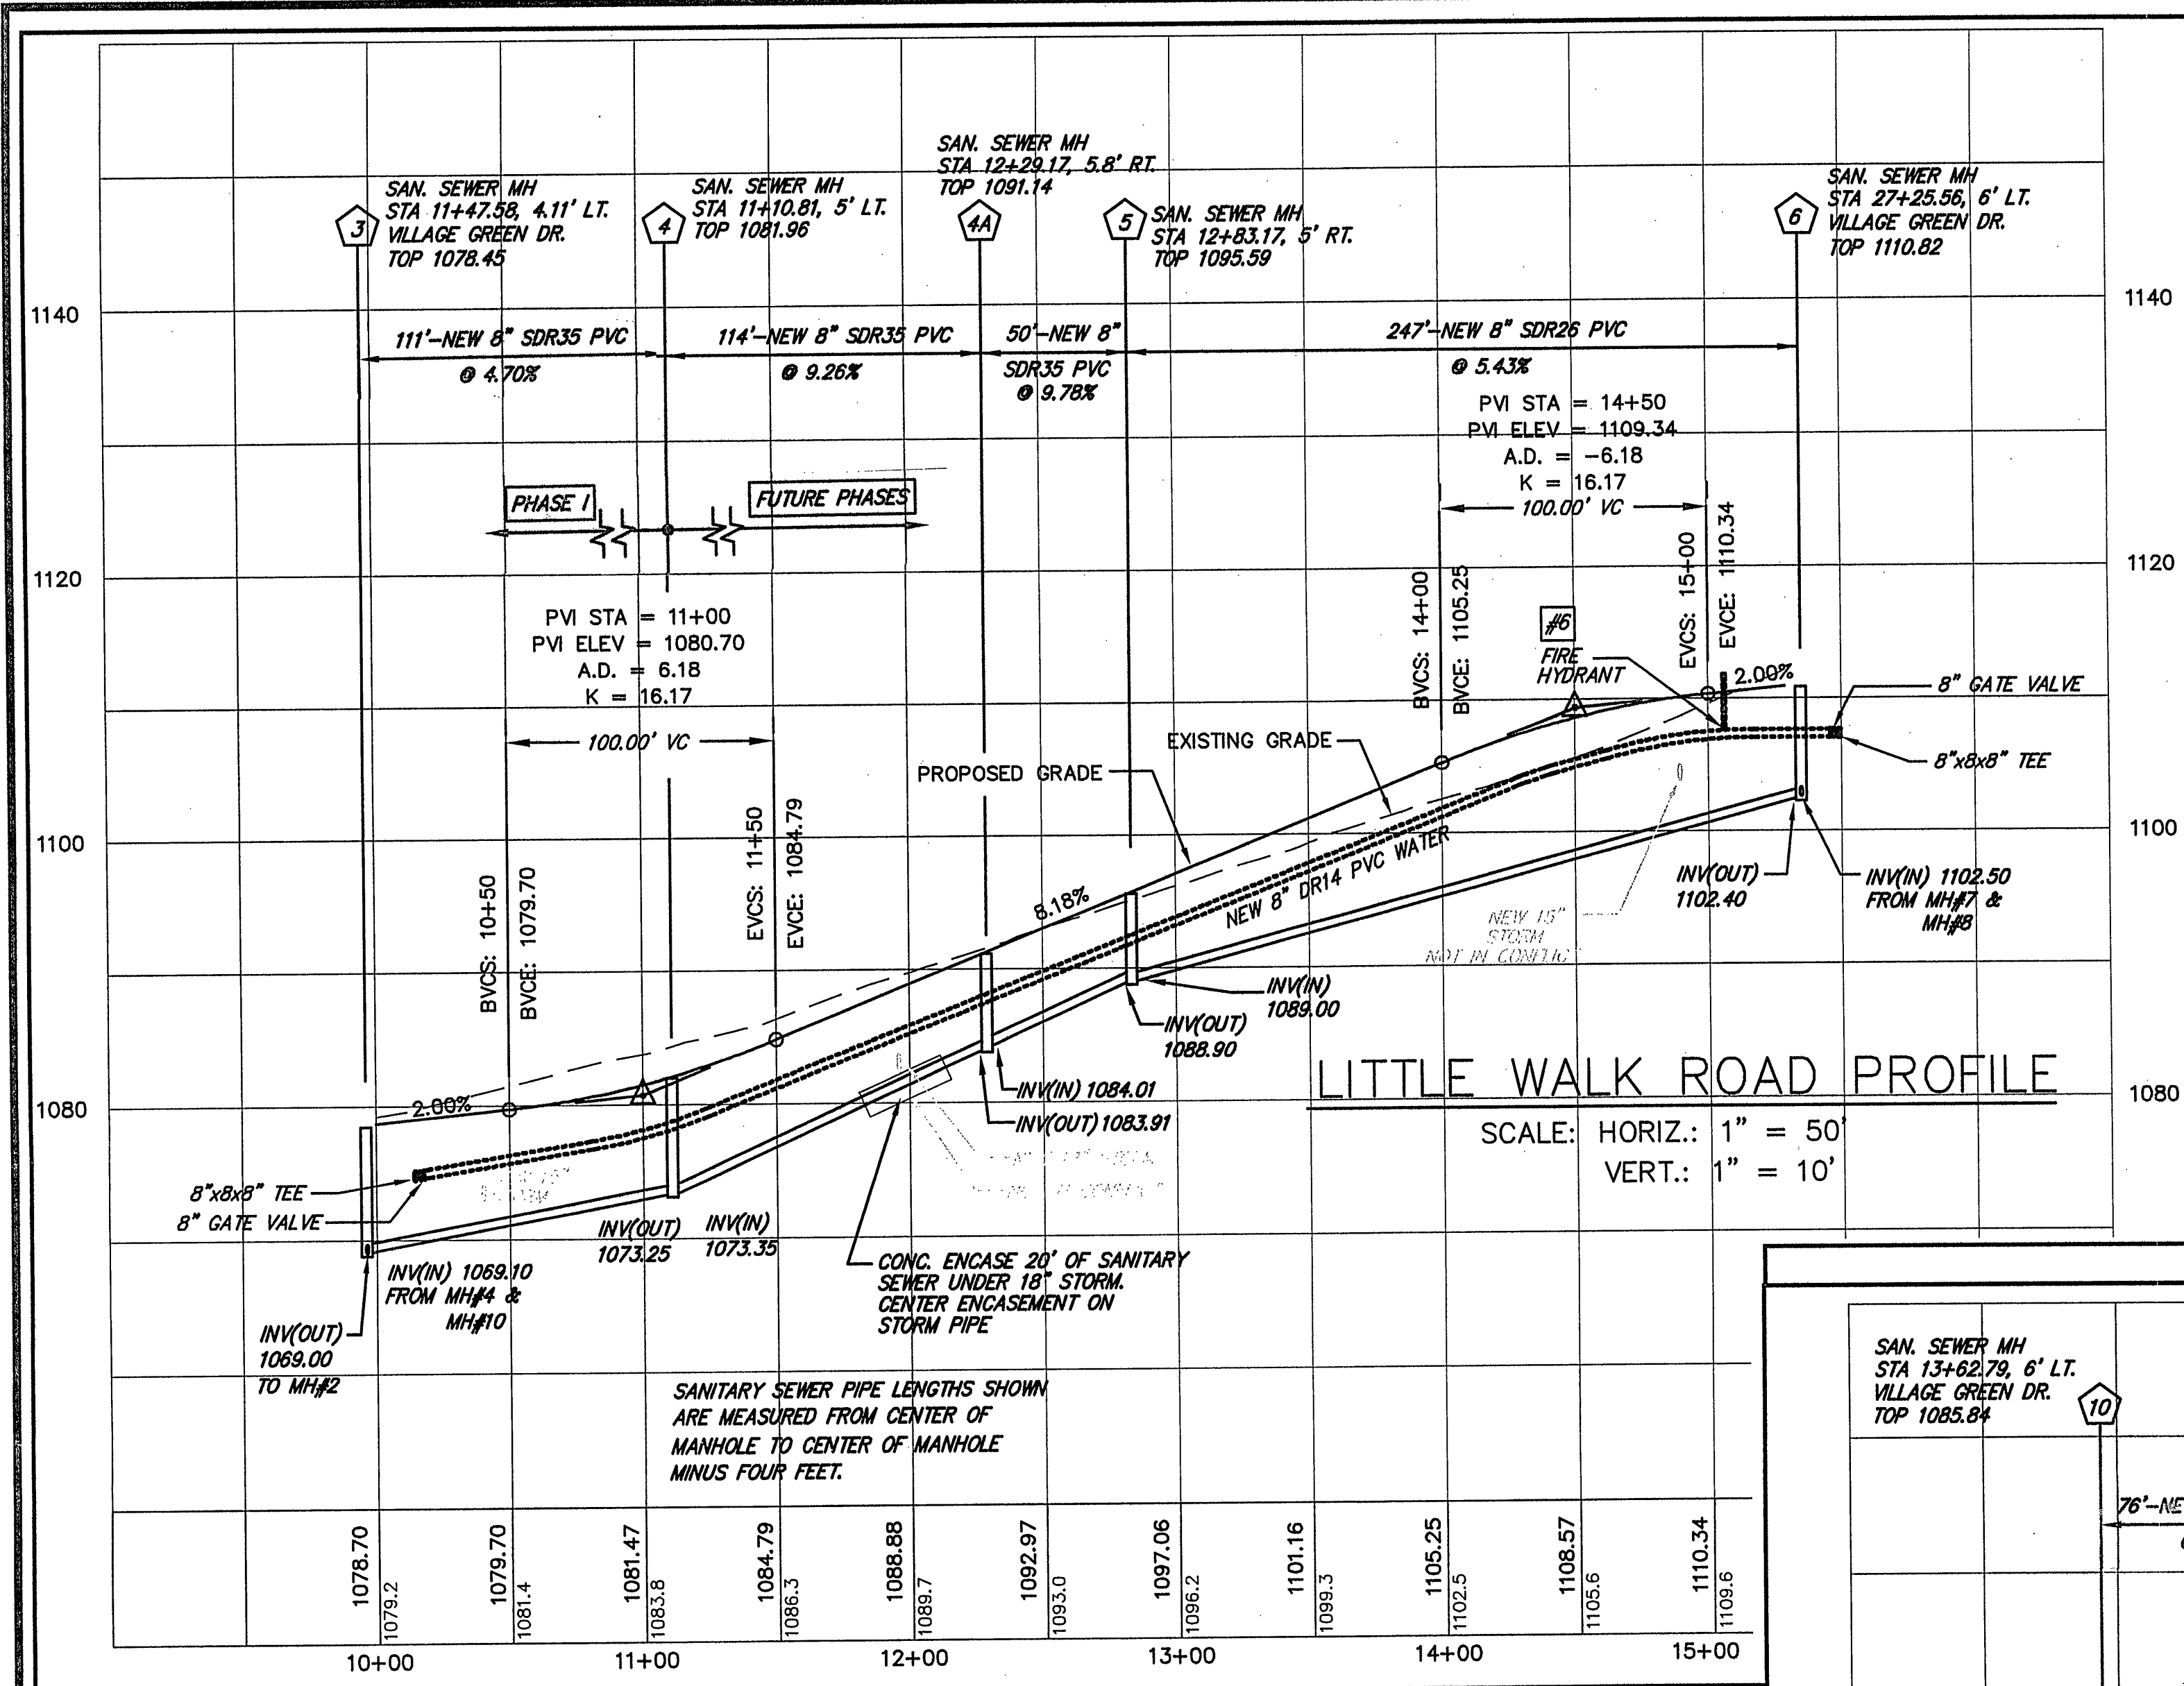


LITTLE WALK ROAD PROFILE

SCALE: HORIZ.: 1" = 50'
VERT.: 1" = 10'

FH #	STATIC PRESSURE (psi.)	FLOW WITH 20 psi. RESIDUAL (gpm)
# 1	78	1750
# 2	76	1725
# 3	64	1700
# 4	63	1700
# 5	62	1725
# 6	64	1750
# 7	70	1750

ASBUILT 09/07/2011

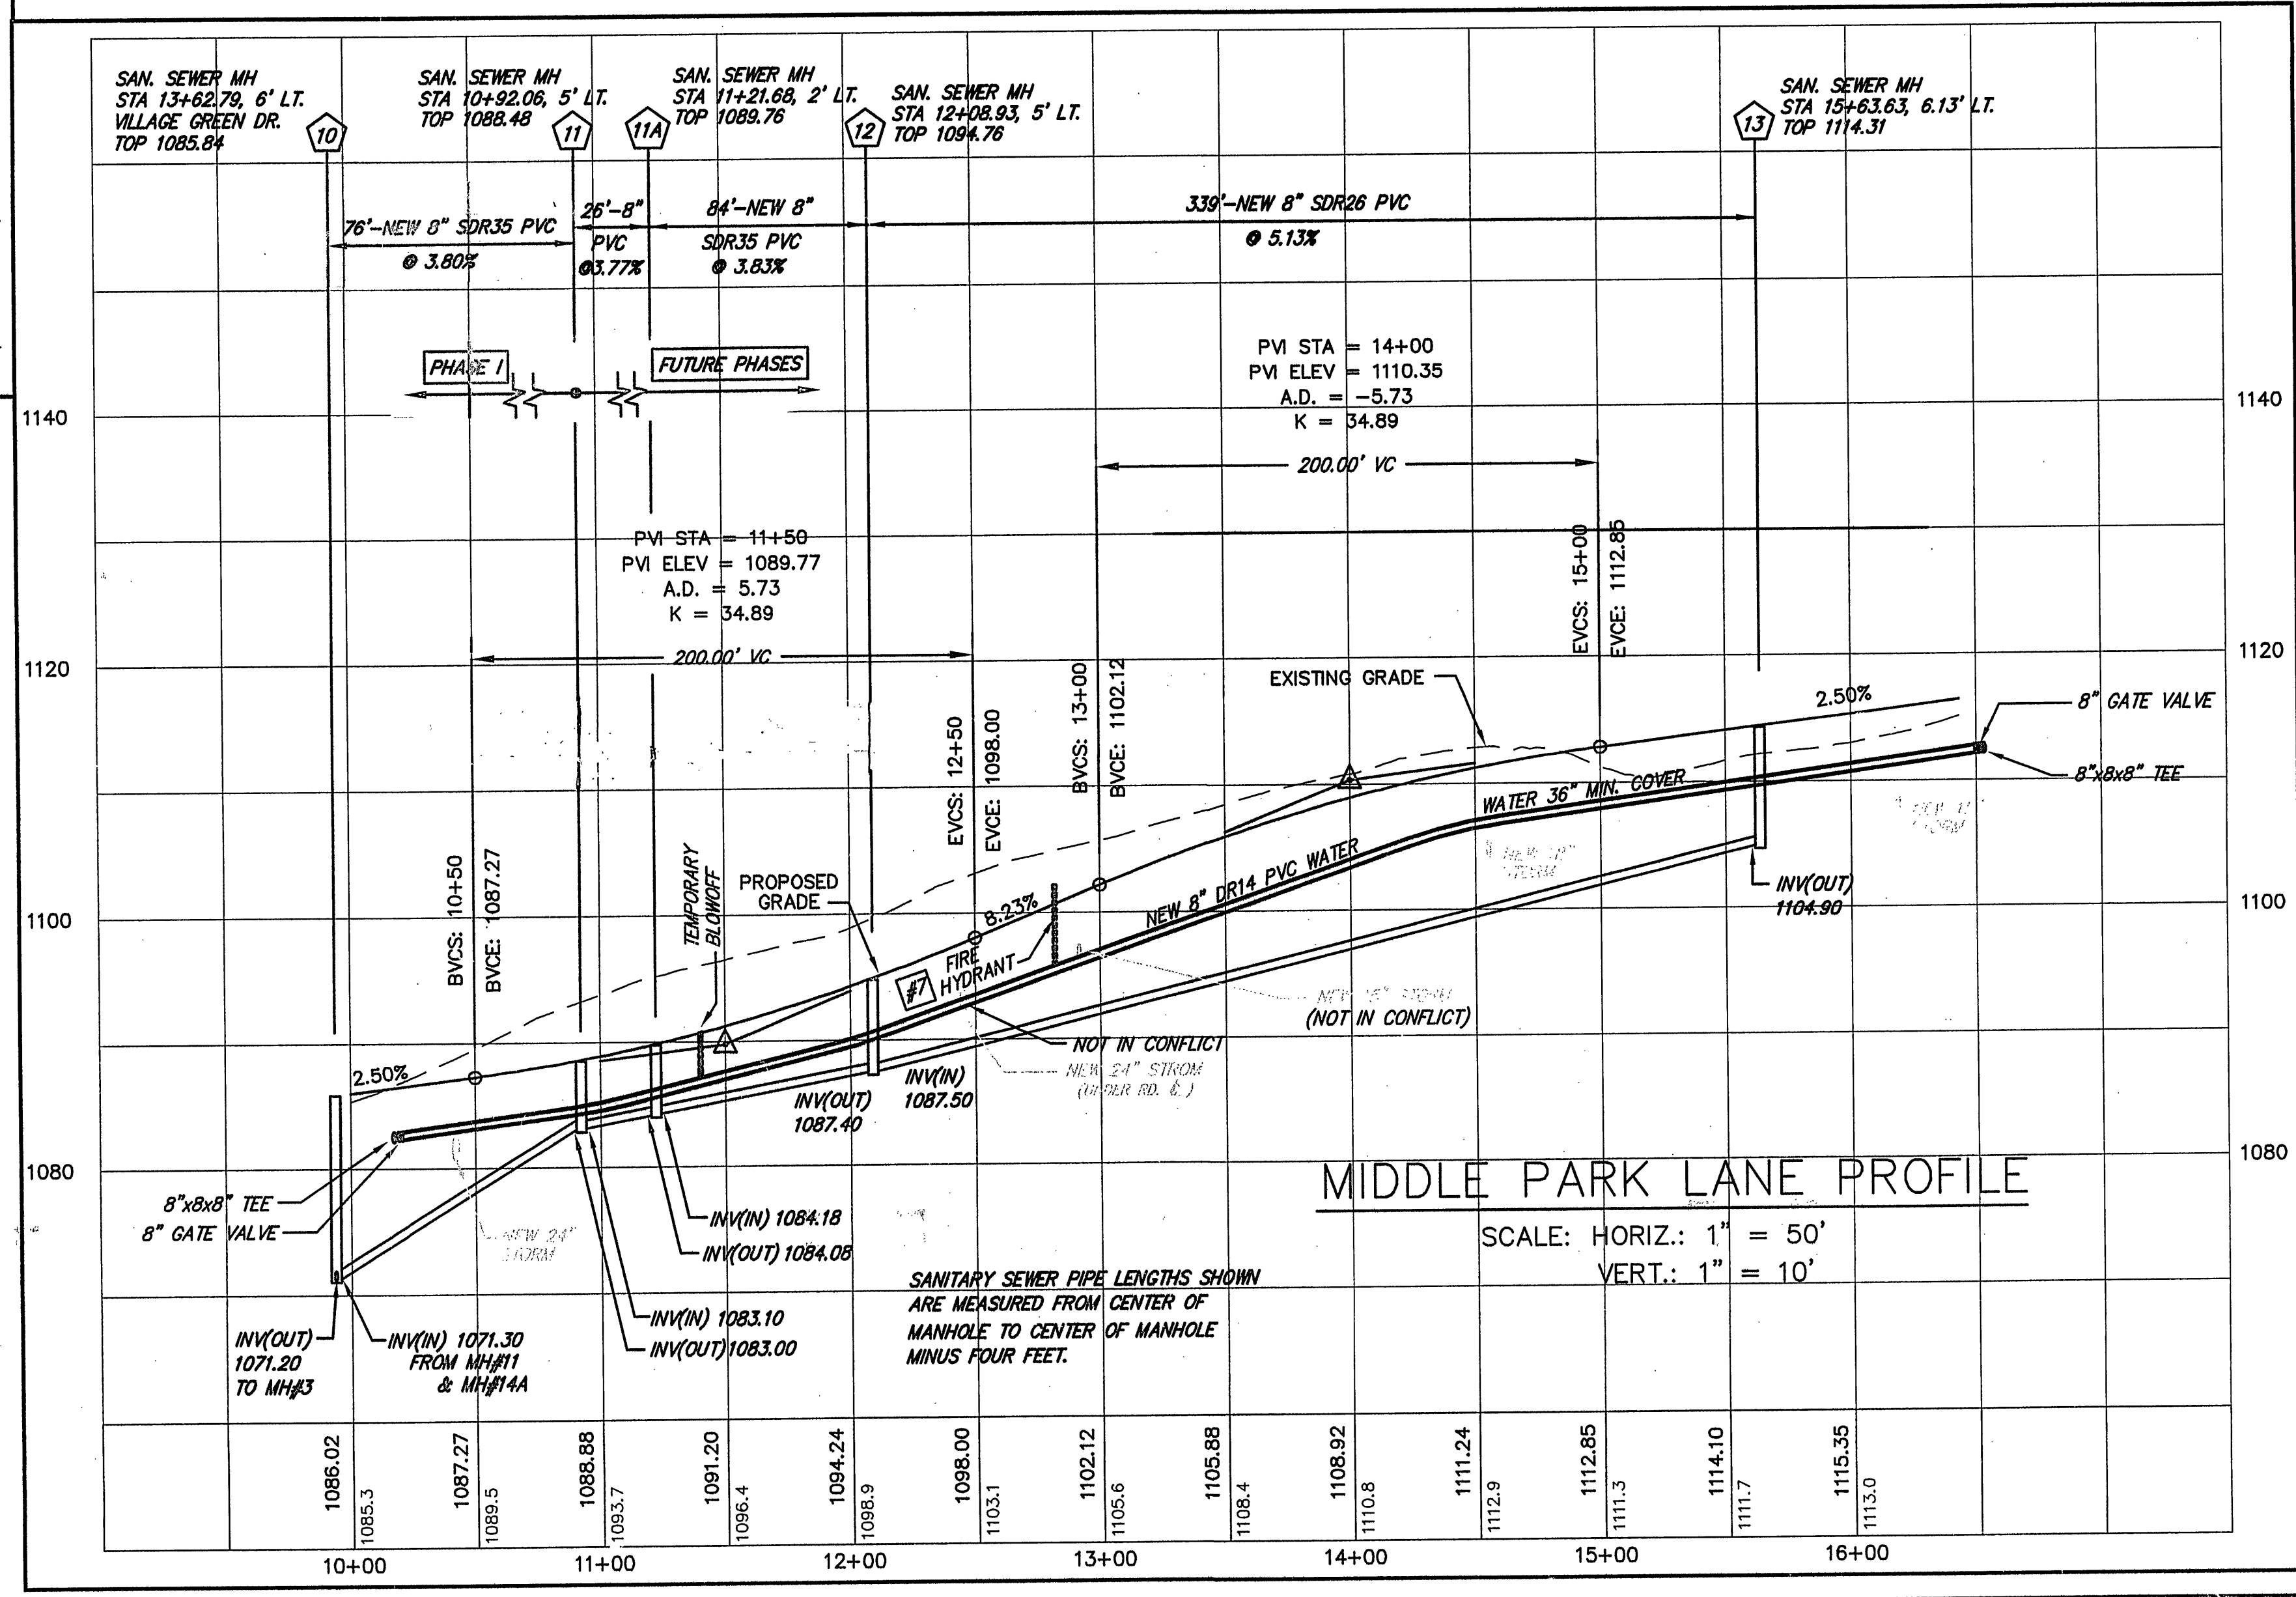

MIDDLE PARK LANE PROFILE

SCALE: HORIZ.: 1" = 50'
VERT.: 1" = 10'