

DATE:	03/21/2011
REVISIONS	
▲	
▲	

**PIERSON
ENGINEERING
&
SURVEYING**

P.O. BOX 311
1324 ROANOKE ROAD
DALEVILLE, VA 24083

(540) 966-3027 TEL
(540) 966-5906 FAX
e-mail: rpierson@bnet.com

**THE VILLAGE GREEN
PHASE I
ROANOKE COUNTY, VIRGINIA**

**WATER &
SANITARY
SEWER PLAN**

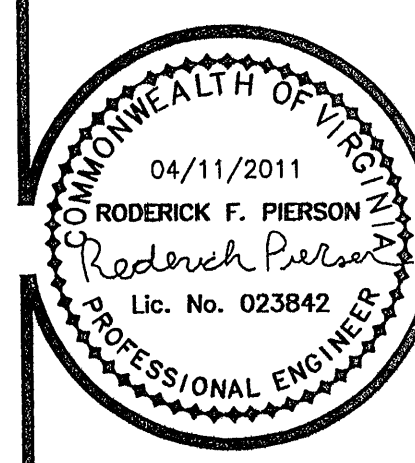

COMMISSION No.
XXXXX
SHEET
C-7

ASBUILT 09/07/2011

