



SANITARY SEWER SERVICE LATERAL ELEVATION TABLE

LOT #	CLEANDOUT INV. ELEV.	MIN. BLDG. ELEV.	LOT #	CLEANDOUT INV. ELEV.	MIN. BLDG. ELEV.
1A	1069.60	1072.10	75	1102.32	1104.32
1B	1069.90	1072.40	76	1099.00	1101.00
2A	1069.90	1072.40	77	1096.40	1098.40
2B	1070.30	1072.80	78	1096.40	1098.40
3A	1070.30	1072.80	79	1092.00	1094.00
3B	1070.70	1073.20	80	1089.60	1091.60
4A	1070.70	1073.20	81	1089.60	1091.60
4B	1071.40	1073.90	82	1086.40	1088.40
5A	1071.40	1073.90	83	1089.00	1091.00
5B	1071.70	1074.20	84	1090.50	1092.50
6A	1071.70	1074.20	85	1090.55	1092.55
6B	1072.30	1074.80	86	1092.50	1094.50
7A	1072.30	1074.80	87	1095.00	1097.00
8	1072.60	1075.10	88	1099.00	1101.00
9	1072.60	1075.10	89	1099.00	1101.00
10	1076.70	1078.20	90	1101.95	1103.95
11	1076.70	1078.20	91	1106.00	1108.00
12	1078.80	1080.30	92	1106.00	1108.00
13	1078.80	1080.30	93	1098.30	1103.35
14A	1082.10	1083.60	94	1096.50	1101.27
14B	1082.10	1083.60	95	1096.50	1101.27
14C	1084.10	1085.60	96	1091.30	1095.28
14D	1084.10	1085.60	97	1091.50	1093.50
15	1085.70	1088.00	98	1091.50	1093.50
16	1090.00	1092.00	99	1079.93	1081.93
17	1089.70	1091.60	100	1077.00	1079.00
18	1093.40	1094.80	101	1074.40	1076.40
19	1096.40	1098.40	102	1099.30	1104.40
20	1096.40	1098.40	103	1096.50	1101.30
21	1099.00	1101.00	104	1096.50	1101.30
22	1102.50	1104.50	105	1092.80	1097.20
23	1108.00	1110.00	106	1091.50	1093.50
24	1109.50	1111.50	107	1089.10	1091.10
25	1111.50	1113.50	108	1083.80	1085.80
26	1113.05	1115.05	109	1077.00	1079.00
27	1114.60	1116.60	110	1073.50	1075.50
28	1116.00	1118.00	111	1073.50	1075.50
29	1119.00	1121.00			
30	1119.00	1121.00			
31	1117.90	1119.90			
32	1117.90	1119.90			
33	1116.40	1118.40			
34	1116.40	1118.40			
35	1114.80	1116.80			
36	1114.80	1116.80			
37	1112.90	1114.90			
38	1112.90	1114.90			
39	1111.50	1113.50			
40	1110.40	1112.40			
41	1108.00	1110.00			
42	1108.00	1110.00			
43	1105.60	1109.40			
44	1105.60	1109.40			
45	1103.80	1108.90			
46	1103.00	1108.80			
47	1103.00	1108.80			
48	1104.50	1109.00			
49	1107.90	1109.90			
50	1107.90	1109.90			
50A	1071.80	1074.80			
50B	1071.80	1074.80			
51A	1072.30	1075.80			
51B	1072.30	1075.80			
52A	1072.70	1076.20			
52B	1072.70	1076.20			
53A	1073.80	1077.30			
53B	1073.80	1077.30			
54A	1074.50	1078.00			
54B	1074.50	1078.00			
55	1077.50	1081.00			
56	1077.50	1081.00			
57	1080.30	1083.30			
58	1083.50	1086.20			
59	1085.70	1088.00			
60	1087.90	1089.80			
61	1093.40	1095.00			
62	1096.00	1098.00			
63	1098.00	1100.00			
64	1101.60	1103.60			
65	1107.90	1109.90			
66	1109.86	1111.86			
67	1112.42	1114.42			
68	1112.42	1114.42			
69	1115.71	1117.71			
70	1115.71	1117.71			
71	1119.00	1121.00			
72	1119.00	1121.00			
73	1105.60	1107.60			
74	1105.60	1107.60			

All sewer tested by C. Clark 1.18-1.19.11

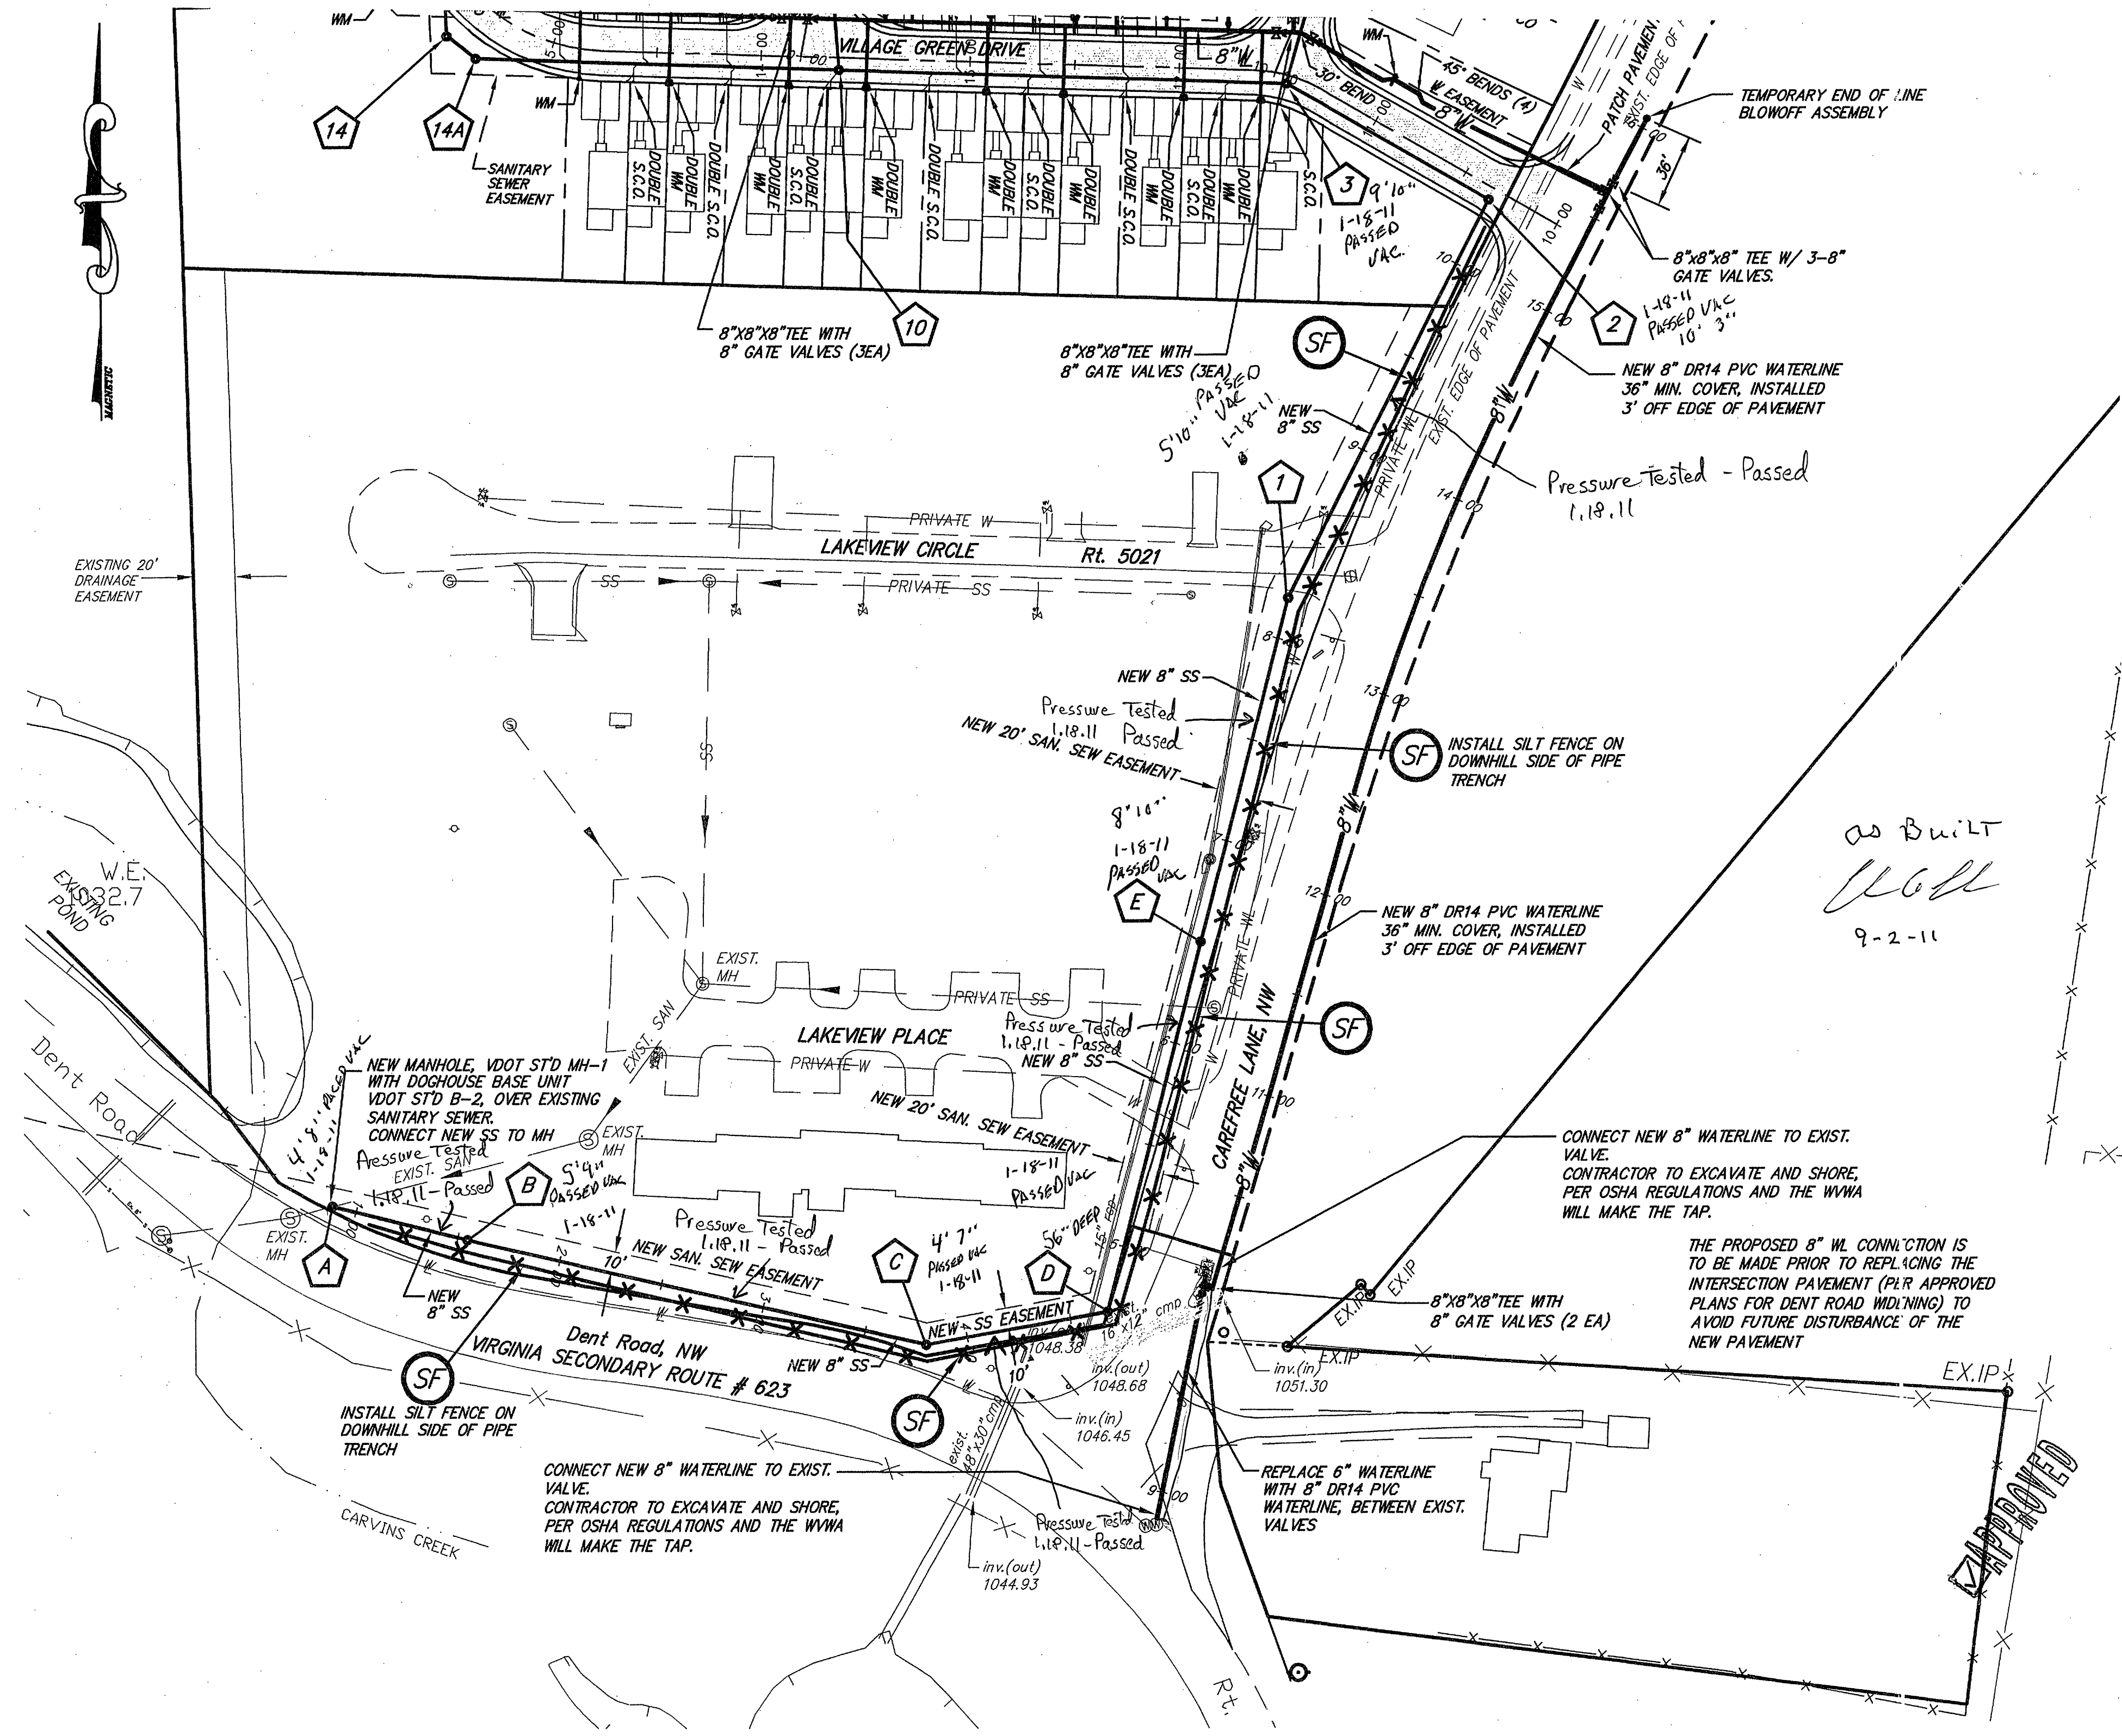

FOR LIMITS OF CONSTRUCTION/DISTURBANCE
SEE SHEET C-22

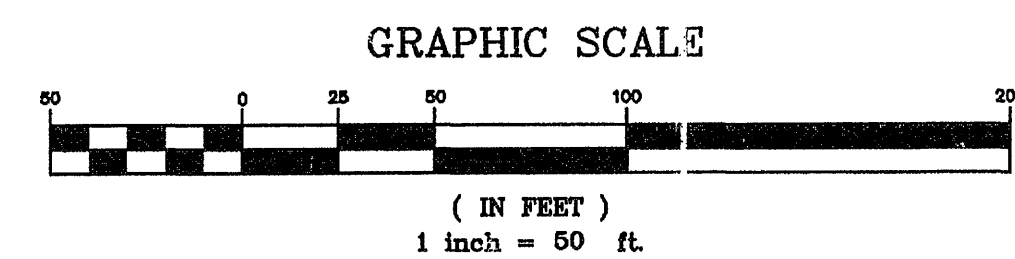

DATE	April 1, 2010
REVISIONS	April 26, 2010


PIERSON
ENGINEERING
&
SURVEYING

P.O. BOX 311
1324 ROANOKE ROAD
DALEVILLE, VA 24083

(540) 966-3027 TEL
(540) 966-5906 FAX
e-mail: rpierson@bnet.net

THE VILLAGE GREEN
PHASE I
ROANOKE COUNTY, VIRGINIA

OFF-SITE
WATER &
SANITARY
SEWER PLAN

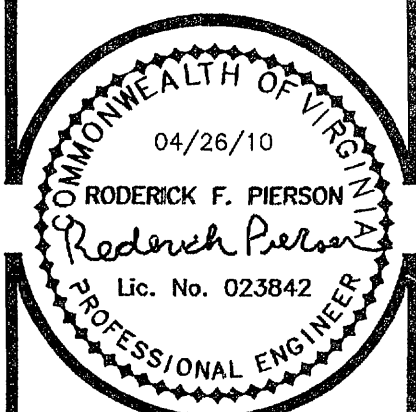

COMMISSION No.
XXXXX
SHEET
C-8