
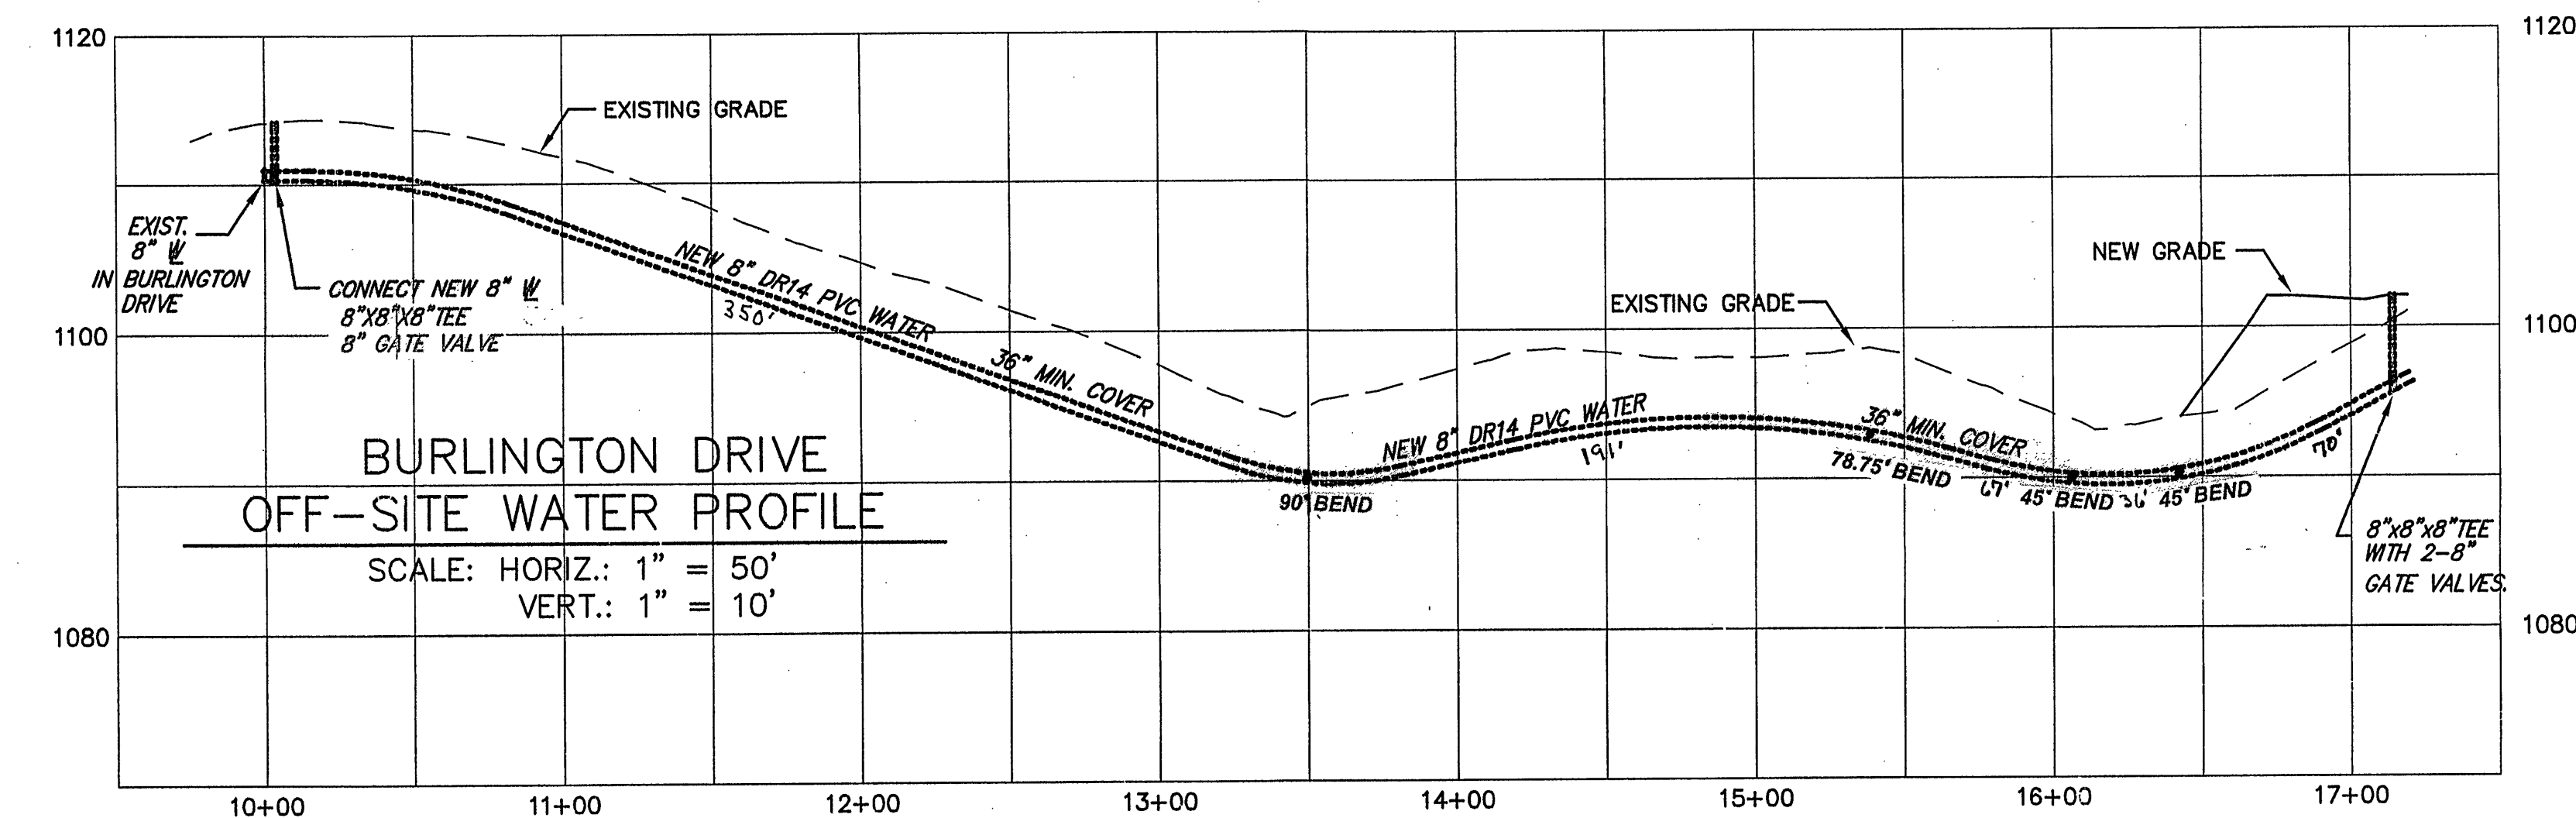
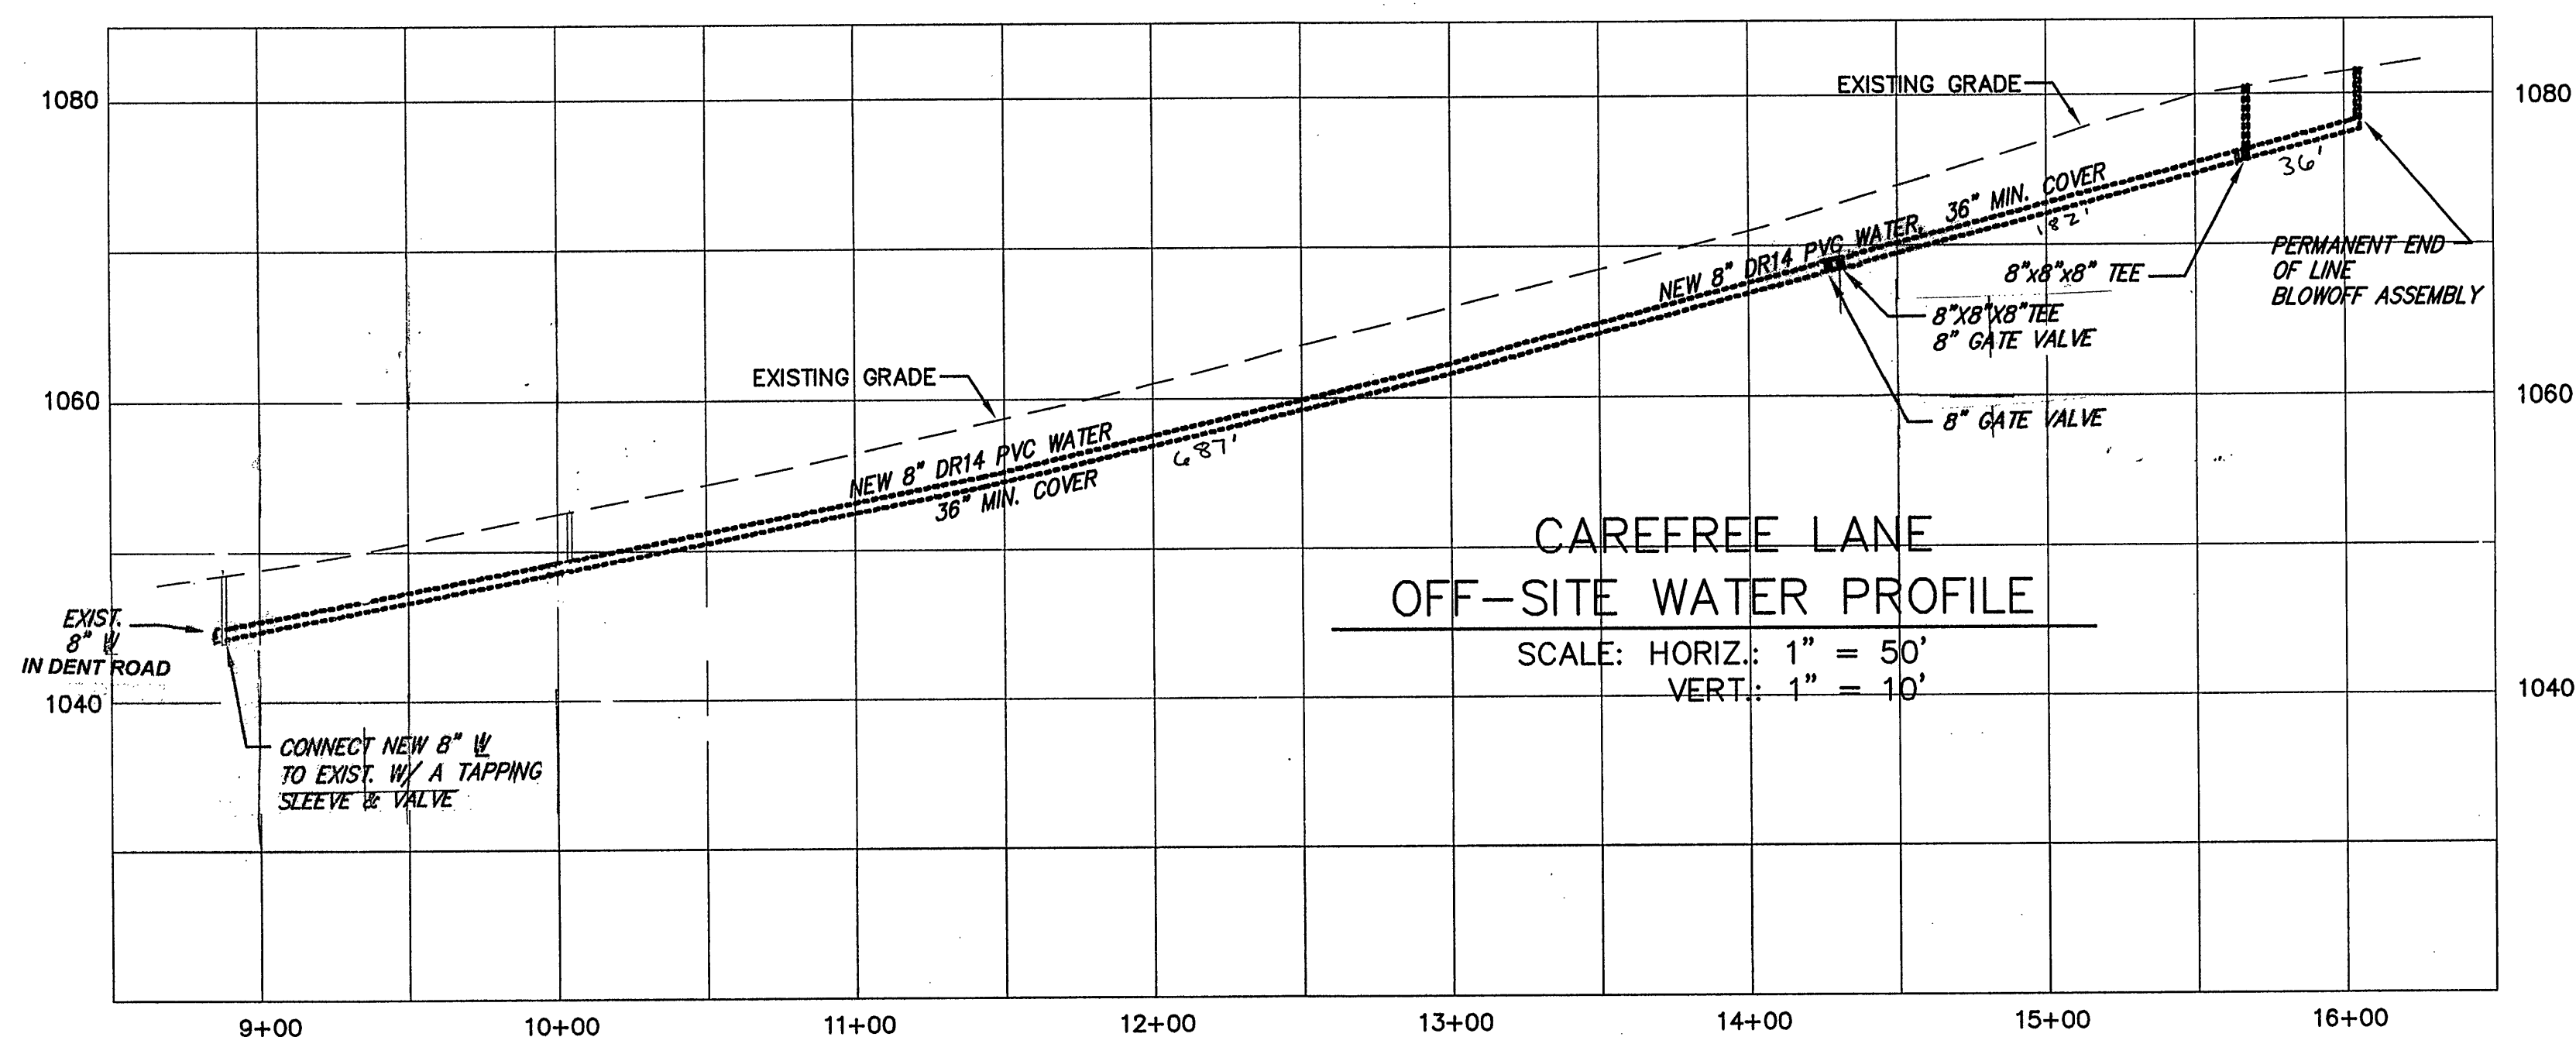


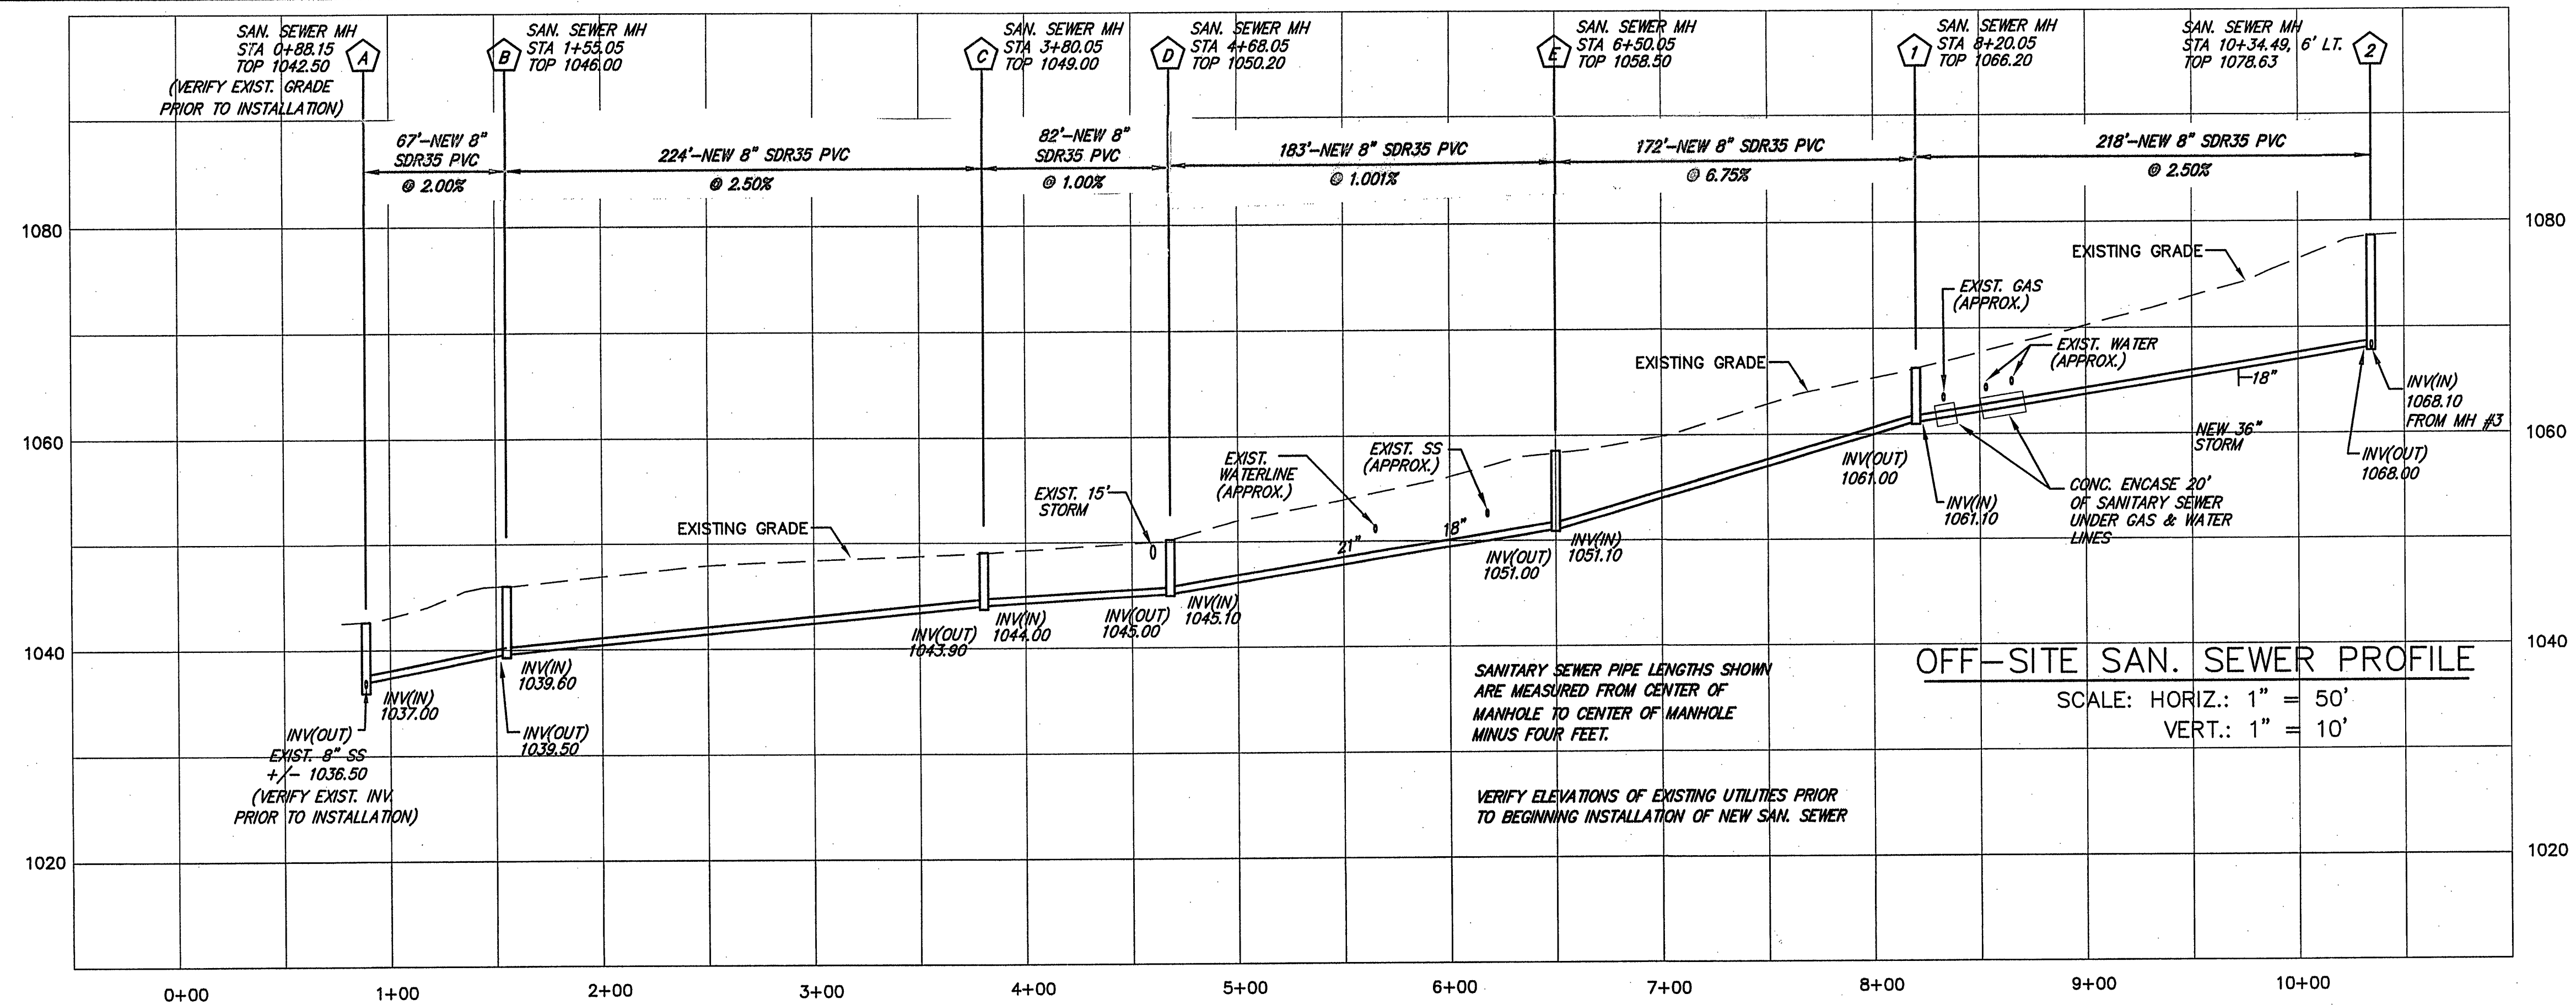

REVISIONS	DATE: <u>April 1, 2010</u>
	<u>1</u> <u>April 26, 2010</u>
	<u> </u> <u> </u>
	<u> </u> <u> </u>

PIERSON
ENGINEERING
&
SURVEYING

P.O. BOX 311
1324 ROANOKE ROAD
DALEVILLE, VA 24083

(540) 966-3027 TEL
(540) 966-5906 FAX
e-mail rplerson@rbnet.com

**THE VILLAGE GREEN
PHASE I
ROANOKE COUNTY, VIRGINIA**

OFF-SITE WATER & SANITARY SEWER PROFILE

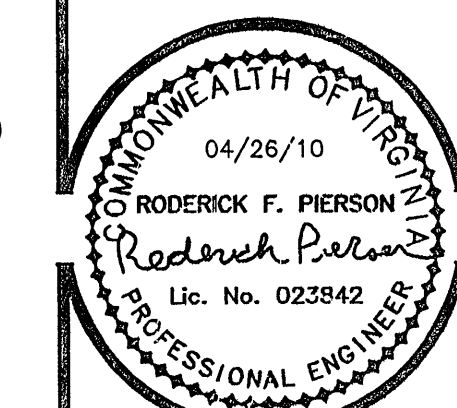

COMMISSION No.
XXXXX
SHEET
C-9

ASBUILT 09/07/2011