
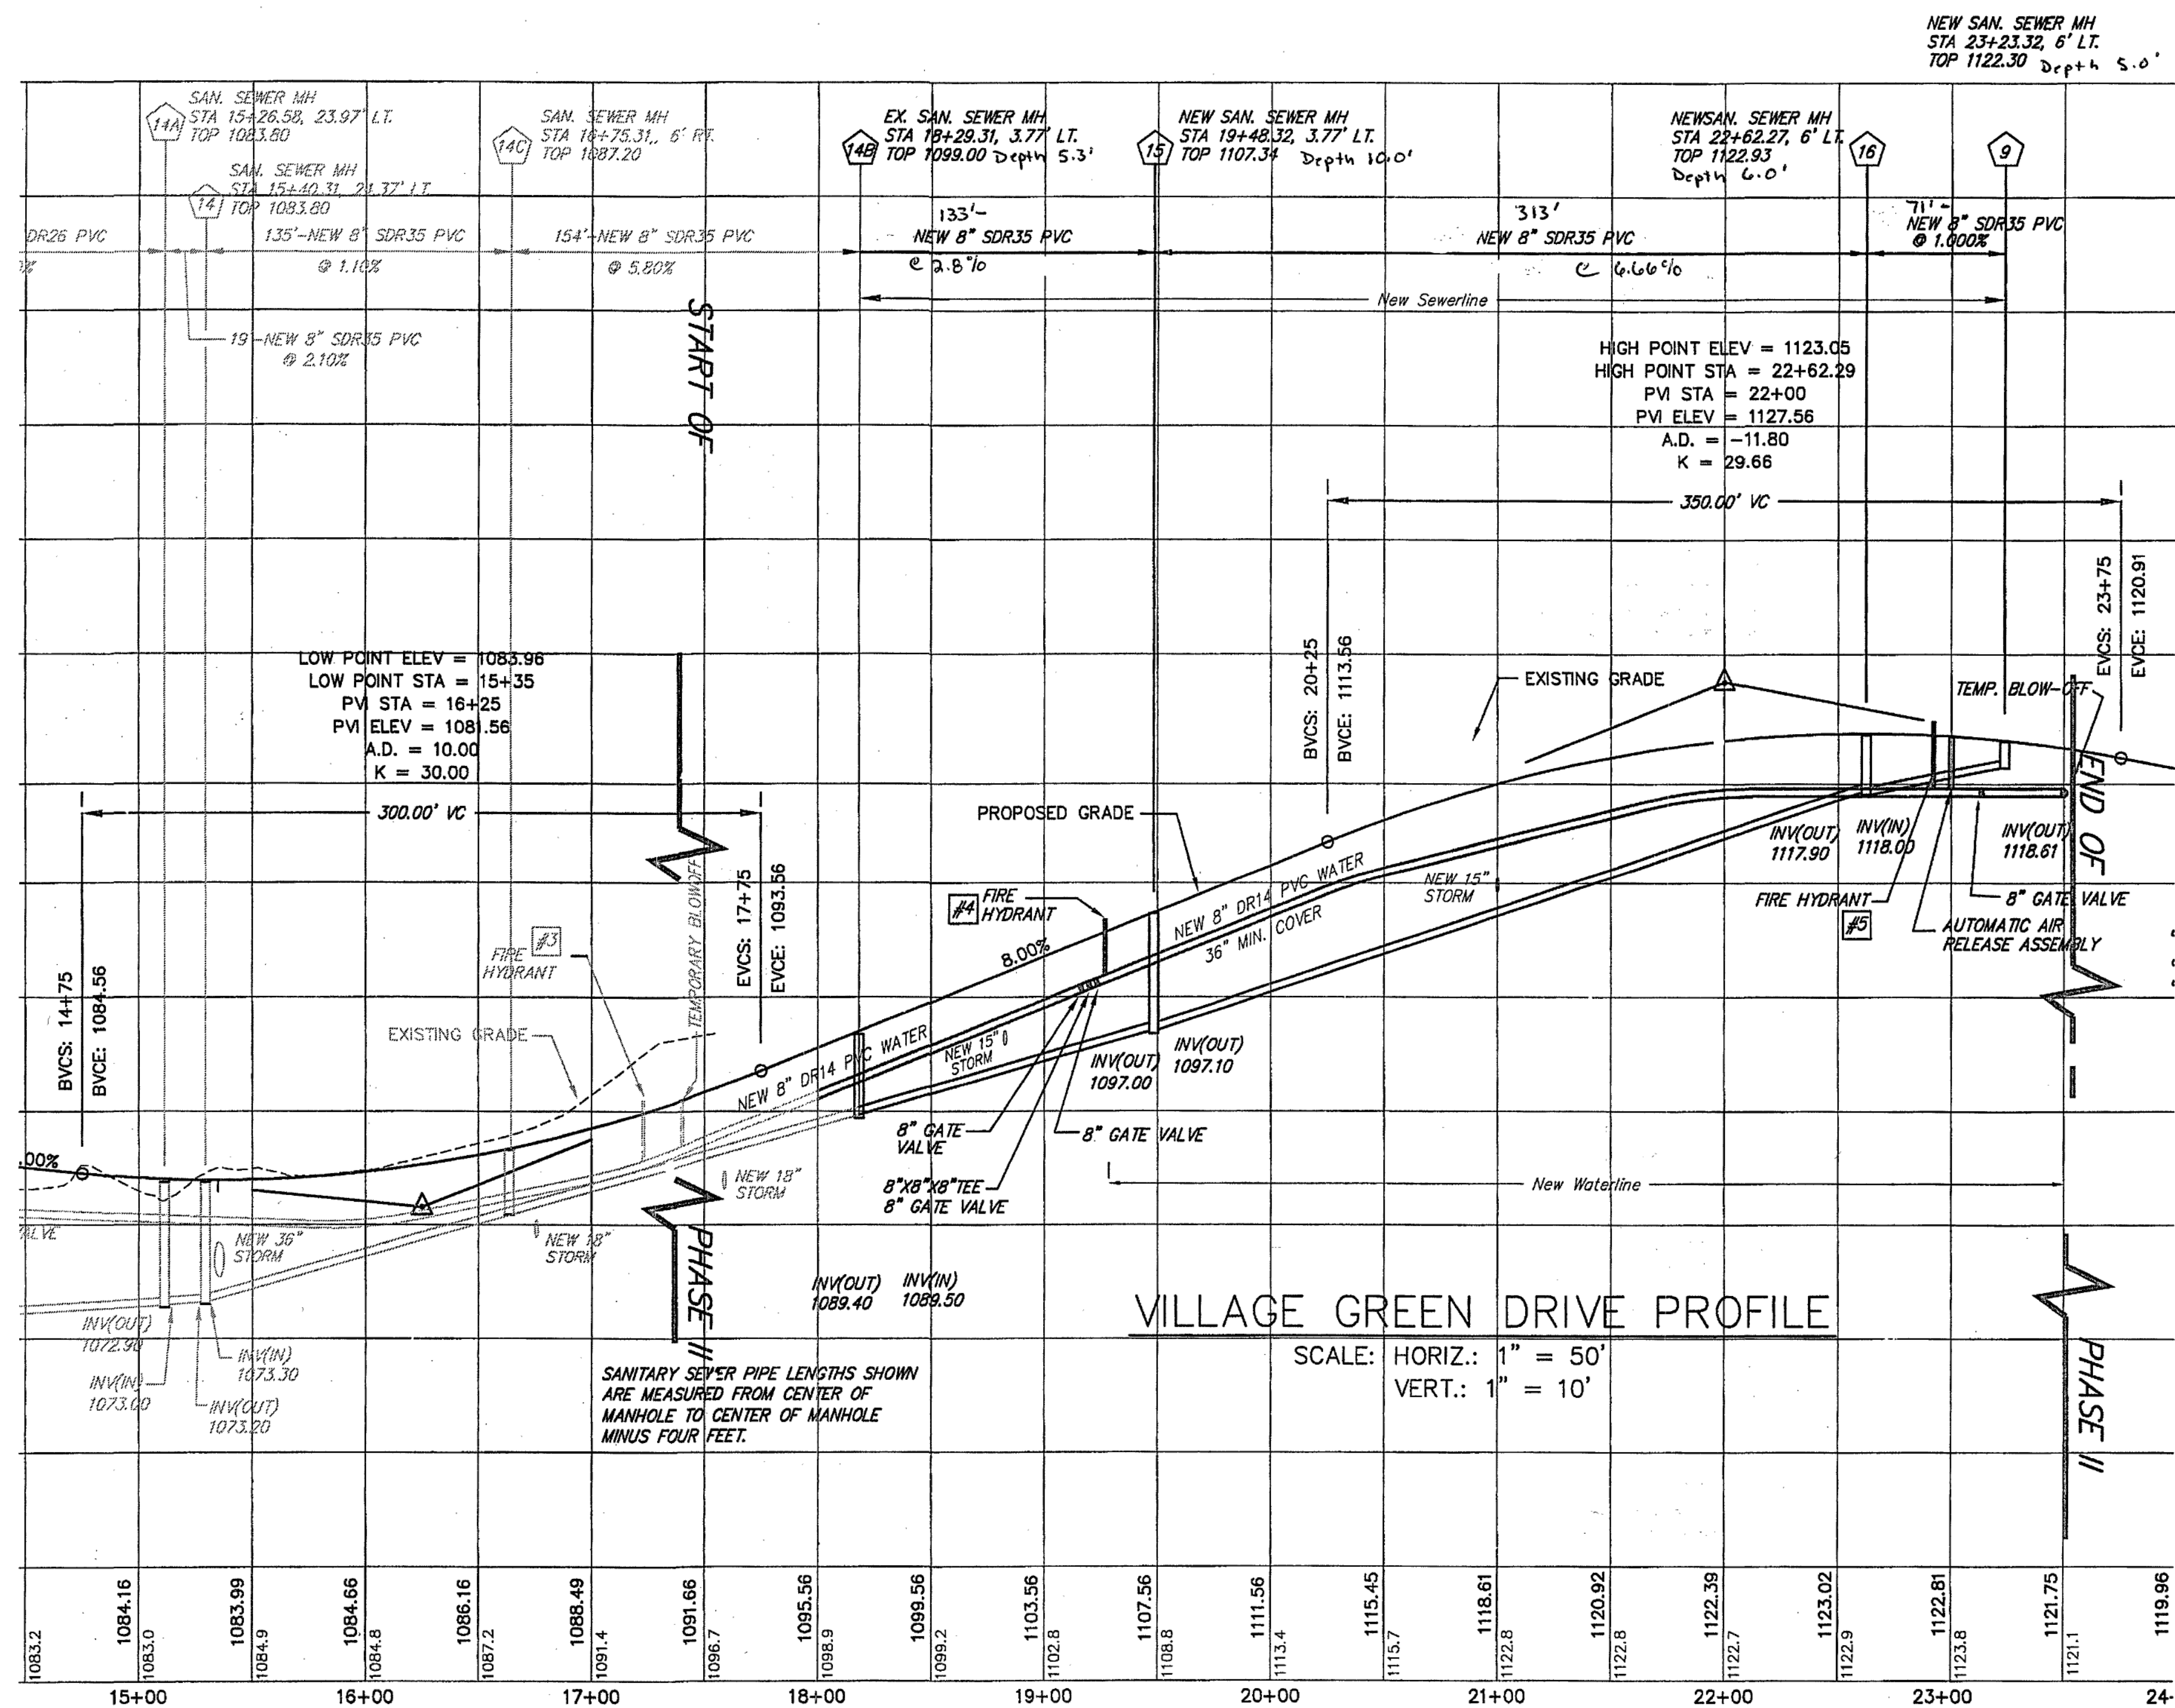


P.O. BOX 311  
44 CATAWBA ROAD  
DALEVILLE, VA 24083

**THE VILLAGE GREEN  
PHASE II  
ROANOKE COUNTY, VIRGINIA**

VILLAGE  
GREEN DR.  
PROFILE  
**AS BUILTS**

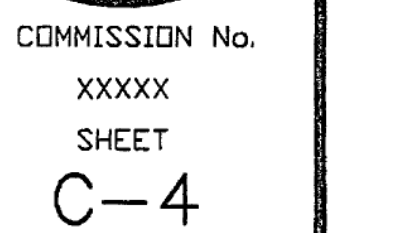

**CONTRACTOR MUST INSTALL A SEWER LATERAL  
AND A WATER METER TO EACH UNIT.**

☒ APPROVED