


REVISIONS

P.O. BOX 311
1324 ROANOKE ROAD
DALEVILLE, VA 24083

THE VILLAGE GREEN
PHASE II
ROANOKE COUNTY, VIRGINIA

03/29/2013
 RODERICK F. PIERSON
Roderick F. Pierson
 Lic. No. 023842
 PROFESSIONAL ENGINEER

COMMISSION No.
XXXXX
SHEET
C-5

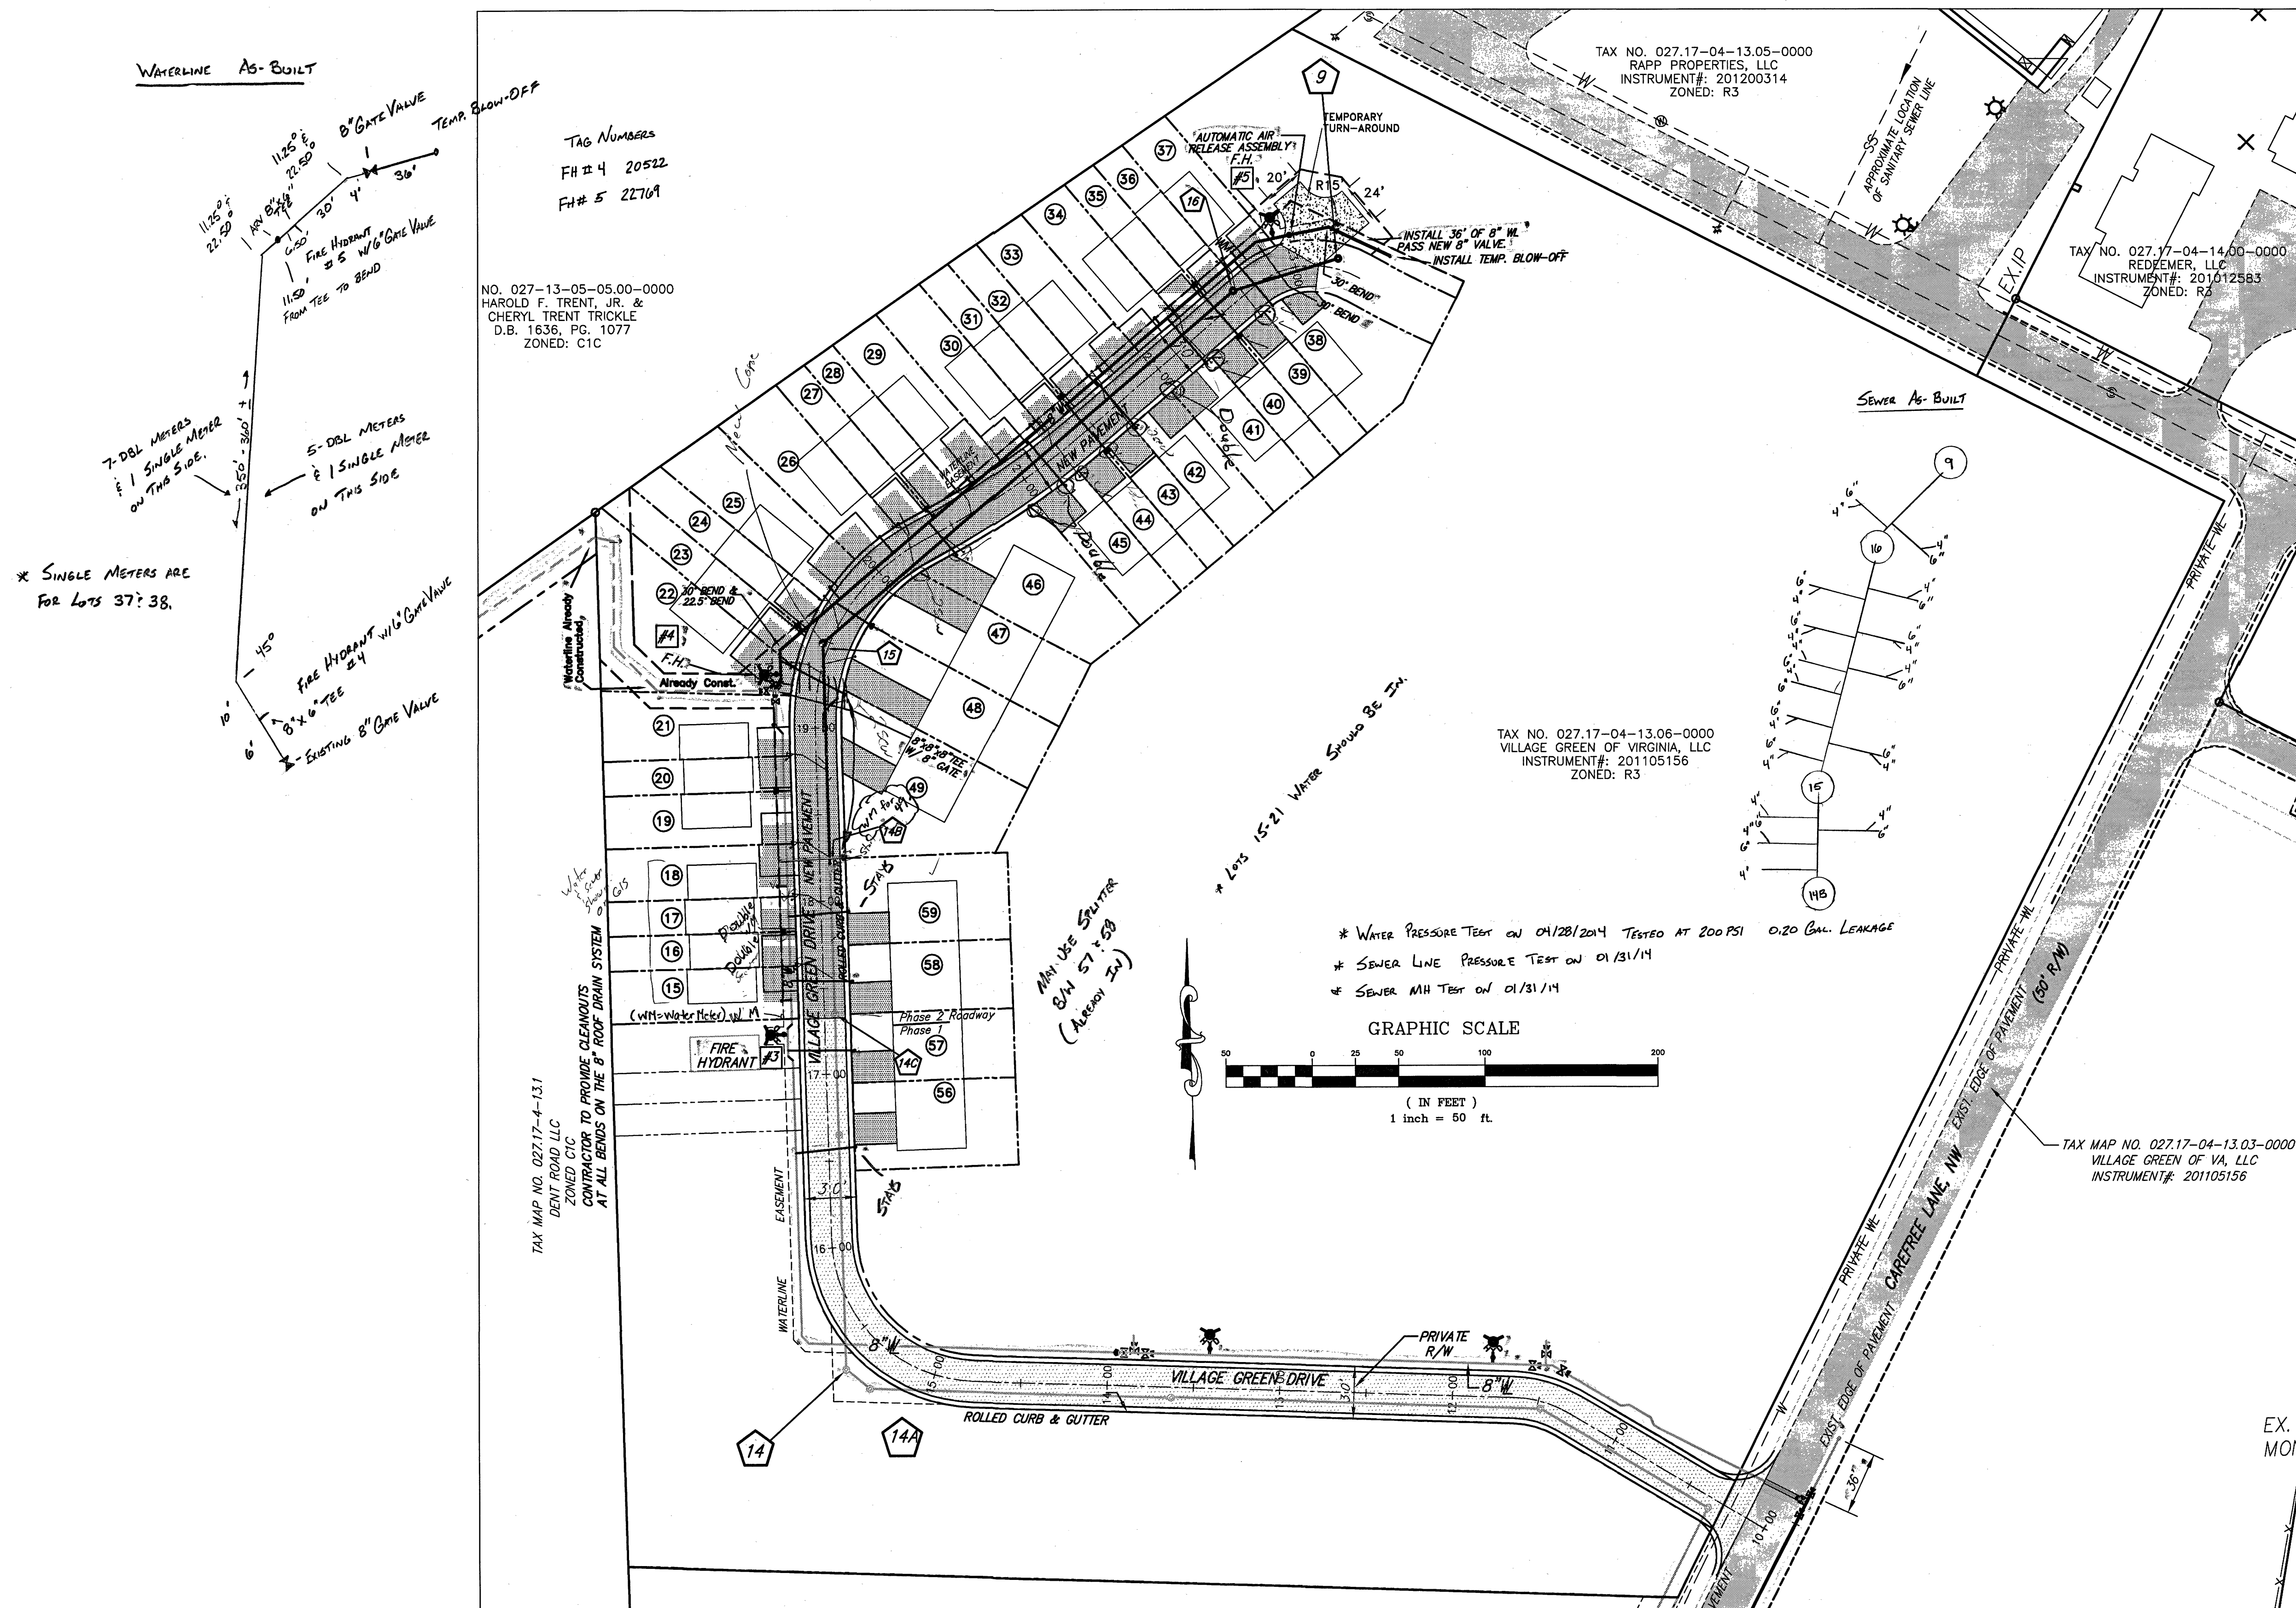

THESE ARE AS-BUILTS BY INSPECTOR CHARLIE CRUSH
OF WESTERN VIRGINIA WATER AUTHORITY ENGINEERING
DEPARTMENT 04/16/2015

☒ APPROVED