


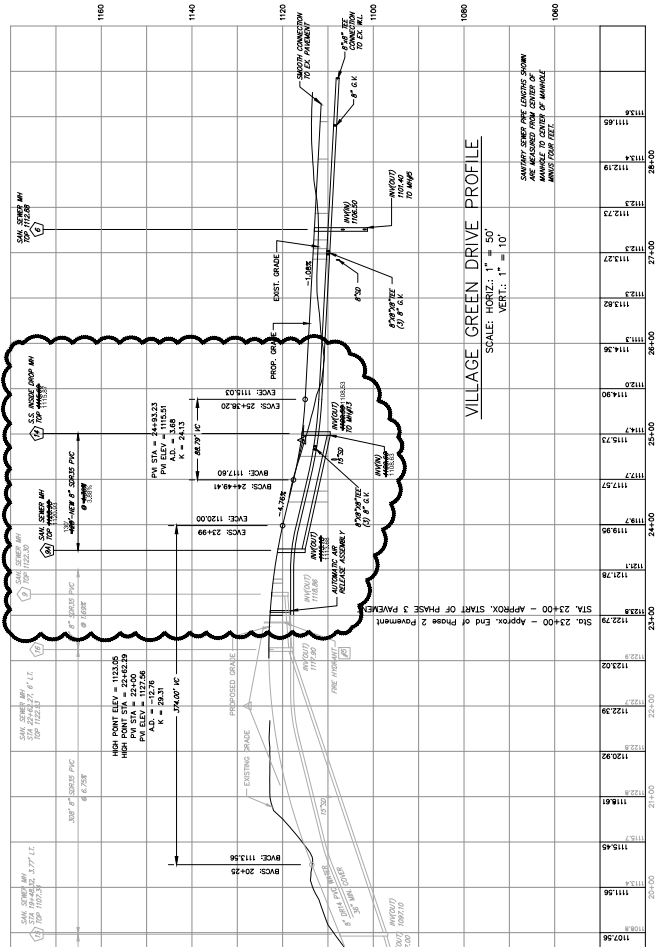

AS-BUILT DRAWING NOTE:
THIS DRAWING IS FOR SANITARY SEWER AND WATER MAINS ONLY. NO IMPROVEMENTS OTHER THAN WATER AND SANITARY SEWER STRUCTURES AND PIPING ARE TO BE CONSIDERED. THE SUBJECT PLAN SET, UNDERGROUND PIPING WAS NOT LOCATED. LOCATION SHOWN IS APPROXIMATE. ON-SITE SURVEY DATA AND INFORMATION PROVIDED BY CONTRACTOR.

SIDE VIEW

FRONT VIEW

TRASH ENCLOSURE SECTION & GATE
CANE BOLT (1 PER GATE)

