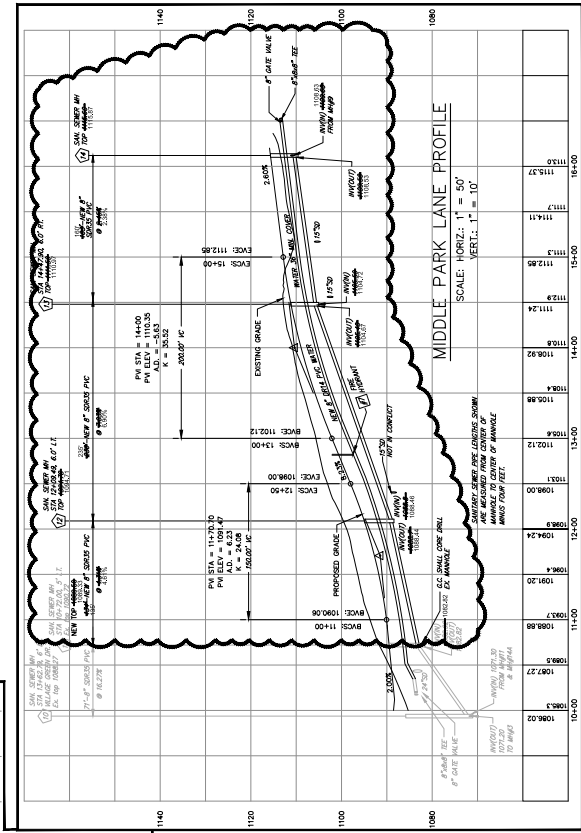
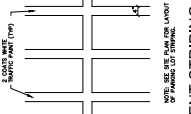
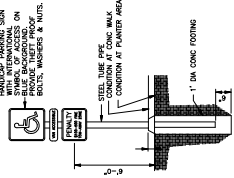
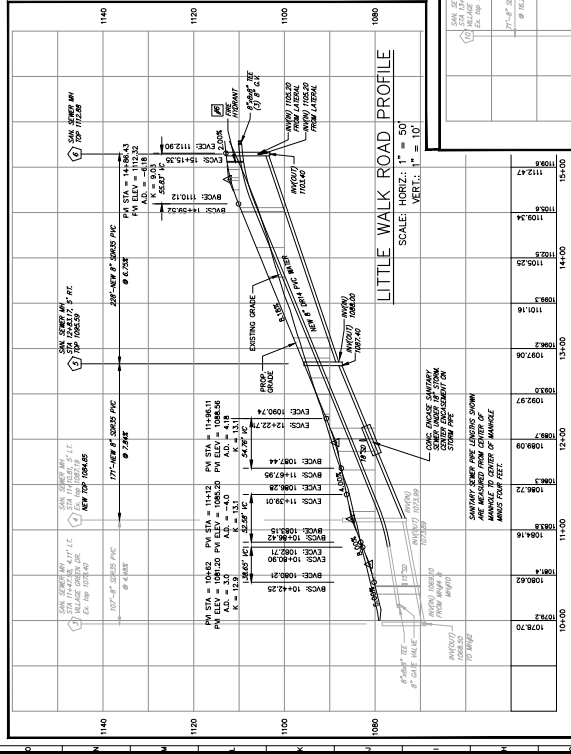


THE VILLAGE GREEN PHASE III	CAREFREE LANE	WATER & SEWER AS-BUILT PROFILES	HOLLINS DISTRICT	ROANOKE COUNTY, VIRGINIA
SCALE	DATE	CHECKED BY	DESIGNED BY	DRAWN BY
AS NOTED	11/02/2022	CPB	CPB	CPB
REVISIONS:				

SHEET NO. **AS-BUILT**