


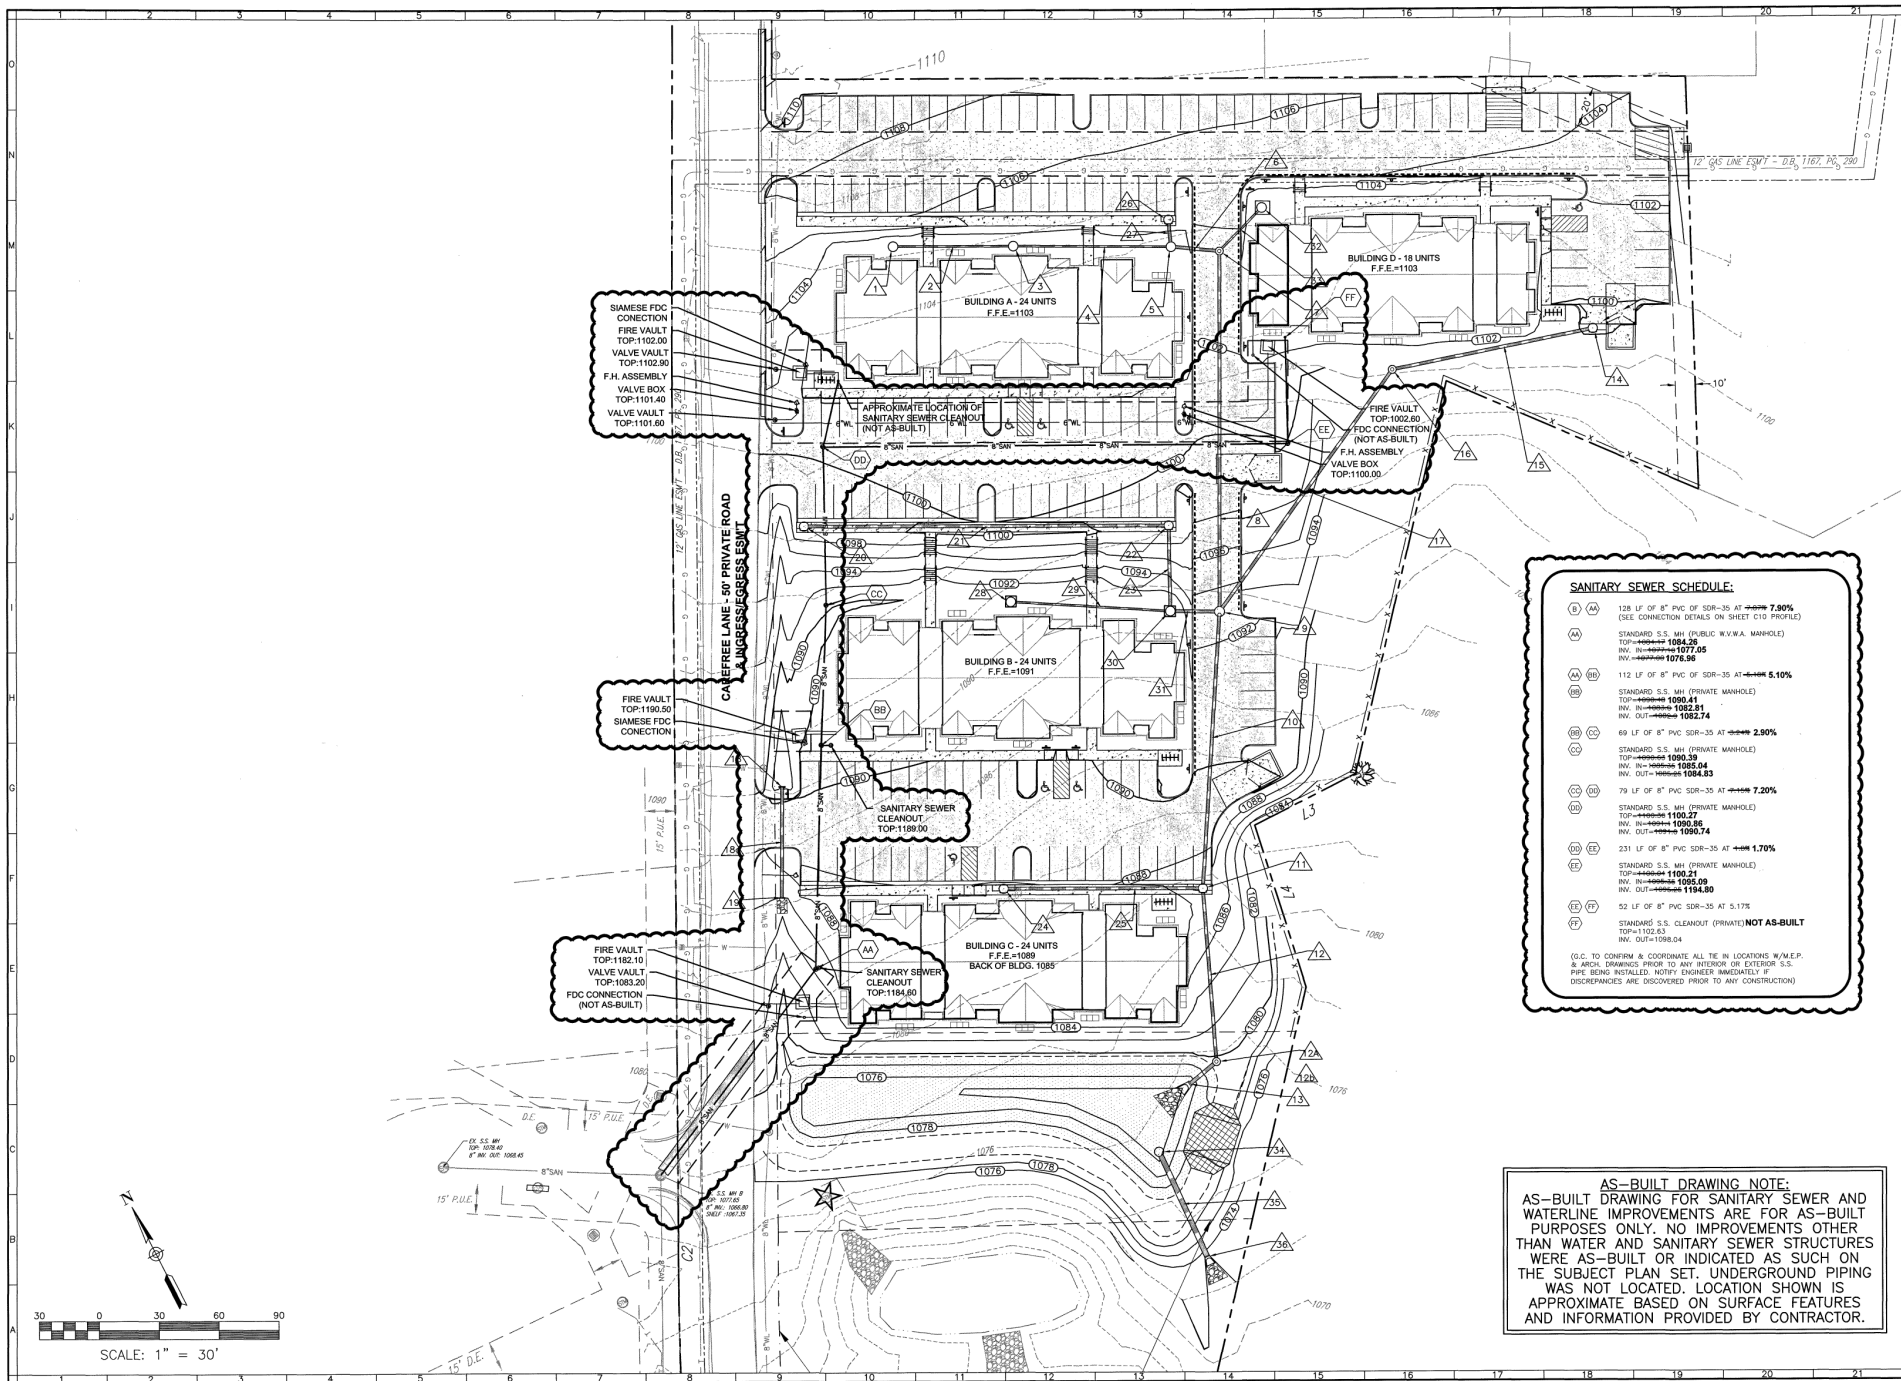

SANITARY SEWER SCHEDULE:

(B) (AA)	128 LF OF 8" PVC OF SDR-35 AT 4.00 7.90% (SEE CONNECTION DETAILS ON SHEET C10 PROFILE)
(AA)	STANDARD S.S. MH (PUBLIC W.V.A. MANHOLE) TOP= 1094.35 1094.35 INV. IN= 1077.05 1077.05 INV. OUT= 1075.95 1075.95
(AA) (BB)	112 LF OF 8" PVC OF SDR-35 AT 4.00 5.10%
(BB)	STANDARD S.S. MH (PRIVATE MANHOLE) TOP= 1090.41 1090.41 INV. IN= 1082.51 1082.51 INV. OUT= 1082.74 1082.74
(BB) (CC)	69 LF OF 8" PVC SDR-35 AT 4.00 2.90%
(CC)	STANDARD S.S. MH (PRIVATE MANHOLE) TOP= 1088.39 1088.39 INV. IN= 1085.04 1085.04 INV. OUT= 1084.83 1084.83
(CC) (DD)	79 LF OF 8" PVC SDR-35 AT 4.00 7.20%
(DD)	STANDARD S.S. MH (PRIVATE MANHOLE) TOP= 1100.27 1100.27 INV. IN= 1095.85 1095.85 INV. OUT= 1095.74 1095.74
(DD) (EE)	231 LF OF 8" PVC SDR-35 AT 4.00 1.70%
(EE)	STANDARD S.S. MH (PRIVATE MANHOLE) TOP= 1100.21 1100.21 INV. IN= 1095.09 1095.09 INV. OUT= 1194.80 1194.80
(EE) (FF)	52 LF OF 8" PVC SDR-35 AT 5.17%
(FF)	STANDARD S.S. CLEANOUT (PRIVATE) NOT AS-BUILT TOP=1102.83 INV. OUT=1098.04

(C.C. TO CONFIRM & COORDINATE ALL TIE IN LOCATIONS W/ M.E.P. & M.C.A. DRAWINGS PRIOR TO ANY INTERIOR OR EXTERIOR S.W.P. PIPE BEING INSTALLED. NOTIFY ENGINEER IMMEDIATELY IF DISCREPANCIES ARE DISCOVERED PRIOR TO ANY CONSTRUCTION)

AS-BUILT DRAWING NOTE:

AS-BUILT DRAWING FOR SANITARY SEWER AND WATERLINE IMPROVEMENTS ARE FOR AS-BUILT PURPOSES ONLY. NO IMPROVEMENTS OTHER THAN WATER AND SANITARY SEWER STRUCTURES WERE AS-BUILT OR INDICATED AS SUCH ON THE SUBJECT PLAN SET. UNDERGROUND PIPING WAS NOT LOCATED. LOCATION SHOWN IS APPROXIMATE BASED ON SURFACE FEATURES AND INFORMATION PROVIDED BY CONTRACTOR.