

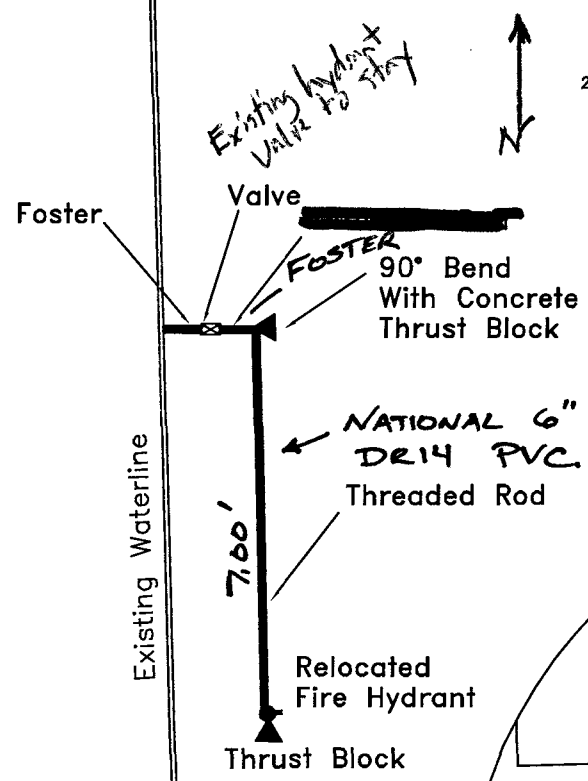
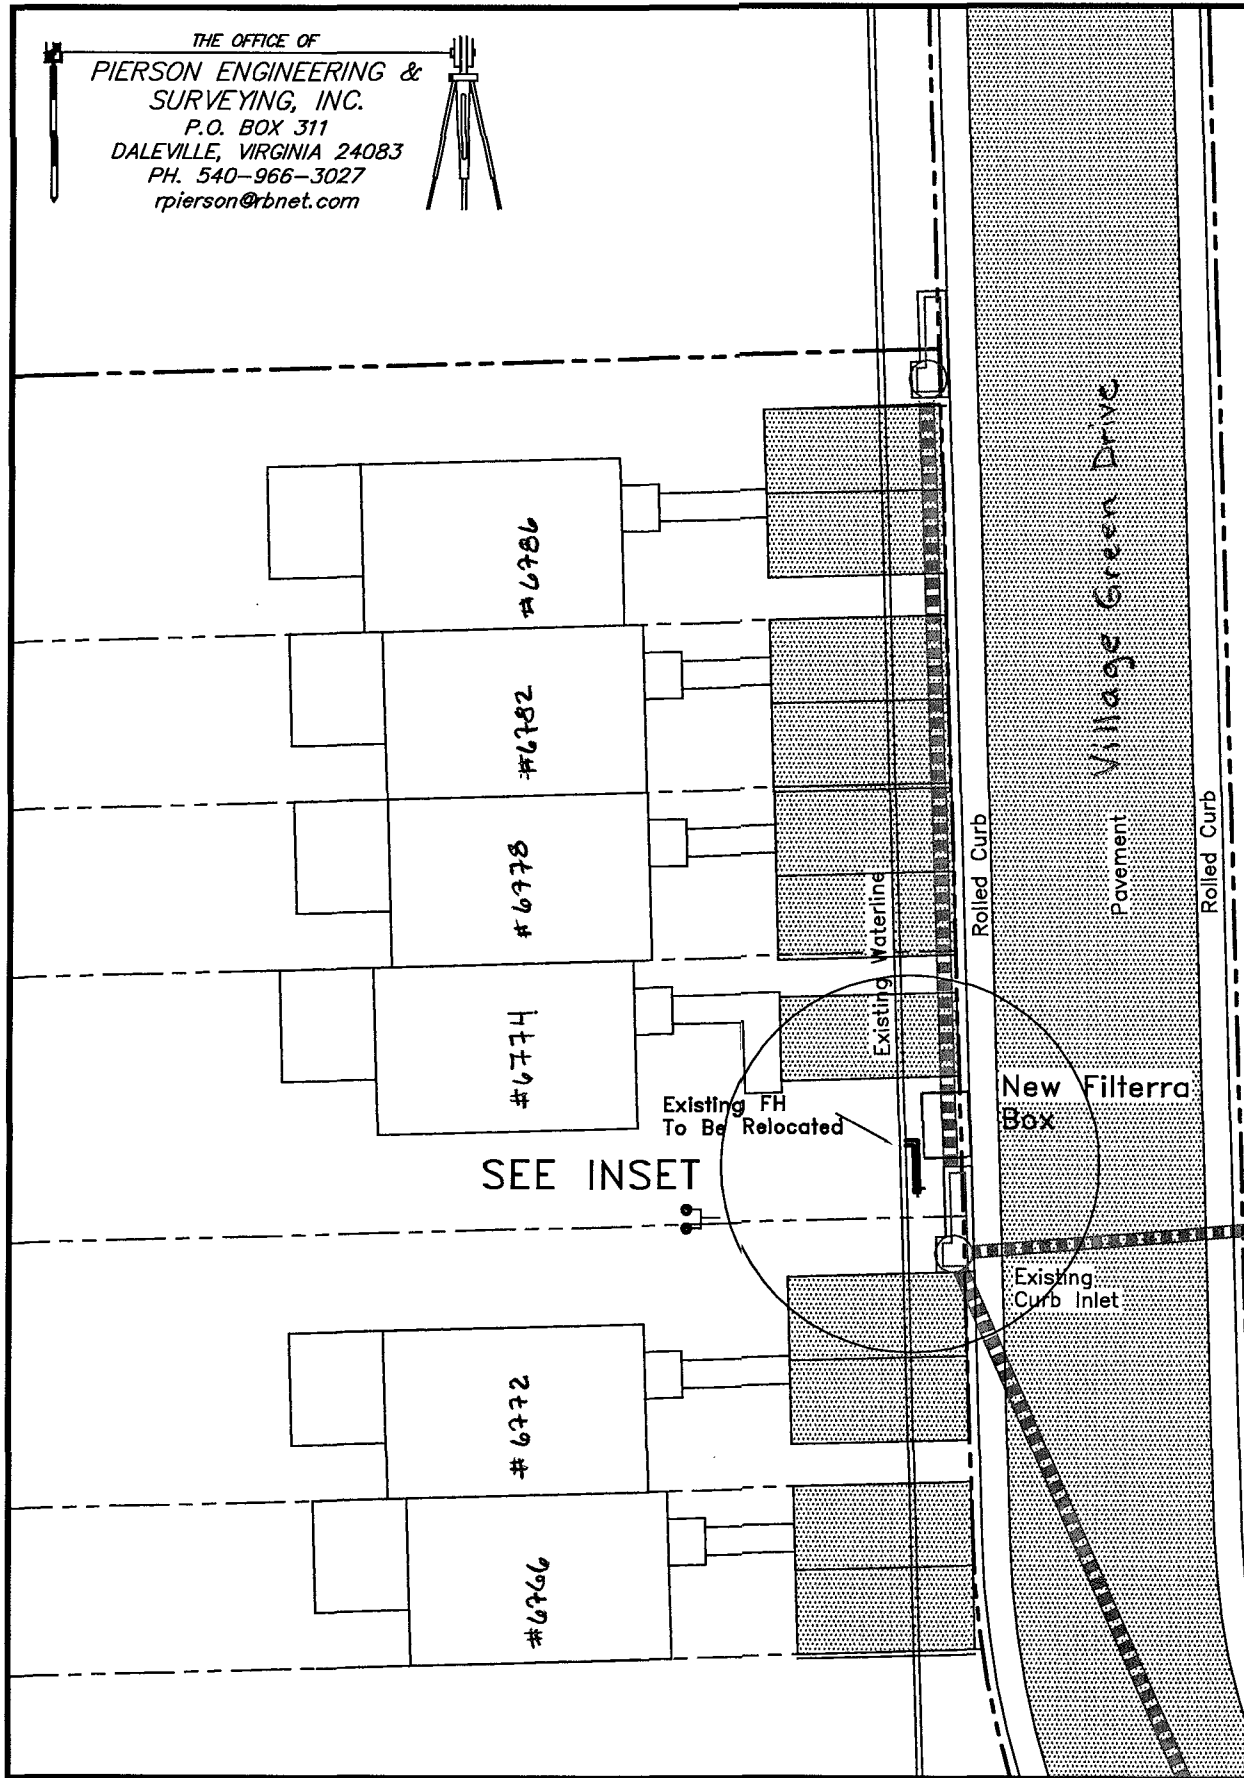


THE OFFICE OF
**PIERSON ENGINEERING &
 SURVEYING, INC.**
 P.O. BOX 311
 DALEVILLE, VIRGINIA 24083
 PH. 540-966-3027
 rpierson@bnet.com

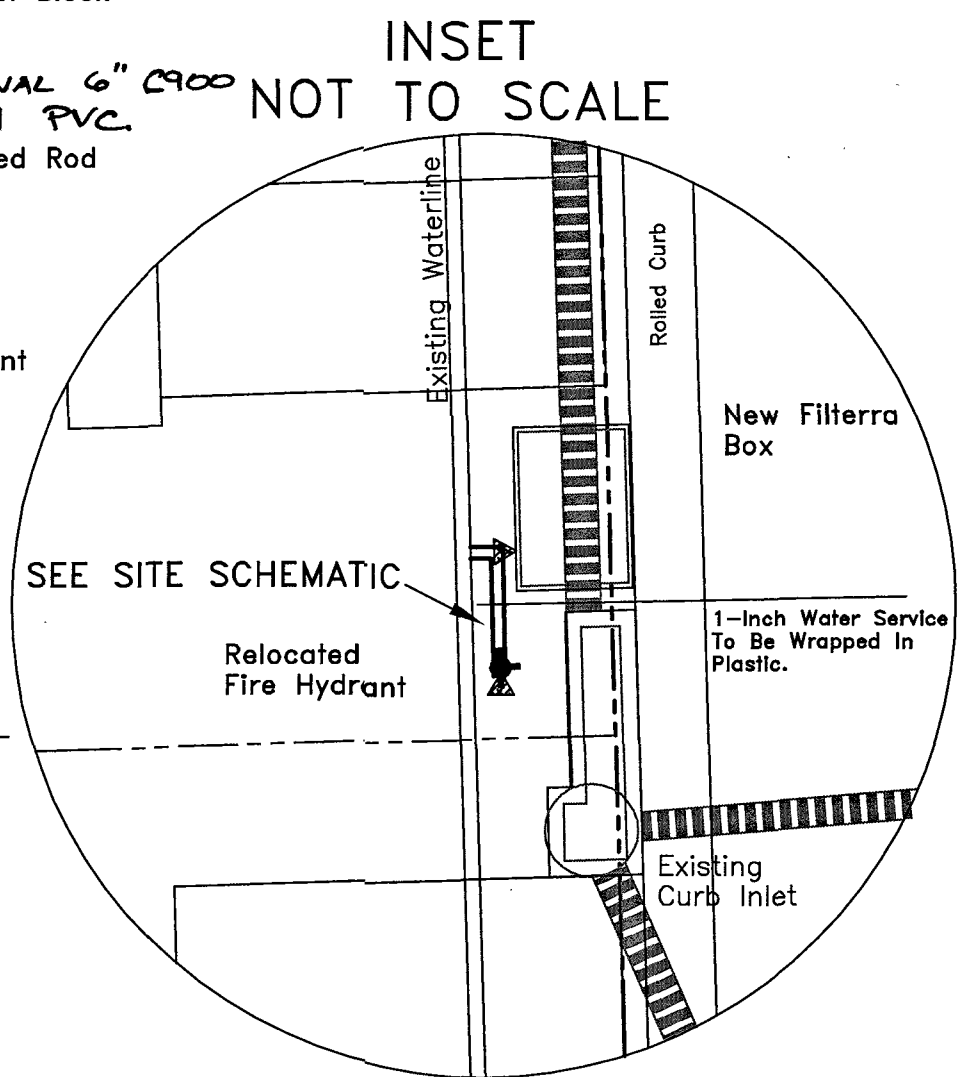

SCHEMATIC
 NOT TO SCALE
 * FIRE HYDRANT # 20509

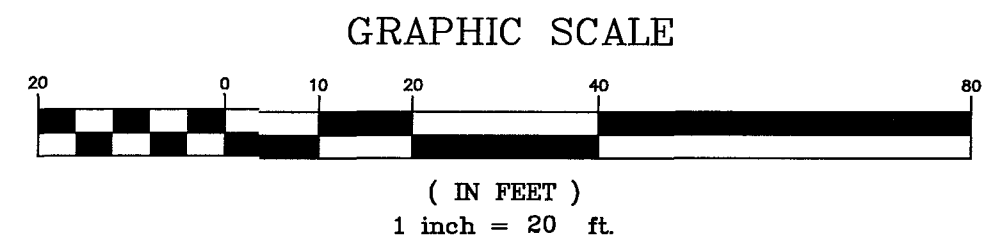

COMMONWEALTH OF VIRGINIA
 11/06/2017
 RODERICK F. PIERSON
Roderick Pierson
 LICENSE NO. 1969
 LAND SURVEYOR

Fire Hydrant Replacement Sketch
 For
 Village Green Subdivision
 November 6, 2017

sheet 2 of 2

AS-BUILT
 CHARLES CRUSH
 11-13-17