

DITCH DESIGN SUMMARY TABLE													
DITCH ID	DESIGN FLOW Q2 (CFS)	DESIGN FLOW Q10 (CFS)	BOTTOM WIDTH (FT)	CHANNEL DEPTH (FT)	SIDE SLOPE L/R (H:1)	CHANNEL SLOPE (MIN) (%)	CHANNEL SLOPE (MAX) (%)	DESIGN FLOW VELOCITY Q2 (FPS)	DESIGN FLOW DEPTH Q10 (FT)	TEMPORARY LINING MATERIAL	PERMANENT LINING MATERIAL	MANNINGS "N" PERMANENT LINING	NOTES:
A	2.80	3.94	1.0	1.25	3/3	2.00	2.00	2.74	0.44	EC-2	GRASS	0.032	1.
B	1.30	1.80	0.0	1.00	2/4	3.30	3.30	2.76	0.45	EC-2	GRASS	0.032	1.
C-1	4.6	6.7	4.0	2.00	2/2	2.50	2.50	3.10	0.40	EC-2	GRASS	0.032	1.
C-2	4.6	6.7	4.0	2.00	2/2	7.50	12.5	3.17	0.42	CLASS 1 RIP-RAP (T = 24")	CLASS 1 RIP-RAP (T = 24")	0.069	3,000
NOTES:													
1. CHANNEL SHALL BE LINED WITH SOIL STABILIZATION BLANKETS AND MATTING IN ACCORDANCE WITH STD. AND SPEC. 3.36, TREATMENT - 1, VDOT EC-2													
2. CHANNEL SHALL BE LINED WITH SOIL STABILIZATION BLANKETS AND MATTING IN ACCORDANCE WITH STD. AND SPEC. 3.36, TREATMENT - 1, VDOT EC-3, TYPE B.													
3. CHANNEL SHALL BE LINED WITH RIP-RAP TO THE CROSS-SECTION AND DEPTH AS INDICATED IMMEDIATELY UPON EXCAVATION OF CHANNEL.													

NOTES:
1. CHANNEL SHALL BE LINED WITH SOIL STABILIZATION BLANKETS AND MATTING IN ACCORDANCE WITH STD. AND SPEC. 3.36, TREATMENT - 1, VDOT EC-2
2. CHANNEL SHALL BE LINED WITH SOIL STABILIZATION BLANKETS AND MATTING IN ACCORDANCE WITH STD. AND SPEC. 3.36, TREATMENT - 1, VDOT EC-3, TYPE B
3. CHANNEL SHALL BE LINED WITH RIP-RAP TO THE CROSS-SECTION AND DEPTH AS INDICATED IMMEDIATELY UPON EXCAVATION OF CHANNEL.

[illegible]

ELLIPTICAL PIPE

1. S_1 = OUTSIDE SPAN DIMENSION OF PIPE.
2. S_2 = INSIDE SPAN DIMENSION OF PIPE.
3. R = OUTSIDE RISE DIMENSION OF PIPE.
4. X = WIDTH OF CLASS I BACKFILL MATERIAL BEYOND THE EXTREMITY OF THE PIPE.
 $X = 12"$ WHEN S_2 IS LESS THAN $36"$.
 $X = 18"$ WHEN S_2 IS $36"$ OR LESS.
5. WHEN DIRECTED BY THE ENGINEER, REDDING MATERIAL MAY BE ELIMINATED FOR UNIFORMS, UNDER ROUTINE ENTRANCE PIPE WHERE S_2 IS $36"$ OR LESS AND HEIGHT OF COVER $30"$ OR LESS.
6. REGULAR BACKFILL MATERIAL MAY BE USED IN LIEU OF CLASS I BACKFILL MATERIAL FOR ALL ALLEGATIONS OF UNIFORMS, UNDER ROUTINE ENTRANCE PIPE WHERE S_2 IS $36"$ OR LESS AND HEIGHT OF COVER $30"$ OR LESS.

PIPE ARCH

1. S = SPAN DIMENSION OF PIPE.
2. R = RISE DIMENSION OF PIPE.
3. B = SEE PG-1 TABLE FOR APPLICABLE PIPE MATERIAL.
4. 1 = WIDTH OF CLASS I BACKFILL MATERIAL BEYOND THE EXTREMITY OF THE PIPE.
 $x = 12"$ WHERE S_2 IS LESS THAN 36"
 $x = 18"$ WHERE S_2 IS 36" AND GREATER
5. WHERE DIRECTED BY THE ENGINEER, BEDDING MATERIAL MAY BE ELIMINATED FOR NORMAL EARTH FOUNDATIONS UNDER ROUTINE ENTRANCE PIPE WHERE S_2 IS 36" OR LESS AND HEIGHT OF COVER 10' OR LESS.
6. REGULAR BACKFILL MATERIAL MAY BE USED IN LIEU OF CLASS I BACKFILL MATERIAL FOR ROUTINE TYPES OF FOUNDATIONS UNDER ROUTINE ENTRANCE PIPE WHERE S IS 36" OR LESS AND HEIGHT OF COVER 10' OR LESS.

INSTALLATION OF PIPE CULVERTS & STORM SEWERS

GENERAL NOTES

VIRGINIA DEPARTMENT OF TRANSPORTATION

[illegible]

NOTE: CLASS I BACKFILL SHALL BE CRUSHER RUN
AGGREGATE SIZE NO. 25 OR 26, AGGREGATE BASE
MATERIAL SIZE 21A OR 21B, FLOWABLE FILL, OR
CRUSHED GLASS CONFORMING TO THE SIZE REQUIRED
FOR CRUSHER RUN AGGREGATE SIZE 25 AND 26.

INSTALL. OF PIPE CULVERTS AND STORM SEWERS
CIRC. PIPE BEDDING AND BACKFILL - METHOD "A"
VIRGINIA DEPARTMENT OF TRANSPORTATION

NOTES:
FOR GENERAL NOTES ON PIPE BEDDING
SEE INSTALLATION OF PIPE CULVERTS
AND STORM SEWERS GENERAL NOTES
ON SHEET 107.00.

CRUSHED GLASS CONFORMING TO THE
SIZE REQUIREMENTS FOR CRUSHER RUN
AGGREGATE SIZE 25 AND 26 MAY BE
USED IN PLACE OF CLASS 1 BACKFILL.


STORM DRAINAGE GENERAL NOTES:

1. STORM DRAINAGE PIPE AND DRAINAGE STRUCTURES SHALL COMPLY WITH ALL APPLICABLE VDOT STANDARDS AND SPECIFICATIONS. REFER TO "INSTALLATION OF PIPE CULVERTS & STORM SEWER GENERAL NOTES" AND DETAILS SHOWN ON VDOT STD. PB-1 ON THIS SHEET FOR ADDITIONAL INFORMATION.
2. THE INVERT OF ALL NEW STORM DRAINAGE INLETS AND MANHOLES SHALL CONFORM TO VDOT STD. IS-1 - "STANDARD METHOD OF SHAPING MANHOLE AND INLET INVERTS." REFER TO DETAIL ON THIS SHEET.
3. ALL CONNECTIONS BETWEEN STORM DRAIN LINE (RCP) AND ROOF DRAIN LINE (PVC) SHALL BE ACCOMPLISHED BY USING "KOR-N-TEE" OR "KOR-N-TEE SADDLE" PIPE-TO-PIPE WATER-TIGHT CONNECTORS AS MANUFACTURED BY TRELLEBORG PIPE SEALS MILFORD, INC.
4. STORM DRAIN PIPE LENGTHS SHOWN HEREON ARE APPROXIMATE HORIZONTAL DISTANCES FROM CENTER OF STRUCTURE TO CENTER OF STRUCTURE. PIPE SLOPES SHOWN ARE COMPUTED USING INVERT OUT AT UPSTREAM STRUCTURE, INVERT IN AT DOWNSTREAM STRUCTURE, AND HORIZONTAL PIPE LENGTH MEASURES FROM CENTER OF STRUCTURE TO CENTER OF STRUCTURE.
5. UPON COMPLETION OF THE STORM DRAINAGE SYSTEM, THE CONTRACTOR SHALL FURNISH TO THE OWNER A FIELD SURVEYED FINAL CORRECT SET OF AS-BUILT PLANS OF THE NEWLY CONSTRUCTED STORM DRAIN AND/OR STORMWATER MANAGEMENT FACILITIES. AS-BUILT PLANS SHALL BE PROVIDED IN THE STATE PLANE VIRGINIA SOUTH COORDINATE SYSTEM, NAD 1983, FIPS 4502 FEET, US SURVEY FEET, DATUM NA 83, IN THE FORM OF 1 PAPER COPY AND 1 DIGITAL AUTOCAD FILE.


STORM DRAINAGE PROFILE KEYNOTES:

- 1 CUT-OFF TRENCH AND ANTI-SEEP BACK-FILL PLUGS (CLAY DAMS) WHERE SHOWN. CUT-OFF TRENCH TO EXTEND 1-FOOT INTO NATIVE SOIL. SHALL BE 2-FEET WIDE, AND EXTEND FULL WIDTH OF TRENCH. SEE DETAIL THIS SHEET.
- 2 WATER TIGHT PIPE JOINTS AND MANHOLE CONNECTION SHALL BE USED IN THIS SECTION OF STORM DRAINAGE. WATER-TIGHT PIPE JOINTS SHALL CONFORM TO ASTM C76 AND ASTM C443 AND SHALL BE MANUFACTURED WITH AN OFF-SET SPIGOT CONFIGURATION AND SHALL USE TYPE 46 PROFILE PIPE GASKETS AS MANUFACTURED BY PRESS-SEAL GASKET CORPORATION, OR APPROVED EQUAL. REFER TO DETAIL ON SHEET C-10A FOR MORE INFORMATION.
- 3 WATER TIGHT PIPE-TO-MANHOLE CONNECTIONS SHALL BE MADE WITH FULLY GROUTED CONNECTION WITH PLACEMENT OF FULL-DEPTH NON-SHRINK GROUT / HYDRAULIC CEMENT ON THE INSIDE AND OUTSIDE OF THE MANHOLE CONNECTION.
- 4 CAST OPENING FOR FUTURE 18" DIA. RCP. SEAL/COVER WITH PLYWOOD SHEET PRIOR TO BACKFILLING.

**NOTE: CONTRACTOR SHALL SUBMIT STORM DRAINAGE
STRUCTURE FABRICATION ORDER SHEETS TO
ENGINEER FOR REVIEW AND APPROVAL PRIOR TO
START OF FABRICATION.**

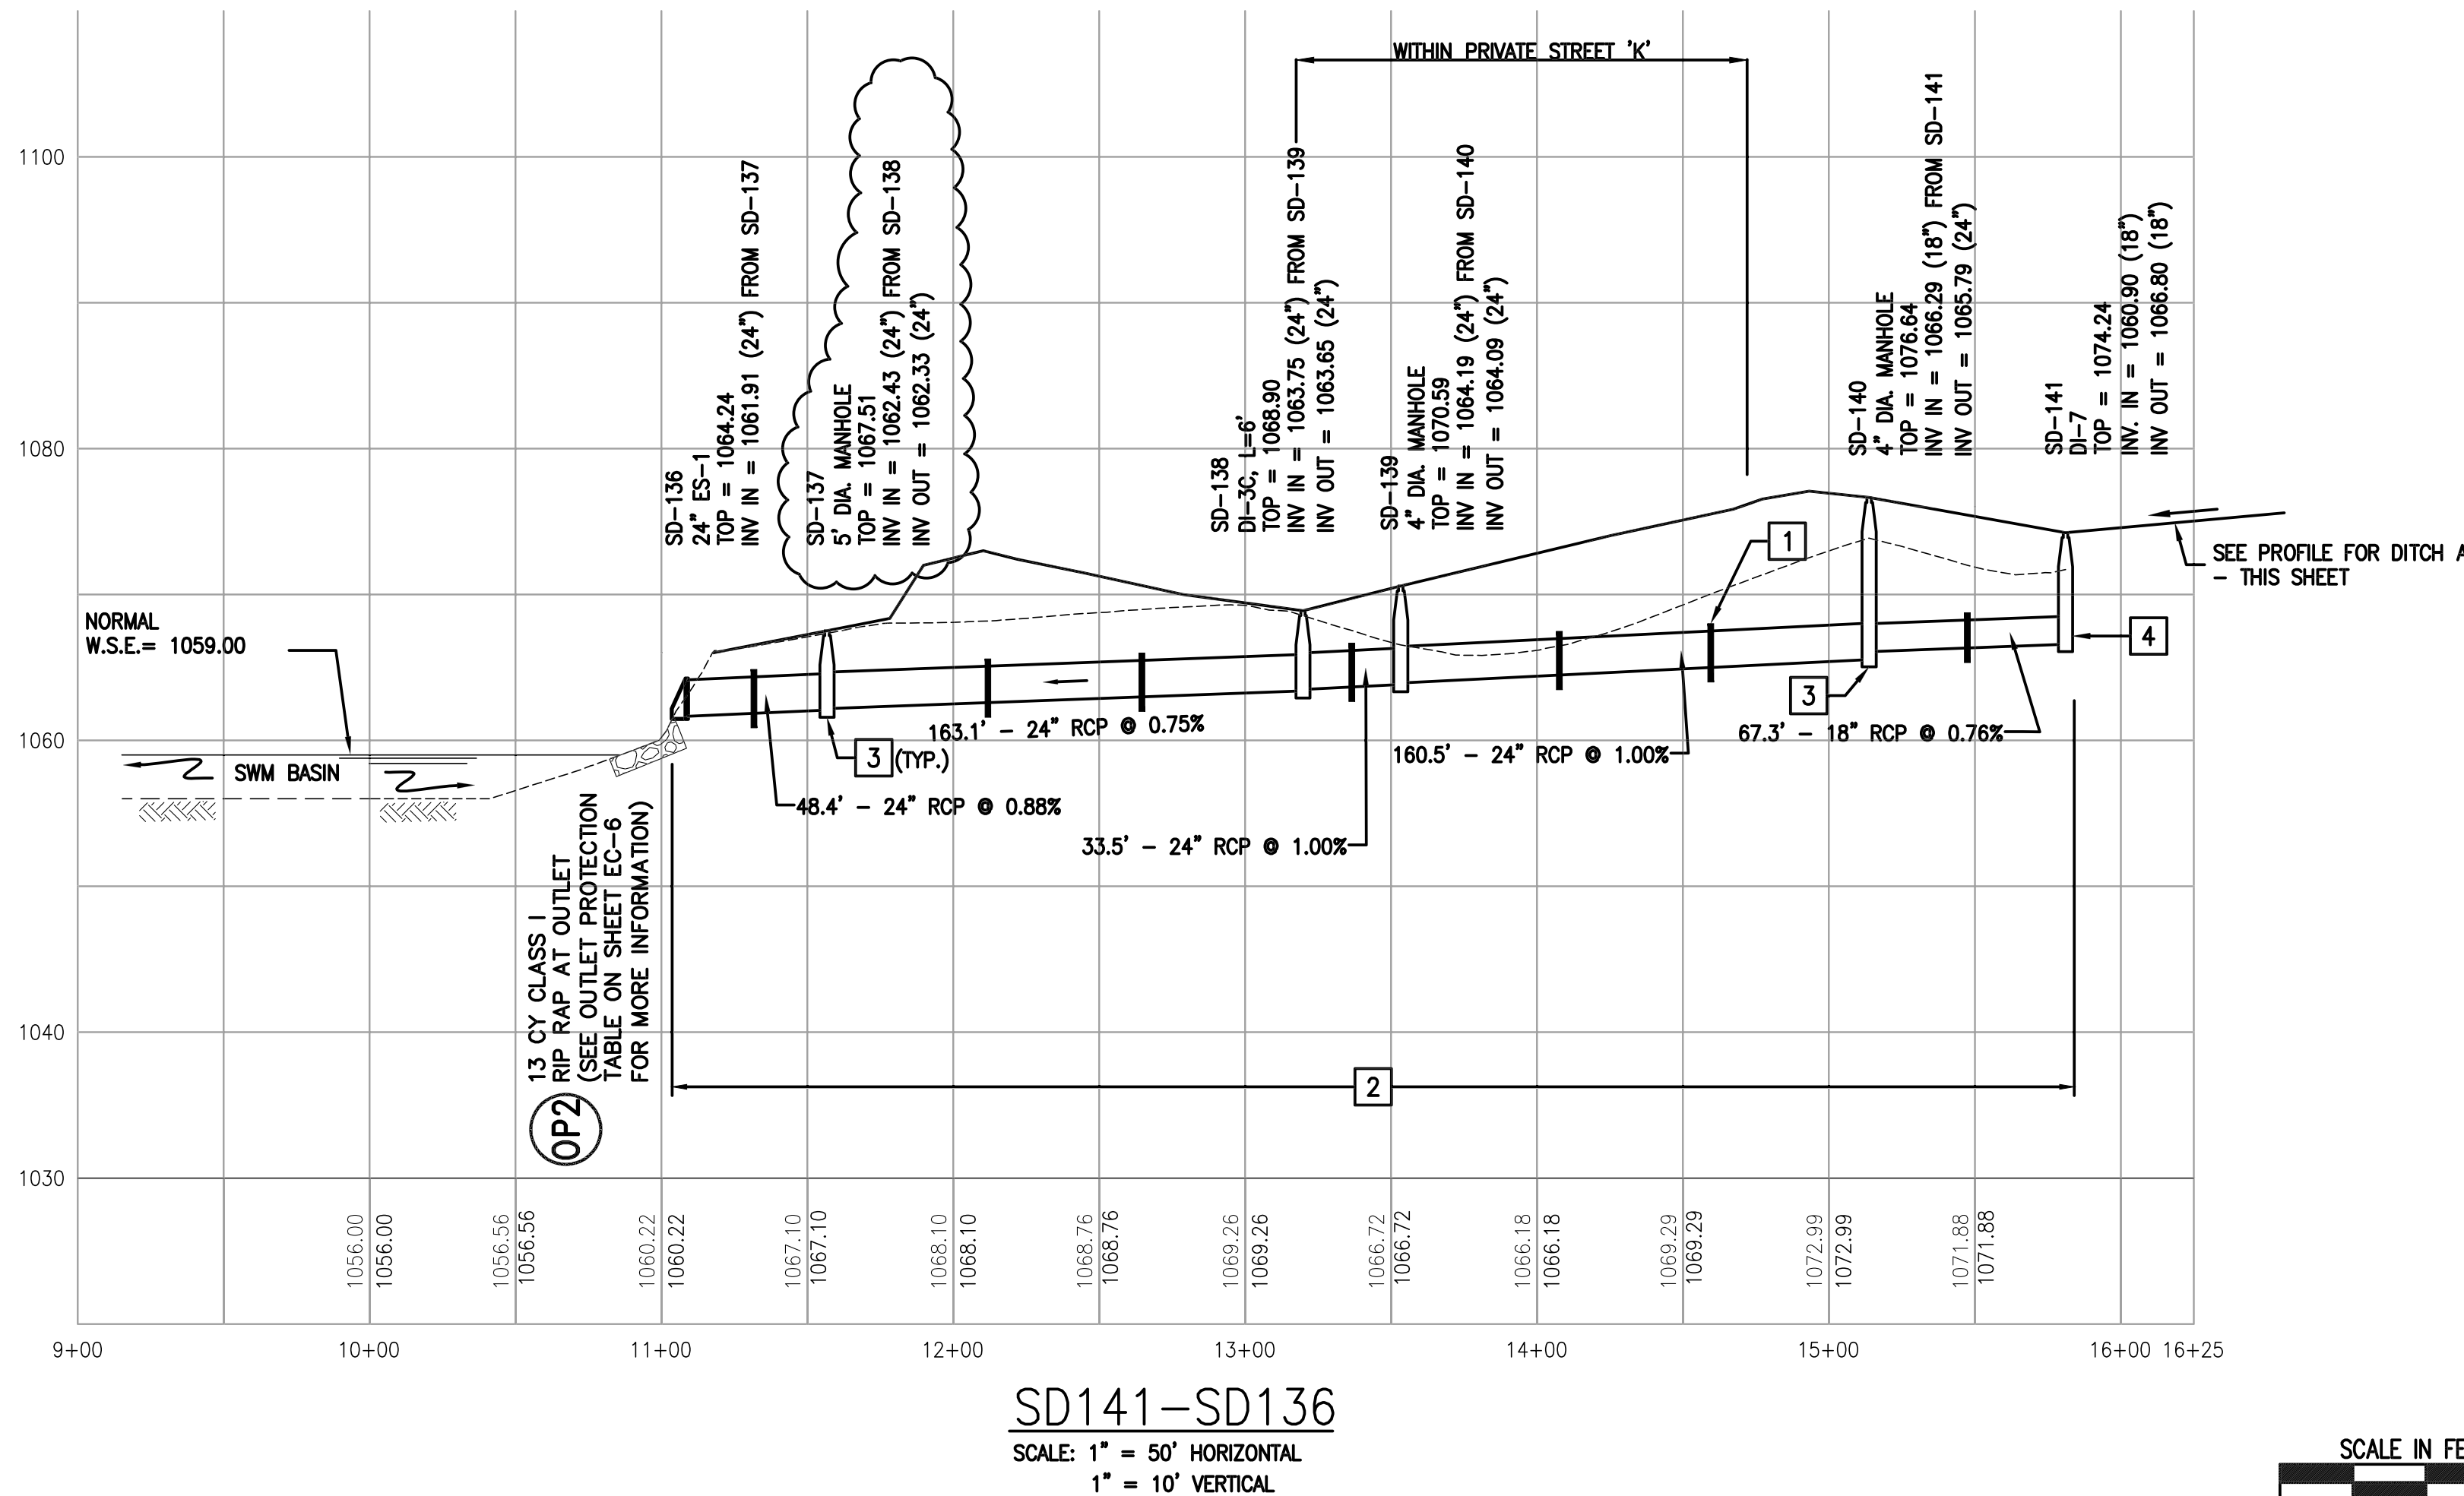

APPROVED, 4/14/2020

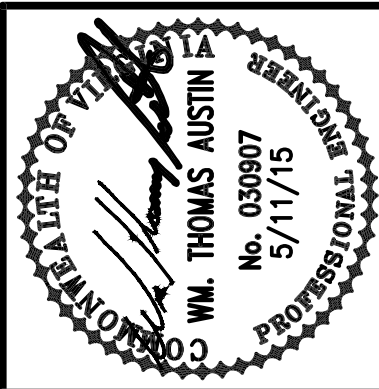

Issue Date: MAY 11, 2015		Revisions		Date
1	1ST REVIEW COMMENTS			7/17/15
2	APPROVED SET			9/4/15
3	PLAN REVISION NO. 1			7/21/17
Designed By: RWA				
Checked By: WTK				
Date: 5/11/15				

Mattern & Craig
ENGINEERS•SURVEYORS

701 FIRST STREET, S.W.
ROANOKE, VIRGINIA 24016
(540) 345-9342
FAX (540) 345-7891

THE VILLAGE AT TINKER CREEK – PHASE IIIA

PROFILES – STORM DRAINAGE

ROANOKE COUNTY, VIRGINIA

Vertical Scale:
1" = 10'

Horizontal Scale:
1" = 50'

Commission Number:
1966-P3

Sheet No.:

C-10