
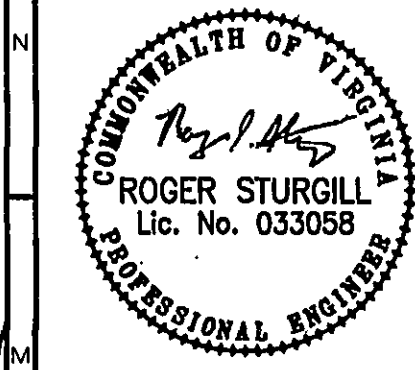


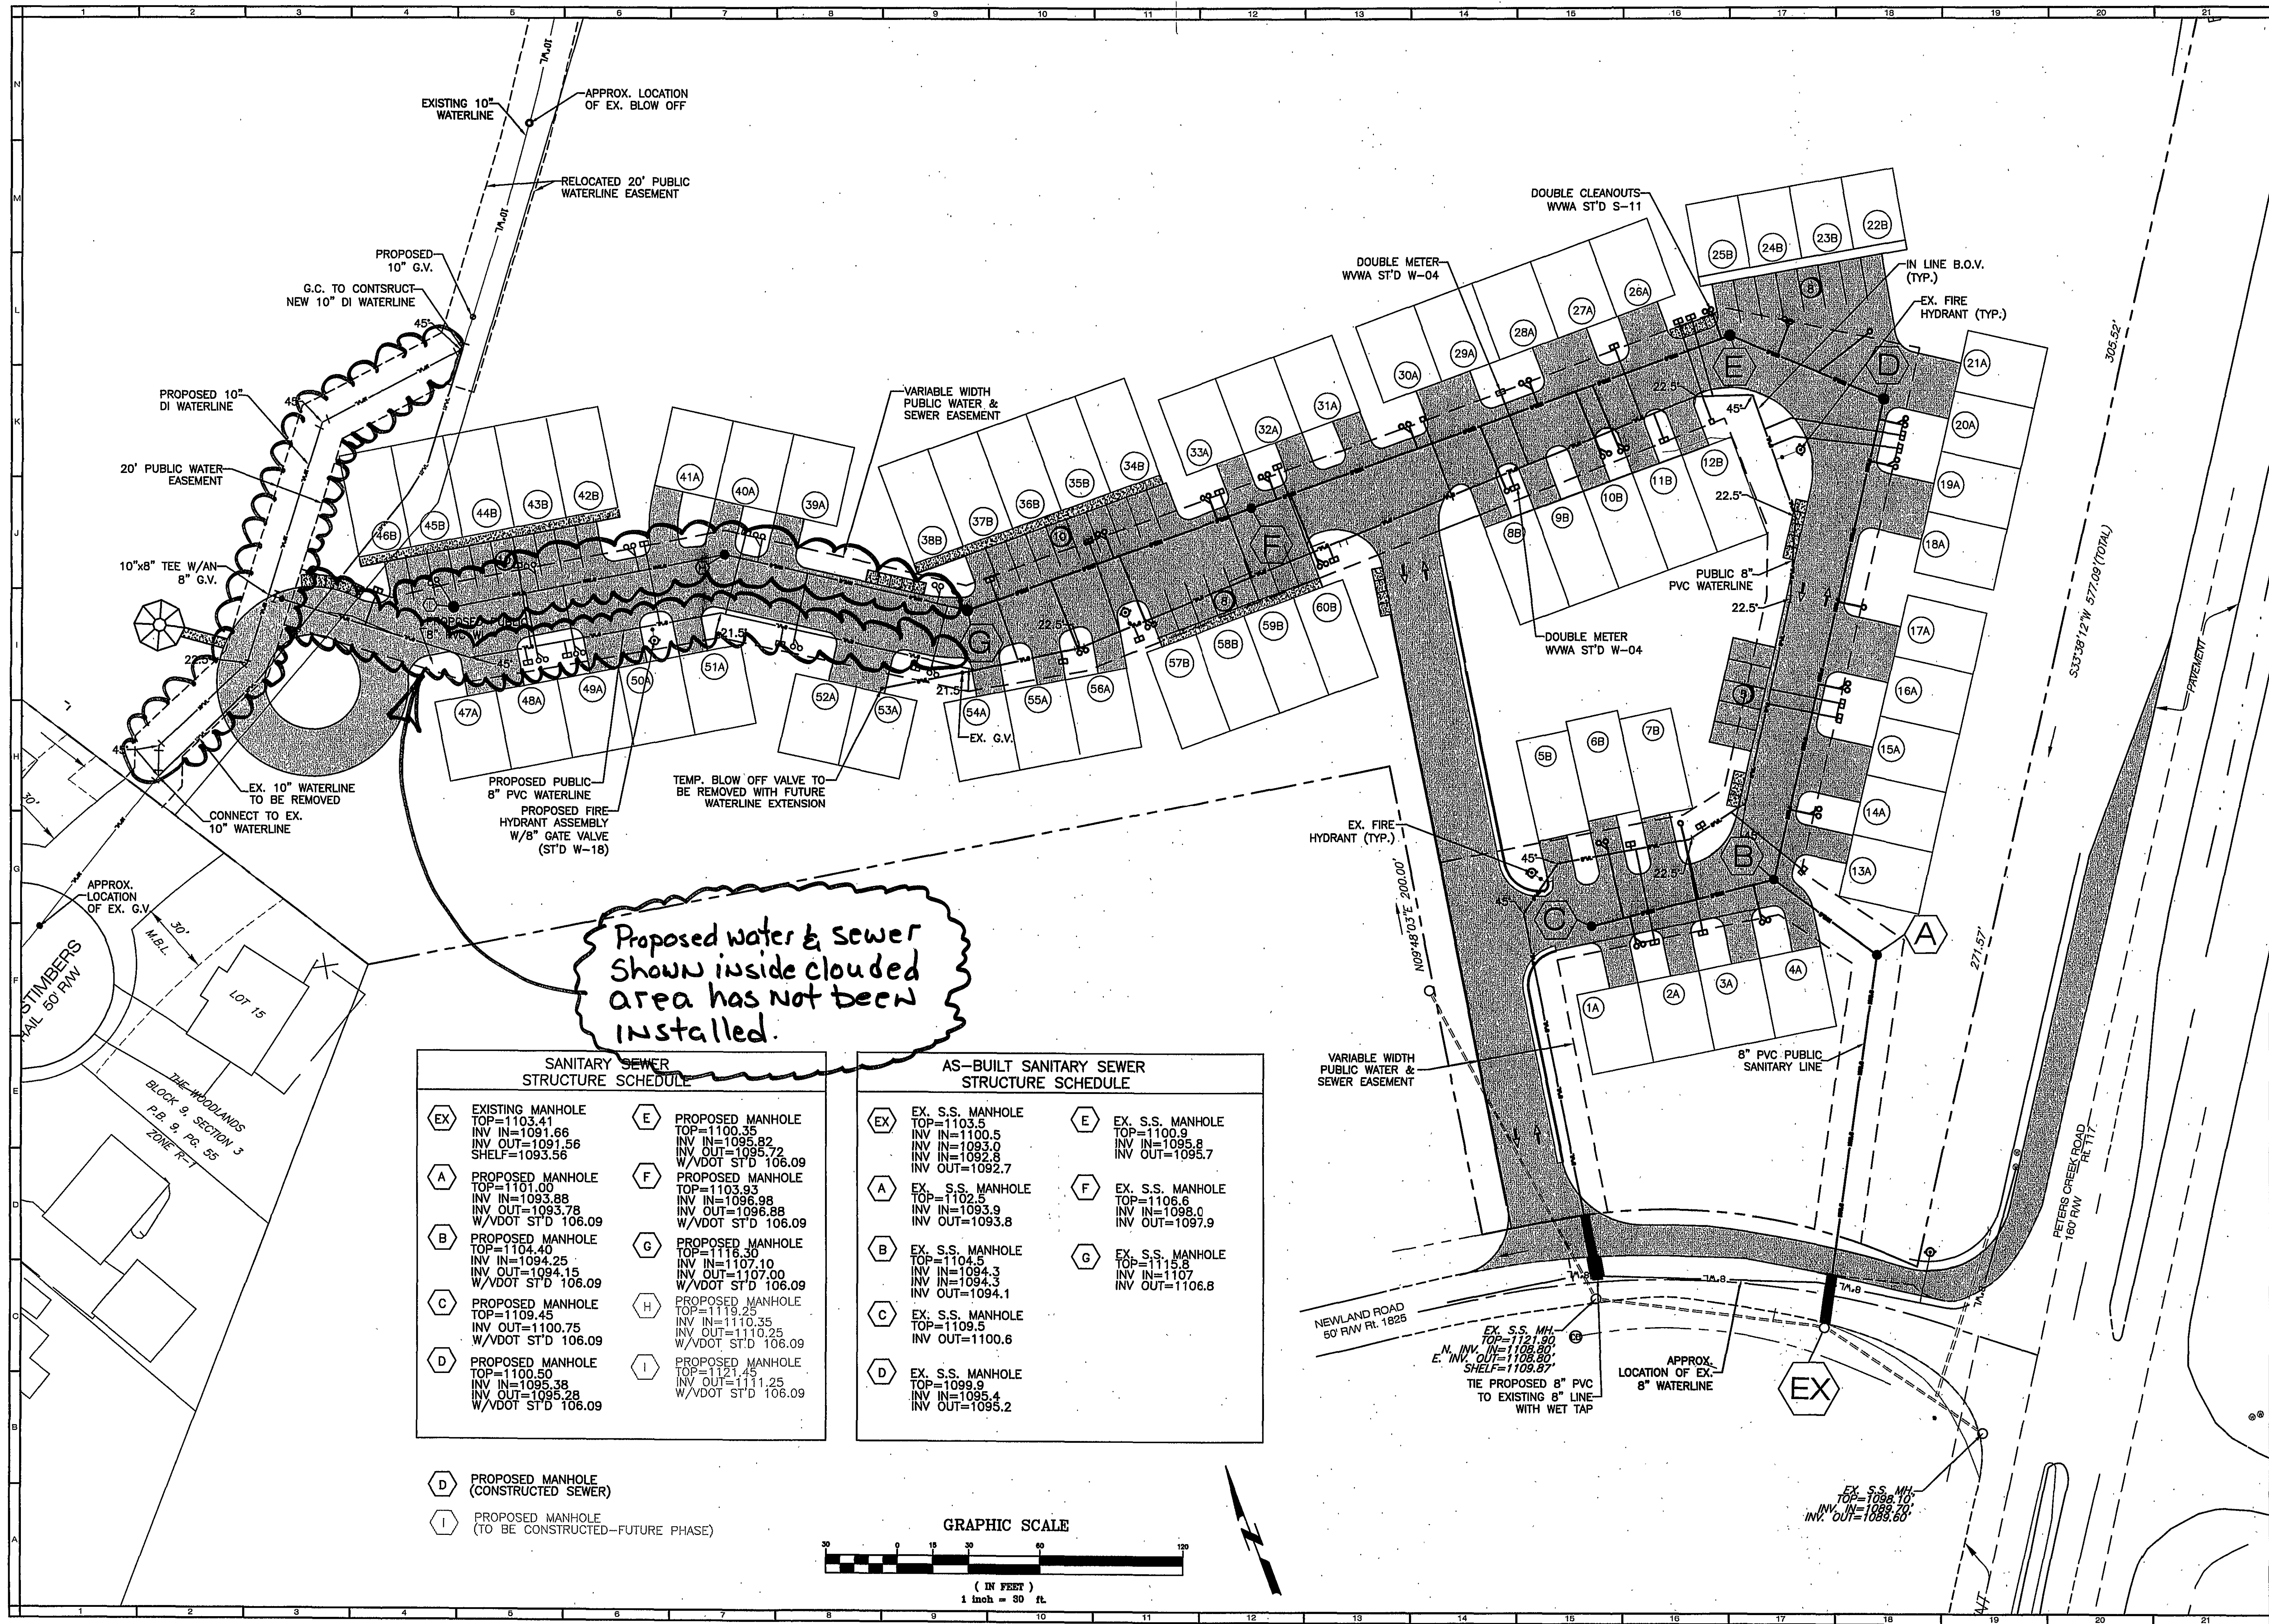

BALZER
AND ASSOCIATES, INC.
REFLECTING TOMORROW
www.balzer.cc
PLANNERS • ARCHITECTS
ENGINEERS • SURVEYORS

1208 Corporate Circle
Roanoke, Virginia 24018
Phone: 540/772-9580
FAX: 540/772-9050

18871 City View Drive
Suite 200
Glenn Allen, Virginia 23069
Phone: 804/784-0271
FAX: 804/784-2855

880 Technology Park Drive
Suite 200
Glenn Allen, Virginia 23069
Phone: 804/653-0192
FAX: 804/653-0193

448 Peppers Ferry Road, NW
Chattanooga, Virginia 24073
Phone: 840/881-4220
FAX: 840/881-4281

1681 Commerce Road
Suite 401
Verona, Virginia 24482
Phone: 840/248-0220
FAX: 840/248-3221

VILLAS OF THE VALLEY
SANITARY SEWER & WATER AS-BUILT
ROANOKE COUNTY, VIRGINIA

DRAWN BY: BTC
DESIGNED BY: SMH
CHECKED BY: SMH
DATE: 10-28-08
REVISIONS:

SCALE: 1"=30'
SHEET NO.
EX 'A'
JOB NO.
R0500134.01