


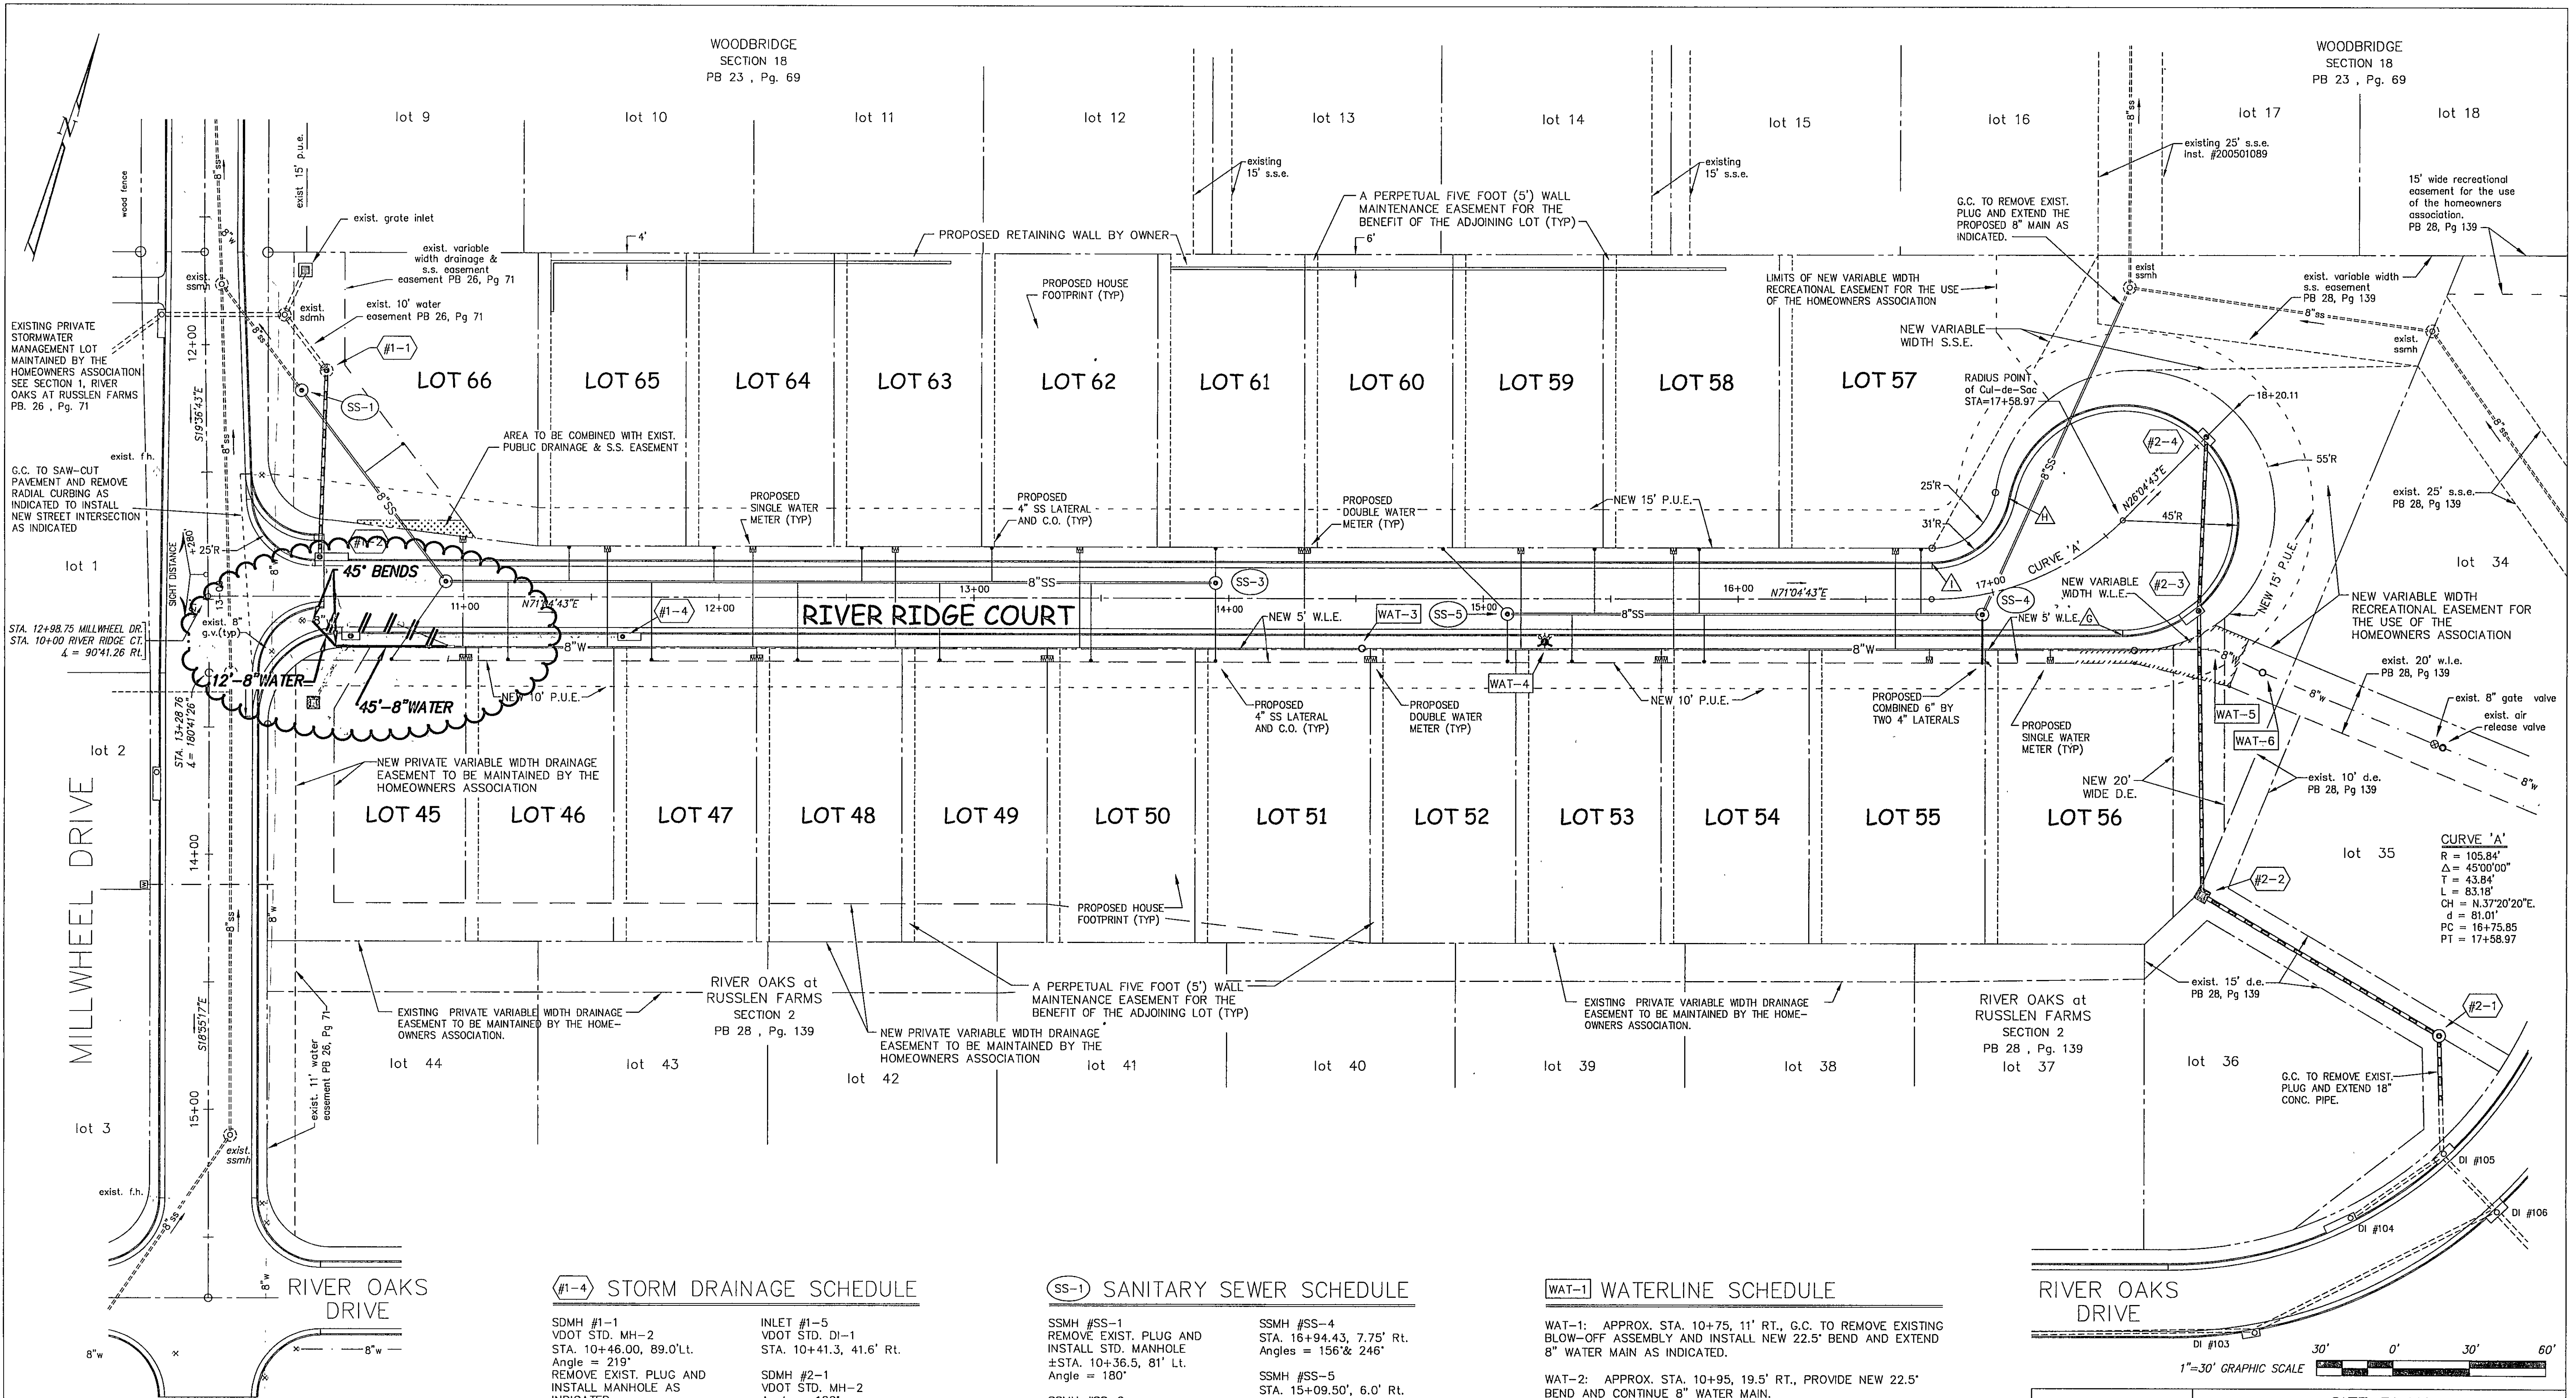

CRITICAL CONSTRUCTION LOCATIONS

PT 'A'	STA. 10+41.88, 14.00' LT	END OF RADIAL CURBING
PT 'B'	STA. 10+52.36, 14.00' RT	END OF RADIAL CURBING
PT 'C'	STA. 17+34.93, 35.45' RT	BEGIN RADIAL CURBING
PT 'H'	STA. 17+21.48, 32.59' LT	PT. OF REVERSE CURVES
PT 'I'	STA. 16+75.85, 14.00' LT	BEGIN RADIAL CURBING

STORM DRAINAGE SCHEDULE

SDMH #1-1 VDOT STD. MH-2 STA. 10+46.00, 89.0' LT. Angle = 219° REMOVE EXIST. PLUG AND INSTALL MANHOLE AS INDICATED.	INLET #1-5 VDOT STD. DI-1 STA. 10+41.3, 41.6' RT.
SDMH #2-1 VDOT STD. MH-2 Angle = 122°	INLET #2-2 VDOT STD. DI-7 TYPE III GRATE Angle = 239°
INLET #1-2 VDOT STD. DI-3B THROAT = 10' STA. 10+43.71, 15.5' LT. Angle = 159°	INLET #2-3 VDOT STD. DI-3B THROAT = 14' STA. 17+56.20, 46.23' RT. Angle = 183°
INLET #1-3 VDOT STD. DI-3C THROAT = 8' STA. 10+55.86, 15.5' RT. Angles = 111° & 231°	INLET #2-4 VDOT STD. DI-3C THROAT = 6' STA. 18+05.33, 0.0' RT.
INLET #1-4 VDOT STD. DI-3B THROAT = 8' STA. 11+62.25, 15.5' RT.	

SANITARY SEWER SCHEDULE

SSMH #SS-1 REMOVE EXIST. PLUG AND INSTALL STD. MANHOLE ± STA. 10+36.5, 81' LT. Angle = 180°	SSMH #SS-4 STA. 16+94.43, 7.75' RT. Angles = 156° & 246°
SSMH #SS-2 STA. 10+93.03, 6.0' LT. Angles = 127° & 252°	SSMH #SS-5 STA. 15+09.50, 6.0' RT. Angles = 90° & 225°
SSMH #SS-3 STA. 13+94.83, 6.0' LT. Angles = 90° & 180°	

G.C. SHALL REFER TO THE SANITARY SEWER MANHOLE AND CLEANOUT INFORMATION PROVIDED ON SHT. C-10. THIS INFORMATION PROVIDES APPROXIMATE CLEANOUT ELEVATIONS AND MINIMUM FINISH FLOOR ELEVATIONS NECESSARY TO UTILIZE A GRAVITY LATERAL SERVICE.

WATERLINE SCHEDULE

WAT-1: APPROX. STA. 10+75, 11' RT., G.C. TO REMOVE EXISTING BLOW-OFF ASSEMBLY AND INSTALL NEW 22.5' BEND AND EXTEND 8" WATER MAIN AS INDICATED.	WAT-2: APPROX. STA. 10+95, 19.5' RT., PROVIDE NEW 22.5' BEND AND CONTINUE 8" WATER MAIN.
WAT-3: APPROX. STA. 14+52.5, 19.5' RT., PROVIDE AIR RELEASE VALVE AT INSTALLED HIGH POINT.	WAT-4: APPROX. STA. 15+25, 45.4' RT, PROVIDE FIRE HYDRANT ASSEMBLY
WAT-5: APPROX. STA. 17+52, 61.1' RT., PROVIDE 22.5' BEND AS REQUIRED FOR HORIZONTAL AND VERTICAL ALIGNMENTS.	WAT-6: G.C. TO REMOVE EXIST. TEMP. BLOW-OFF AND INSTALL NEW IN-LINE BLOW-OFF ASSEMBLY AND A 22.5' BEND AS REQUIRED FOR VERTICAL ALIGNMENT AND EXTEND THE PROPOSED 8" MAIN AS INDICATED.

WATERLINE AS-BUILTS FROM DRAWINGS PROVIDED BY THE CONTRACTOR

COMMONWEALTH OF VIRGINIA
FRANK B. CALDWELL, III
NO. 9184
PROFESSIONAL ENGINEER

SITE PLAN
THE VILLAS AT RIVER OAKS
SITUATE OFF OF MILLWHEEL DRIVE
CATAWBA MAGISTERIAL DISTRICT
ROANOKE COUNTY, VIRGINIA

CWA
CALDWELL WHITE ASSOCIATES
ENGINEERS / SURVEYORS / PLANNERS
4203 MELROSE AVENUE, N.W.
Post Office Box 6260
ROANOKE, VIRGINIA 24017
Telephone: (540) 366-3400 • Fax: (540) 366-0702
EMAIL: CWAROANOKE@AOL.COM

Designed: J.V. Judy
Checked: F.B. Caldwell
Revised: June 14, 2005
Scale: 1"=30'
Tax Parcel: 56.03-2-43.2
W.O. #: 01-0090
Notebook: Russlen Farms