


DOWNTOWN IMPROVEMENTS


TOWN OF VINTON, VIRGINIA

SHEET LIST

1. COVER SHEET
2. ABBREVIATIONS AND LEGEND
3. SHEET INDEX AND GENERAL NOTES
4. DEMOLITION PLAN
5. PLAN - LEE AVENUE IMPROVEMENTS
6. PLAN - LEE AVENUE IMPROVEMENTS
7. PLAN - LEE AVENUE IMPROVEMENTS
8. PLAN - POLLARD STREET IMPROVEMENTS
9. PLAN - POLLARD STREET IMPROVEMENTS
10. PLAN - POLLARD STREET IMPROVEMENTS
11. PLAN - CEDAR AVENUE IMPROVEMENTS
12. SANITARY SEWER PROFILE - LEE AVENUE
13. SANITARY SEWER PROFILE - POLLARD STREET
14. WATERLINE PROFILE - LEE AVENUE
15. WATERLINE PROFILE - POLLARD STREET
16. WATERLINE PROFILE - CEDAR AVENUE AND EAST CLEVELAND AVENUE
17. ROANOKE COUNTY SANITARY SEWER DETAILS
18. ROANOKE COUNTY WATER DETAILS

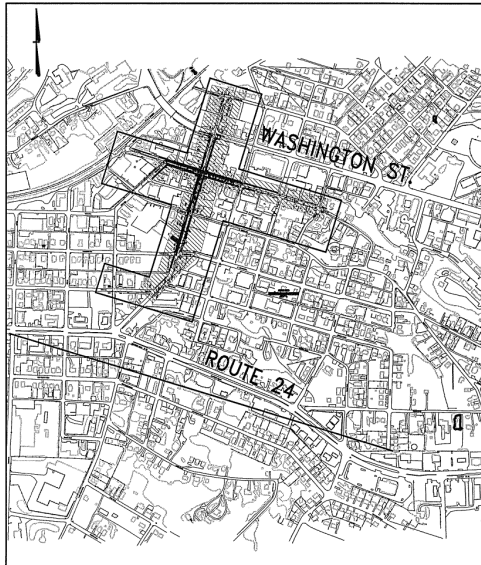

VICINITY MAP

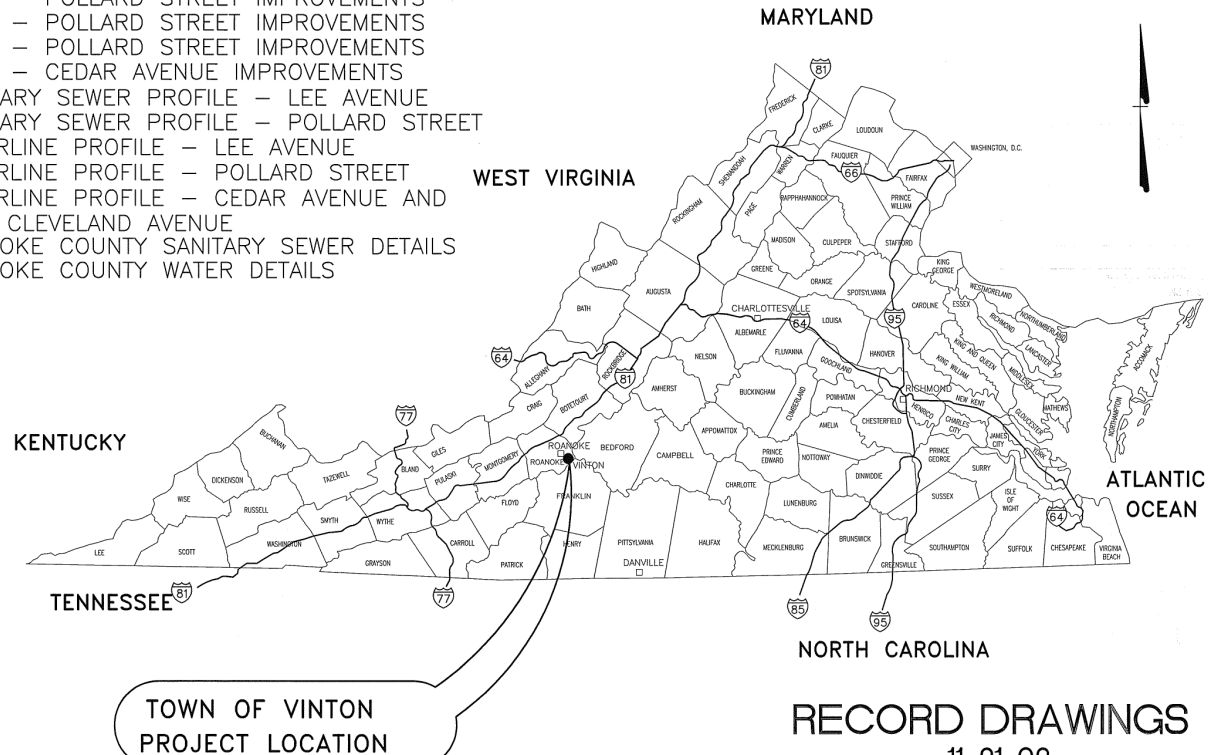

TOWN OF VINTON
PROJECT LOCATION

RECORD DRAWINGS

11-21-02

SET NO. _____

Mattern & Craig, Inc.
CONSULTING ENGINEERS • SURVEYORS
701 FIRST STREET, S.W.
ROANOKE, VIRGINIA 24016
(540) 345-9342
(540) 345-7691 FAX



DATE	11/21/02
REVISIONS	
1. RECORD DRAWINGS	

DATE	AUG. 19, 2001
DRAWN BY	JPR
DESIGNED BY	JPR
CHECKED BY	SWH
DATE	AUG. 17, 2001

Mattern & Craig
CONSULTING ENGINEERS • SURVEYORS
701 FIRST STREET, S.W.
ROANOKE, VIRGINIA 24016
(540) 345-9342
(540) 345-7691 FAX

DOWNTOWN IMPROVEMENTS PROJECT
COVER SHEET
TOWN OF VINTON, VIRGINIA

Vertical Scale:
N/A

Horizontal Scale:
N/A

Commission Number:
1955-B

Sheet No.:

1