


AB	ANCHOR BOLT
ABAN	ABANDON OR ABANDONED
ABUT	ABUTMENT
ABV	ABOVE
ACT	ACOUSTICAL
ADD	ADDITIONAL
ADJ	ADJACENT
AFF	ABOVE FINISH FLOOR
AGGR	AGGREGATE
ALUM	ALUMINUM
ALT	ALTERNATE
ANC	ANCHOR
APPROX	APPROXIMATE
ARCH	ARCHITECTURAL
AWWA	AMERICAN WATER WORKS ASSOCIATION
AVG	AVERAGE
BIT	BITUMINOUS
BJ	BELL JOINT
BL	BASE LINE
BEG	BEGIN OR BEGINNING
BLDG	BUILDING
BLKG	BLOCKING
BM	BENCH MARK, BEAM
BOTT	BOTTOM
BP	BYPASS
BRG	BEARING
BSMT	BASEMENT
BV	BUTTERFLY VALVE
C	CHANNEL, COLD
C/C, C. TO C	CENTER TO CENTER
CAB	CABINET
CAP	CAPACITY
CF	CUBIC FEET
CG	CHANGE OF GRADE
C & G, CC&G	CURB AND GUTTER, CONCRETE
CI	CAST IRON
CIRC	CIRCULAR
CKT	CIRCUIT
CL	CENTER LINE
CLR	CLEAR
CONST	CONSTRUCTION
COR	CORNER
CMP	CORRUGATED METAL PIPE
CMU	CONCRETE MASONRY UNITS
CND	CONDUIT
CO	CLEAN OUT
COMB	COMBINATION
CONC	CONCRETE
CONN	CONNECT, CONNECTION
CONT	CONTINUOUS, CONTROL
CONTR	CONTRACTOR
CP	COORDINATE POINT
CR	CRUSHED STONE
CR STONE	CONCRETE SIDEWALK
CSW	CENTER
CTR	CULVERT
CY	CUBIC YARD
D	DEPTH OR DEGREE OF CURVE
DEPT	DEPARTMENT
DF	DRINKING FOUNTAIN
DI	DROP INLET, DUCTILE IRON
DIA	DIAMETER
DIM	DIMENSION
DISC	DISCONNECT
DMH	DROP MANHOLE
DN	DOWN
DR	DRIVE
DS	DOWN SPOUT
DTL	DETAL
DW/D/W	DRIVEWAY
DWL	DWELLING
DWG	DRAWING
E	EAST
EA	EACH
E.B.L.	EASTBOUND LANE
EF	EACH FACE
EJ	EXPANSION JOINT
EL, ELEV	ELEVATION
ELEC	ELECTRICAL
ENGR	ENGINEER
ENR	ENTRANCE
EOL	END OF LINE
EP	EDGE OF PAVEMENT
EQ	EQUAL
EQPT	EQUIPMENT
EW	EACH WAY, ENDWALL
EXIST	EXISTING


EXP	EXPANSION
EXT	EXTERIOR
FR	FRAME
FD	FLOOR DRAIN
FDN	FOUNDATION
FES	FLARED END SECTION
FF	FINISH FLOOR
FFE	FINISHED FLOOR ELEVATION
FH	FIRE HYDRANT
FIG	FIGURE
FIN	FINISH
FIXT	FIXTURE
FL	FLOOR
FLEX	FLEXIBLE
FLG	FLANGE
FT	FOOT
FTG	FOOTING
FUT	FUTURE
GAL	GALLON
GALV	GALVANIZED
GB	GARAGE
GND	GROUND
GR	GRAVEL
GOVT	GOVERNMENT
GPM	GALLONS PER MINUTE
GRTG	GRATING
GV	GAS VALVE
GW	GRAY WATER
H	HOT
HB	HOSE BIBB
HK	HOOK
HM	HOLLOW METAL
HOR, HORIZ	HORIZONTAL
HP	HORSE POWER
HPT	HIGH POINT
HYD	HYDRANT
ID	INSIDE DIAMETER
IN	INCH
INSUL	INSULATION
INV	INVERT
IP	IRON PIN
JOINT	JOINT
JB	JUNCTION BOX
L	LENGTH, LONG
LF	LINEAL FOOT
LG	LONG
LP	LIGHT POLE
LR	LONG RADIUS
LT	LEFT
LTG	LIGHTING
MACH	MACHINERY
MAS	MASONRY
MATL	MATERIAL
MAX	MAXIMUM
MB	MAILBOX
MECH	MECHANICAL
MFR	MANUFACTURER
MH	MANHOLE, MOUNTING HEIGHT
MIN	MINIMUM
MISC	MISCELLANEOUS
MJ	MECHANICAL JOINT
MO	MASONRY OPENING
MON	MONUMENT
MTD	MOUNTED
MTG	MOUNTING
MTL	METAL
MV	MUD VALVE
N & C	NAIL AND CAP
NC	NOT IN CONTRACT
NO	NUMBER
NTS	NOT TO SCALE
OC	ON CENTERS
OD	OUTSIDE DIAMETER
OPER	OPERATOR
OPNG	OPENING
OPP	OPPOSITE
PB	PAPER BOX
PC	POINT OF CURVE
PCC	POINT OF COMPOUND
PER	PERIMETER
PERF	PERFORATED
PERP	PERPENDICULAR
PI	POINT OF INTERSECTION
PIN	POST INDICATOR VALVE
PL	PLATE, PROPERTY LINE
PLYWD	PLYWOOD
POL	POINT ON LINE

PP	POWER POLE
POT	POINT ON TANGENT
PRC	POINT OF REVERSE CURVE
PSI	POUNDS PER SQUARE INCH
PT	POINT OF TANGENT
PVC	POLYVINYL CHLORIDE
PVI	POINT OF VERTICAL INTERSECTION
PWMT	PAVEMENT
PVT	PRIVATE
R	RADIUS, RISER
RAS	RETURN ACTIVATED SLUDGE
RR	RAIL ROAD
RCP	REINFORCED CONCRETE PIPE
ROD	ROOF DRAIN, ROAD
RDCR	REDUCER
RECPT	RECEPACLE
RECT	RECTANGULAR
REINF	REINFORCE, REINFORCEMENT
REF	REFERENCE
REL	RELOCATED
REOD	REQUIRED
REV	REVISION
ROUTE	ROUTE
RT	RIGHT
R/W	RIGHT OF WAY
S	SANITARY SEWER, SOUTH, SWITCH
SAV	SAN
SCH	SCHEDULE
SD	STORM DRAIN
SECT	SECTION
SER	SERVICE
SH	SHEET
SHTG	SHEETING
SIM	SIMILAR
SPEC	SPECIFICATION
SP	SIGNAL POLE
SQ	SQUARE
SS	STAINLESS STEEL
ST	STREET
STA	STATION
STD	STANDARD
STL	STEEL
STRUCT	STRUCTURAL
STY	STORY
SUR	SURVEY
SURF	SURFACE
S/W	SIDEWALK
SYMM	SYMMETRICAL
T	TREAD, TOP
T & B	TOP AND BOTTOM
TDC	TURNED DOWN CURB
TELE	TELEPHONE
TEMP	TEMPORARY
THK	THICK
TP	TELEPHONE POLE
TRTD	TREATED
TS	TOP OF SLAB
TV	TELEVISION
TW	TOP OF WALL
UG	TYPICAL
UON	UNDERGROUND
U.S.C.&G.S.	UNLESS OTHERWISE NOTED UNITED STATES COAST AND GEODETIC SURVEY
USGS	UNITED STATES GEOLOGICAL SURVEY
V, VAL	VALVE
VAP BAR	VAPOR BARRIER
VC	VERTICAL CURVE
VERT	VERTICAL
VOL	VOLUME
VDOT	VIRGINIA DEPARTMENT OF TRANSPORTATION
V.S.D.	VERTICAL SIGHT DISTANCE
W.B.L.	WEST BOUND LANE
W	WIDE FLANGE, WIDE
W/	WITH
WD	WOOD
WL	WATER LINE
W/O	WITHOUT
WS	WATER SURFACE
WT	WATERTIGHT, WEIGHT
WVOH	WEST VIRGINIA DEPARTMENT OF HIGHWAYS
WWF	WELDED WIRE FABRIC


#### MATERIALS SYMBOLS

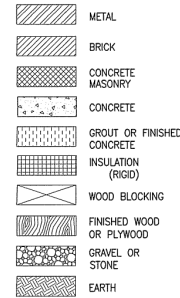


#### EROSION AND SEDIMENT CONTROL SYMBOLS

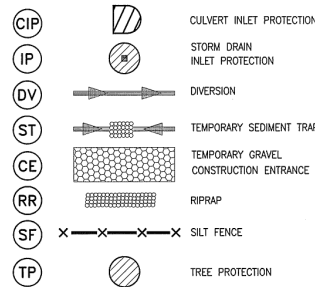

#### EXISTING

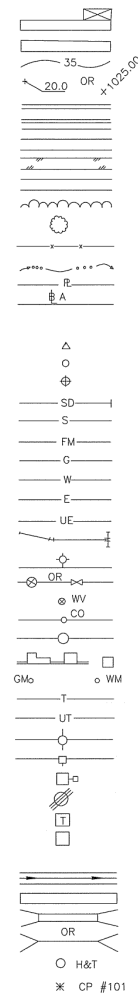

#### NEW

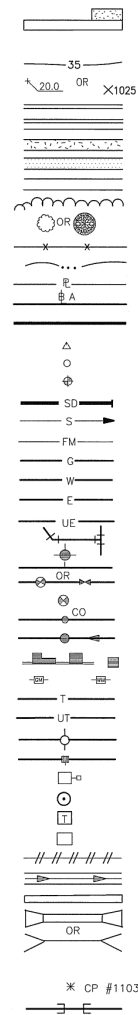

#### DESCRIPTION

BUILDING WITH PORCH OR STOOP  
FOUNDATION ONLY  
CONTOUR, CONTOUR WITH ELEVATION  
SPOT ELEVATION  
CONCRETE CURB  
CONCRETE CURB & GUTTER  
CONCRETE WALK OR SLAB  
EDGE OF PAVEMENT  
UNPAVED OR GRAVEL ROAD  
TREE LINE  
TREE OR SHRUB  
FENCE  
CENTERLINE CREEK, SWALE OR DITCH  
PROPERTY LINE  
BASELINE  
LIMIT OF WORK LINE  
FIELD SURVEY TRAVERSE POINT  
P.C. OR P.T.  
GEOLOGIC BORE HOLE  
STORM DRAIN AND ENDWALL  
SANITARY SEWER  
FORCE MAIN  
GAS MAIN OR SERVICE LINE  
WATER MAIN OR SERVICE LINE  
ELECTRICAL LINE  
UNDERGROUND ELECTRICAL LINE  
PIPE FITTINGS  
FIRE HYDRANT  
GATE VALVE  
WATER VALVE  
CLEANOUT  
MANHOLE  
DROP INLET (CURB AND GRATING TYPES)  
G.M. - GAS METER, W.M. - WATER METER  
TELEPHONE LINE  
UNDERGROUND TELEPHONE LINE  
TELEPHONE POLE, GUY AND ANCHOR  
POWER POLE, GUY AND ANCHOR  
SIGNAL POLE  
TELEPHONE PEDESTAL  
BURIED TELEPHONE VAULT  
ABANDON OR REMOVE  
PAVED DITCH  
DRIVEWAY CULVERT  
CULVERT WITH FLARED END SECTION  
HUB AND TACK  
COORDINATE POINT  
PLUG ON WATER MAIN

**RECORD DRAWINGS**  
11-21-02



Issue Date:	Aug. 19, 2001
Drawn By:	JPR
Designed By:	JPR
Checked By:	SWH
Date:	Aug. 17, 2001

Matthew W. Stewart  
CONSULTING ENGINEER  
301 WEST STREET, S.W.  
ROANOKE, VIRGINIA 24016  
Tel: (540) 345-7901  
Fax: (540) 345-7901



**ABBREVIATIONS & LEGEND**  
TOWN OF VINTON

Vertical Scale:  
N/A

Horizontal Scale:  
N/A

Commission Number:  
1955-B

Sheet No.:

2