


SANITARY SEWER PROFILE - LEE AVENUE

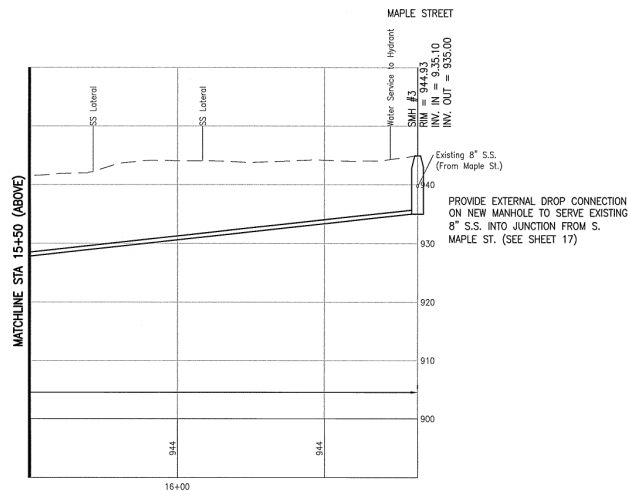


SANITARY SEWER PROFILE - LEE AVENUE

#### SANITARY SEWER NOTES:


1. REMOVE EXISTING SEWER AND MANHOLES, REPLACE SEWER LINE, CONNECT ALL EXISTING LATERALS TO NEW SEWER LINE AND INSTALL NEW MANHOLES.
2. NEW MANHOLE TOP (RIM) ELEVATIONS SHOWN ARE APPROXIMATE. ACTUAL ELEVATIONS SHALL BE ADJUSTED IN THE FIELD AS NECESSARY TO MATCH ADJACENT FINISHED GRADE.
3. CONTRACTOR TO CONFIRM INVERTS OF ALL SEWER MANHOLES INCLUDED ON THESE PLANS PRIOR TO REMOVAL OF EXISTING SANITARY SEWER. NEW SANITARY SEWER IS TO BE INSTALLED IN THE SAME TRENCH AS EXISTING.
4. EXISTING SANITARY SEWER LATERALS, WATER SERVICE LINES, GAS LINES AND OTHER UNDERGROUND UTILITIES SHOWN ON THESE PLANS ARE FOR INFORMATION ONLY. DEPTH OF EXISTING UTILITIES IS NOT KNOWN. THE CONTRACTOR SHALL VERIFY THE LOCATION AND DEPTH OF ALL UNDERGROUND UTILITIES PRIOR TO CONSTRUCTION.
5. CONSTRUCTION OF NEW SANITARY SEWER SHALL BE PERFORMED IN ACCORDANCE WITH THE CONSTRUCTION DETAILS AND SPECIFICATIONS.
6. FOR SEWER REHABILITATION ALTERNATE, EXISTING SEWER CAN REMAIN AND MANHOLES CAN REMAIN WITH BOTH REHABILITATED PER SPECIFICATIONS. SEWER LATERALS SHALL BE CONNECTED TO NEW PIPE PER SPECIFICATIONS.

RECORD DRAWINGS

11-21-02

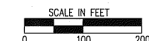

R:\dwgs\1955b\dwg\Profile-2.dwg

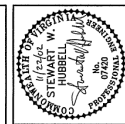

Revisions	Date
1. RECORD DRAWINGS	11/21/02

Issue Date:	AUG. 19, 2001
Drawn By:	JPR
Designed By:	JPR
Checked By:	SWH
Date:	AUG. 17, 2001

**Mattem & Craig**  
 CONSULTING ENGINEERS & ARCHITECTS  
 301 WEST STREET, S.W.  
 RICHMOND, VIRGINIA 23216  
 Tel: (804) 345-7801  
 Fax: (804) 345-7801

DOWNTOWN IMPROVEMENTS  
**SANITARY SEWER PROFILE**  
**LEE AVENUE**  
 TOWN OF VINTON, VIRGINIA

Vertical Scale:	1"=10'
Horizontal Scale:	1"=20'
Commission Number:	19558
Sheet No.:	12