DEVELOPMENT PLAN

FOR

VIRGINIA VARSITY STORAGE STARKEY SITE EXPANSION


SITUATED IN

CAVE SPRING MAGISTERIAL DISTRICT ROANOKE COUNTY, VIRGINIA

DATE: February 12, 2008

PREPARED FOR

VIRGINIA VARSITY STORAGE

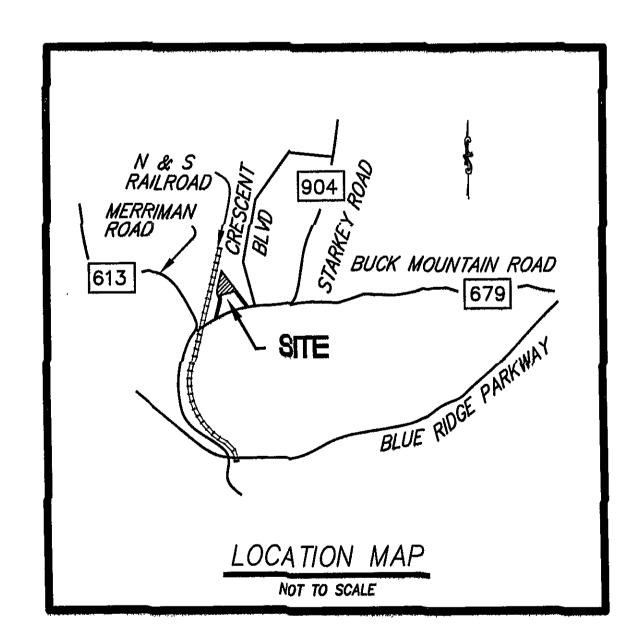

--INDEX OF DRAWINGS--

SHEET No.

DESCRIPTION

1. LUMSDEN ASSOCIATES COVER SHEET 2 ROANOKE COUNTY COVER SHEET 3. SITE PLAN, NOTES & DETAILS

3A..... WATERLINE PLAN, PROFILE, NOTES & DETAILS 4 EROSION AND SEDIMENT CONTROL & LANDSCAPING

5 EROSION AND SEDIMENT CONTROL DETAILS


DEVELOPMENT PLAN APPROVED FOR CONSTRUCTION BY ROANOKE COUNTY		
Department		Date
Development Review	A	1/14/08
Engineering	Me	7/7/0
Water & Sewer	RRB	8/01/0
Planning & Zoning	Hew	7/10/0


AS BUILT 8/19/2008



4664 BRAMBLETON AVENUE, SW P.O. BOX 20669 ROANOKE, VIRGINIA 24018

PHONE: (540) 774-4411 FAX: (540) 772-9445 E-MAIL: MAIL@LUMSDENPC.COM

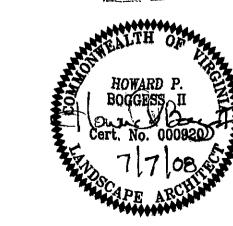

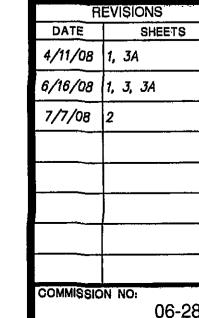

I AM CERTIFIED BY THE STATE OF VIRGINIA AS A "RESPONSIBLE LAND DISTURBER". I SHALL BE RESPONSIBLE FOR THE IMPLEMENTATION OF THE EROSION AND SEDIMENT CONTROL PLAN AS SHOWN.

CERTIFICATE No.: ._____

SHEET 1 OF 5