



PRIVATE STORM SEWER STR. 9 - 4 PROFILE

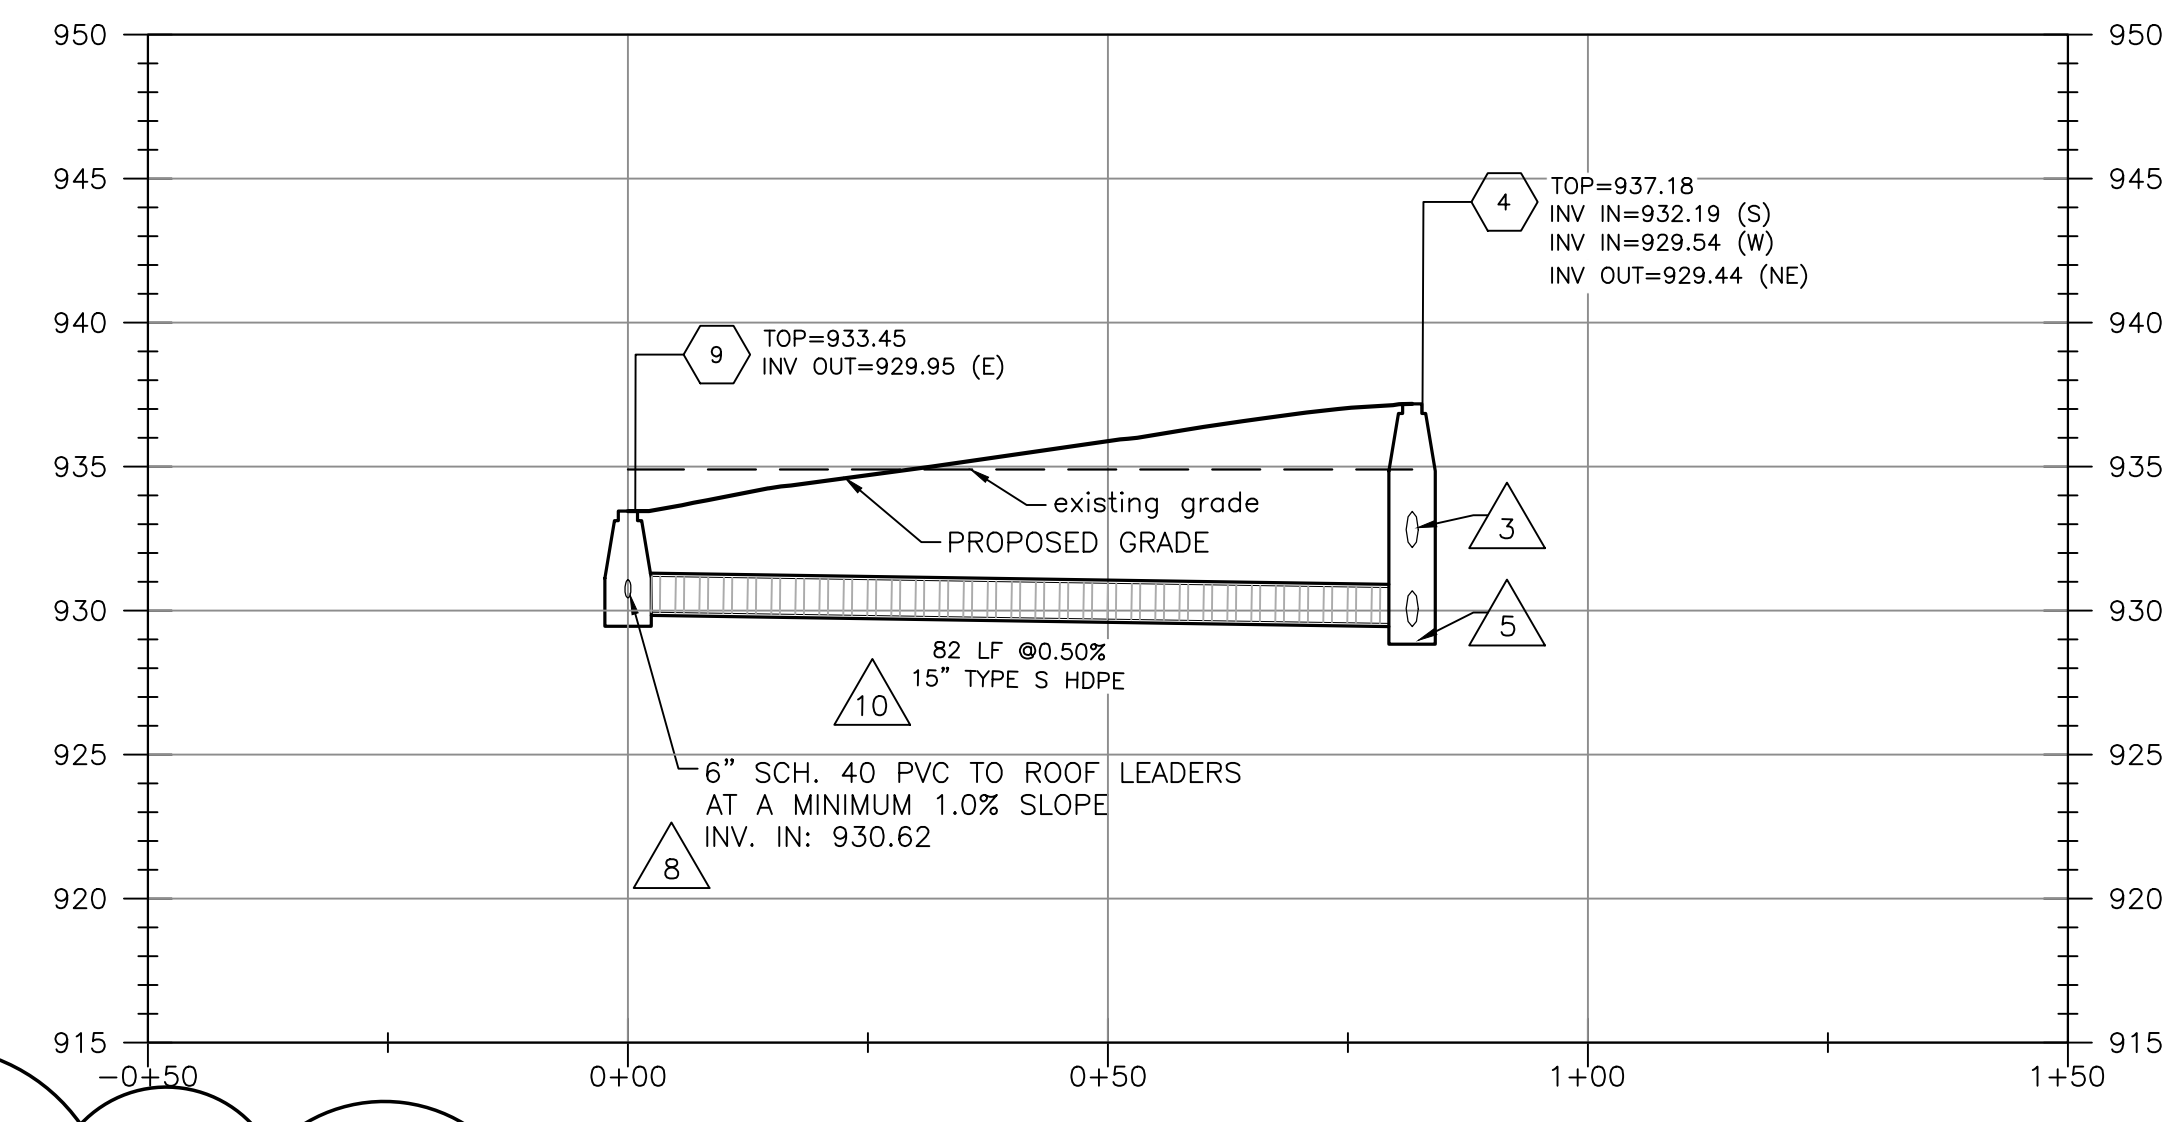

STORM STRUCTURE SCHEDULE:

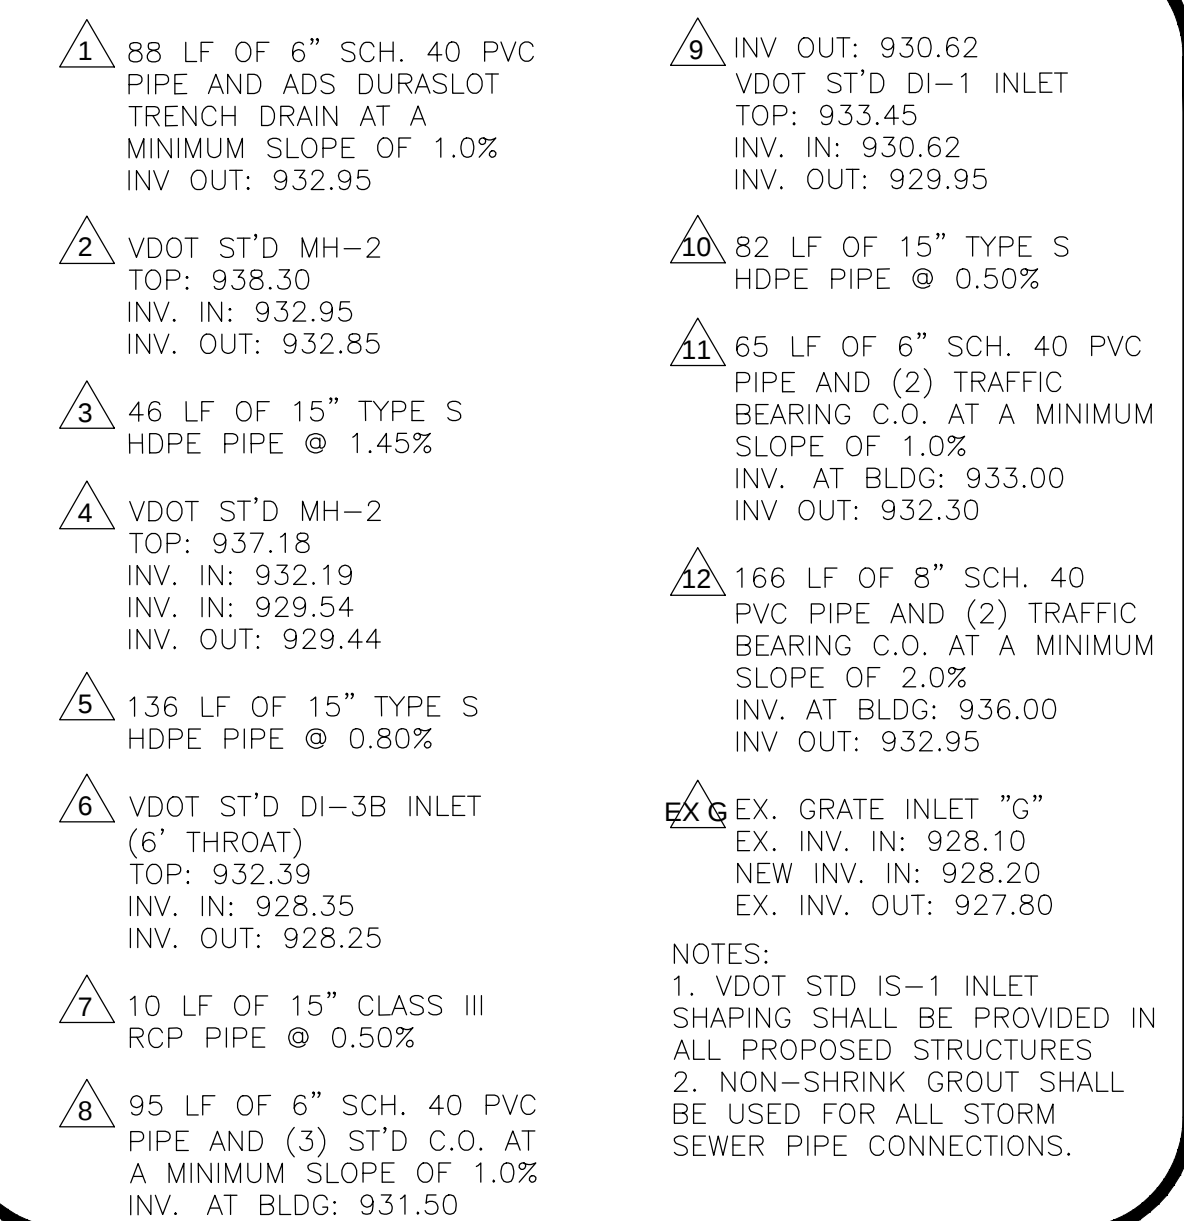


ex. s.s. mh B 59 LF OF 8" PVC SDR-35 AT 1.59%
INV. OUT: 923.00

- | | |
|---------|---|
| (A) | S.S. MH. PUBLIC (STANDARD LID)
TOP=932.14
INV. IN=924.14
INV. OUT=923.94 |
| (A) (B) | 272 LF OF 8" PVC SDR-35 AT 0.82% |
| (B) | MH. PUBLIC (STANDARD LID)
TOP=931.41
INV. IN= 926.58
INV. OUT=926.58 |
| (B) (C) | 30 LF OF 6" PVC SDR-35 AT 1.23% |
| (C) | S.S. CO TYP. (FLUSH TOP)
TOP=931.41
INV.=926.95 |

(G.C. TO CONFIRM & COORDINATE ALL TIE IN LOCATIONS W/M.E.P.
& ARCH. DRAWINGS PRIOR TO ANY INTERIOR OR EXTERIOR S.S.
PIPE BEING INSTALLED. NOTIFY ENGINEER IMMEDIATELY IF
DISCREPANCIES ARE DISCOVERED PRIOR TO ANY CONSTRUCTION)


AS-BUILT DRAWING NOTE:
AS-BUILT DRAWING FOR SANITARY SEWER AND WATERLINE IMPROVEMENTS ARE FOR AS-BUILT PURPOSES ONLY. NO IMPROVEMENTS OTHER THAN WATER AND SANITARY SEWER STRUCTURES WERE AS-BUILT OR INDICATED AS SUCH ON THE SUBJECT PLAN SET. UNDERGROUND PIPING WAS NOT LOCATED. LOCATION SHOWN IS APPROXIMATE BASED ON SURFACE FEATURES AND INFORMATION PROVIDED BY CONTRACTOR.

STR. B - BLDG. PROFILE

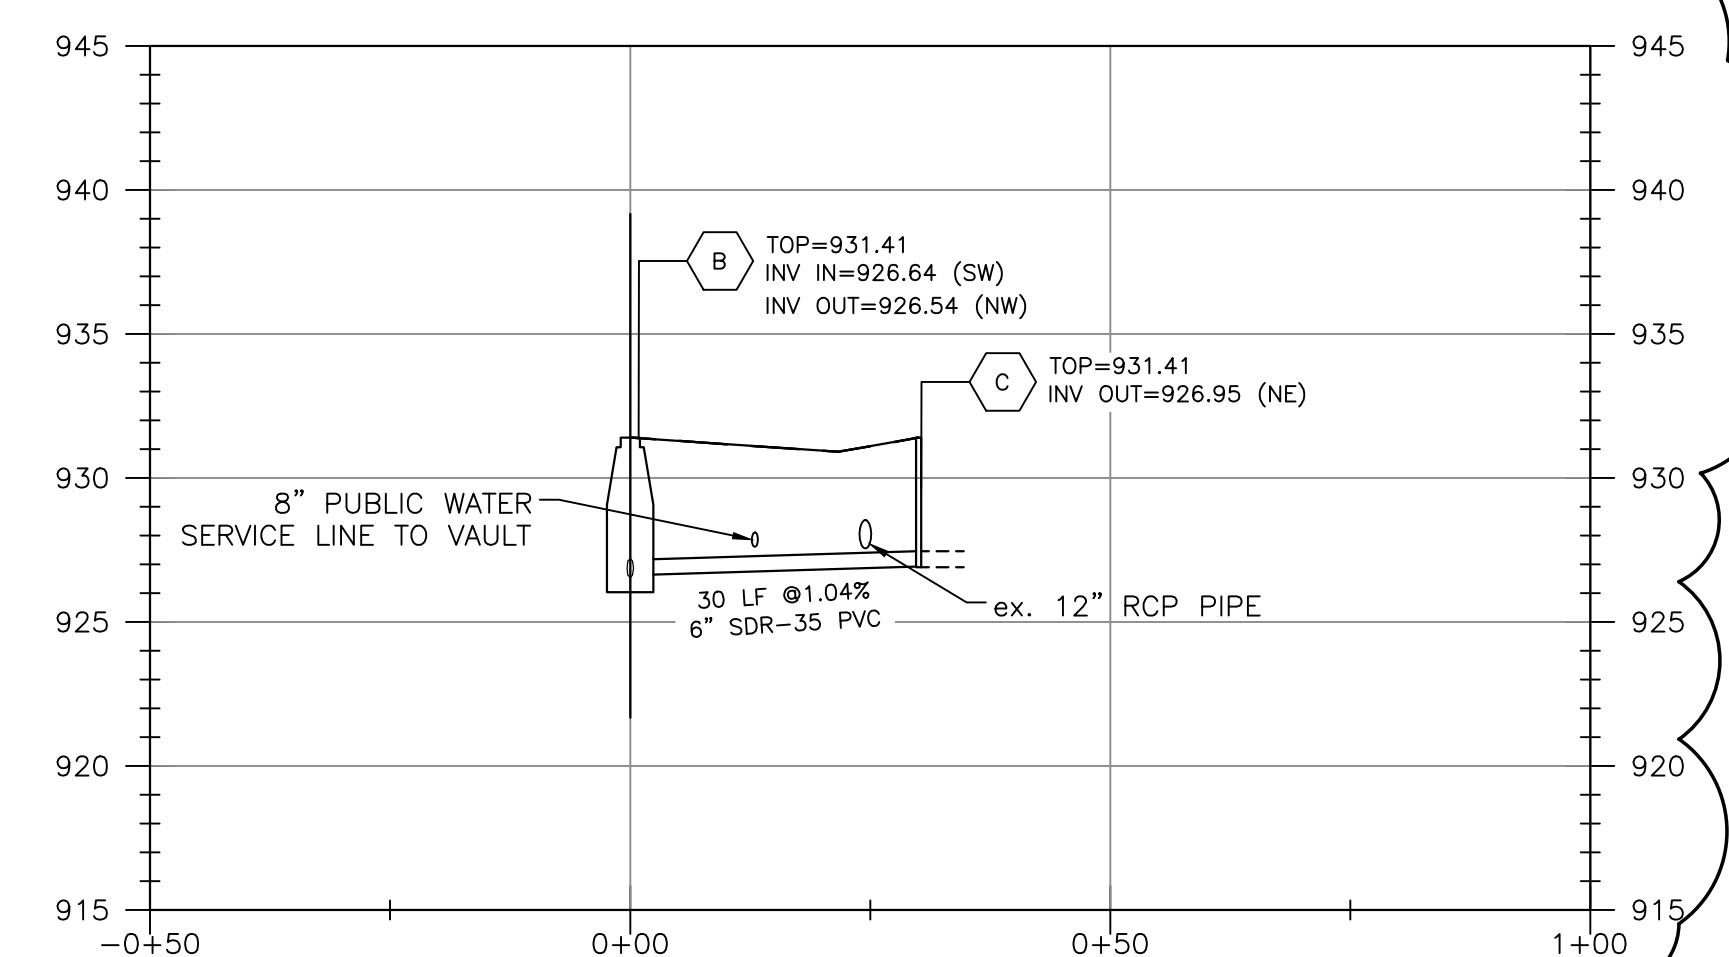

Roanoke / Richmond
New River Valley / Staunton
Harrisonburg / Lynchburg
www.balzer.cc

1208 Corporate Circle
Roanoke, VA 24018
540.772.9580

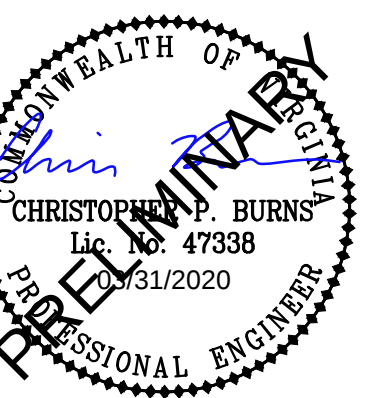

VIRGINIA VANITY STORAGE BUILDING

PROFILES (UTILITY AS-BUILT)

1948 FRANKLIN ROAD SW
CITY OF ROANOKE, VA

AWN BY	EJP
SIGNED BY	BTC
CHECKED BY	CPB
DATE	5/1/2019
SCALE	AS SHOWN
DIVISIONS	
6/14/2019	
3/27/2020 - UTILITY AS-BUILT	
03/30/2020 - UTILITY AS-BUILT	

C8