



**SPECTRUM DESIGN**  
architects | engineers

PLAZA SUITE 1 | 10 CHURCH AVENUE SE  
ROANOKE, VA 24011-2104

540 . 342 . 6001  
FAX: 540 . 342 . 6055

www.spectrumpc.com



Landscape Architecture  
Architecture  
Community Planning  
Historic Preservation

120 W. Campbell Ave. SW  
Roanoke, VA 24011  
tel: 540-342-5263 fax: 540-345-5625  
www.hillstudio.com


BARRY A. RAKES - ARCHITECT, PLLC  
910 WEST WIND ROAD  
FINCASTLE, VIRGINIA 24090  
(540) 473-1567

PROJECT NUMBER: 12138

VIRGINIA STATE PROJECT  
CODE # EN05-128-325, C502

VDOT UPC # 103592

TAX MAP #4039003

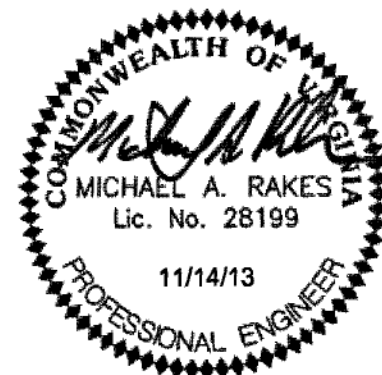

#### CITY CONSTRUCTION PROCEDURE REQUIREMENTS

- RIGHT-OF-WAY EXCAVATION PERMIT - PRIOR TO THE COMMENCEMENT OF ANY DIGGING, ALTERATION OR CONSTRUCTION WITHIN THE PUBLIC RIGHT-OF-WAY (STREETS, ALLEYS, PUBLIC EASEMENTS), A RIGHT-OF-WAY EXCAVATION PERMIT SHALL BE APPLIED FOR AND OBTAINED BY THE CONTRACTOR FROM THE CITY OF ROANOKE.
2. LAND DISTURBANCE PERMIT - AN APPROVED EROSION AND SEDIMENT CONTROL PLAN FOR ANY BORROW/FILL SITES ASSOCIATED WITH THE PROJECT MUST BE SUBMITTED PRIOR TO THE ISSUANCE OF A LAND DISTURBANCE PERMIT.
  3. PLANS AND PERMITS - A COPY OF THE PLANS AS APPROVED BY THE CITY (SIGNED BY THE PROPER CITY OFFICIALS) AND ALL PERMITS ISSUED BY THE CITY SHALL BE AVAILABLE AT THE CONSTRUCTION SITE AT ALL TIMES OF ONGOING CONSTRUCTION.
  4. LOCATION OF UTILITIES - THE CONTRACTOR SHALL VERIFY THE LOCATION OF ALL EXISTING UTILITIES PRIOR TO THE COMMENCEMENT OF ANY CONSTRUCTION.
  5. CONSTRUCTION ENTRANCE - THE CONTRACTOR SHALL INSTALL AN ADEQUATE CONSTRUCTION ENTRANCE FOR ALL CONSTRUCTION RELATED EGRESS FROM THE SITE. SIZE AND COMPOSITION OF CONSTRUCTION ENTRANCE SHALL BE AS SHOWN ON THE PLANS.
  6. STREETS TO REMAIN CLEAN - IT SHALL BE THE RESPONSIBILITY OF THE CONTRACTOR TO INSURE THAT THE PUBLIC STREET ADJACENT TO THE CONSTRUCTION ENTRANCE REMAINS FREE OF MUD, DIRT, DUST, AND/OR ANY TYPE OF CONSTRUCTION MATERIALS OR LITTER AT ALL TIMES.
  7. BARRICADES/DITCHES - THE CONTRACTOR SHALL MAINTAIN THE INTEGRITY OF ALL EXCAVATED DITCHES AND SHALL FURNISH AND ENSURE THAT ALL BARRICADES PROPER AND NECESSARY FOR THE SAFETY OF THE PUBLIC ARE IN PLACE.
  8. SEWER AND PAVEMENT REPLACEMENT - CONSTRUCTION OF SANITARY SEWERS AND THE REPLACEMENT OF PAVEMENT SHALL BE IN ACCORDANCE WITH APPROVED STANDARDS AND SPECIFICATIONS OF THE CITY OF ROANOKE AND THE WESTERN VIRGINIA WATER AUTHORITY.
  9. APPROVED PLANS/CONSTRUCTION CHANGES - ANY CHANGE OR VARIATION FROM CONSTRUCTION DESIGN AS SHOWN ON THE OFFICIALLY APPROVED PLANS SHALL BE APPROVED BY THE EROSION AND SEDIMENT CONTROL AGENT PRIOR TO SAID CHANGES OR VARIATION IN CONSTRUCTION BEING MADE.
  10. FINAL ACCEPTANCE/CITY - THE OWNER OR DEVELOPER SHALL FURNISH THE CITY OF ROANOKE'S PLANNING BUILDING AND DEVELOPMENT DEPARTMENT WITH A FIELD SURVEYED FINAL CORRECT SET OF AS-BUILT PLANS OF THE NEWLY CONSTRUCTED STORM RAIN AND/OR STORMWATER MANAGEMENT FACILITIES PRIOR TO FINAL ACCEPTANCE AND ISSUANCE OF A CERTIFICATE OF OCCUPANCY BY E CITY. AS-BUILT PLANS SHALL BE PROVIDED IN THE STATE PLANE VIRGINIA SOUTH COORDINATE SYSTEM, NAD 1983, FIPS 4502 FEET, US SURVEY FEET, DATUM NA 83, IN THE FORM OF 1 PAPER COPY AND 1 DIGITAL AUTOCAD FILE.

# VIRGINIAN RAILWAY PASSENGER STATION PHASE II - RESTORATION

SITE ADDRESS:  
1402 JEFFERSON ST. SE  
ROANOKE, VA

CONSTRUCTION DOCUMENTS  
14 NOVEMBER 2013

RECEIVED  
DEC 23 2013

## INDEX OF DRAWINGS

### GENERAL

G000 COVER SHEET

### CIVIL

C101 EXISTING CONDITIONS & DEMOLITION PLAN  
C102 DIMENSIONAL & UTILITY PLAN  
C103 GRADING AND STORM DRAINAGE PLAN  
C301 ADDITIVE BID ITEMS  
C501 DETAILS  
C502 DETAILS  
C503 ESC NARRATIVE  
C504 ESC DETAILS

### LANDSCAPE

L100 LANDSCAPE PLAN  
L101 PLANTING PLAN  
L501 DETAILS

### LIFE SAFETY PLAN

LS-1 LIFE SAFETY PLAN

### ARCHITECTURAL

A1.1 EXISTING INTERIOR ELEVATIONS  
A1.2 EXISTING INTERIOR ELEVATIONS  
A2.1 EXISTING CONDITIONS  
A2.2 FLOOR PLAN - PASSENGER BUILDING  
A2.3 FLOOR PLAN - BAGGAGE AND EXPRESS BUILDING  
A3.1 EXTERIOR ELEVATIONS

A3.2 EXTERIOR ELEVATIONS  
A3.3 EXTERIOR ELEVATIONS  
A3.4 DORMER DETAILS  
A3.5 EXTERIOR DETAILS  
A4.1 ENLARGED TOILET PLANS  
A4.2 ENLARGED TOILET PLANS  
A5.1 INTERIOR ELEVATIONS  
A5.2 INTERIOR ELEVATIONS  
A5.3 TICKET OFFICE ELEVATIONS  
A5.4 TICKET OFFICE ELEVATIONS  
A6.1 REFLECTED CEILING PLAN - PASSENGER BUILDING  
A6.2 REFLECTED CEILING PLAN - BAGGAGE AND EXPRESS BUILDING  
A8.1 FINISH SCHEDULE  
A8.2 DOOR AND WINDOW SCHEDULE  
A8.3 DOOR ELEVATIONS  
A8.4 WINDOW DETAILS/ELEVATIONS

### MECHANICAL

M001 MECHANICAL LEGEND, SCHEDULES, DETAILS, AND CONTROLS  
M101 MECHANICAL FLOOR PLANS  
M102 MECHANICAL FLOOR PLANS


### PLUMBING

P001 PLUMBING - SPECIFICATIONS  
P101 PLUMBING - EQUIPMENT SCHEDULE, NOTES & FLOOR PLANS

### ELECTRICAL

E001 ELECTRICAL LEGEND, FIXTURE SCHEDULE & DETAILS  
E002 ELECTRICAL RISER DIAGRAM & PANELBOARDS  
E101 PASSENGER BUILDING ELECTRICAL PLAN  
E102 BAGGAGE & EXPRESS BUILDING ELECTRICAL PLAN  
E201 ELECTRICAL SITE PLAN  
E301 ELECTRICAL SITE PLAN PHOTOMETRICS

## PROJECT LOCATION

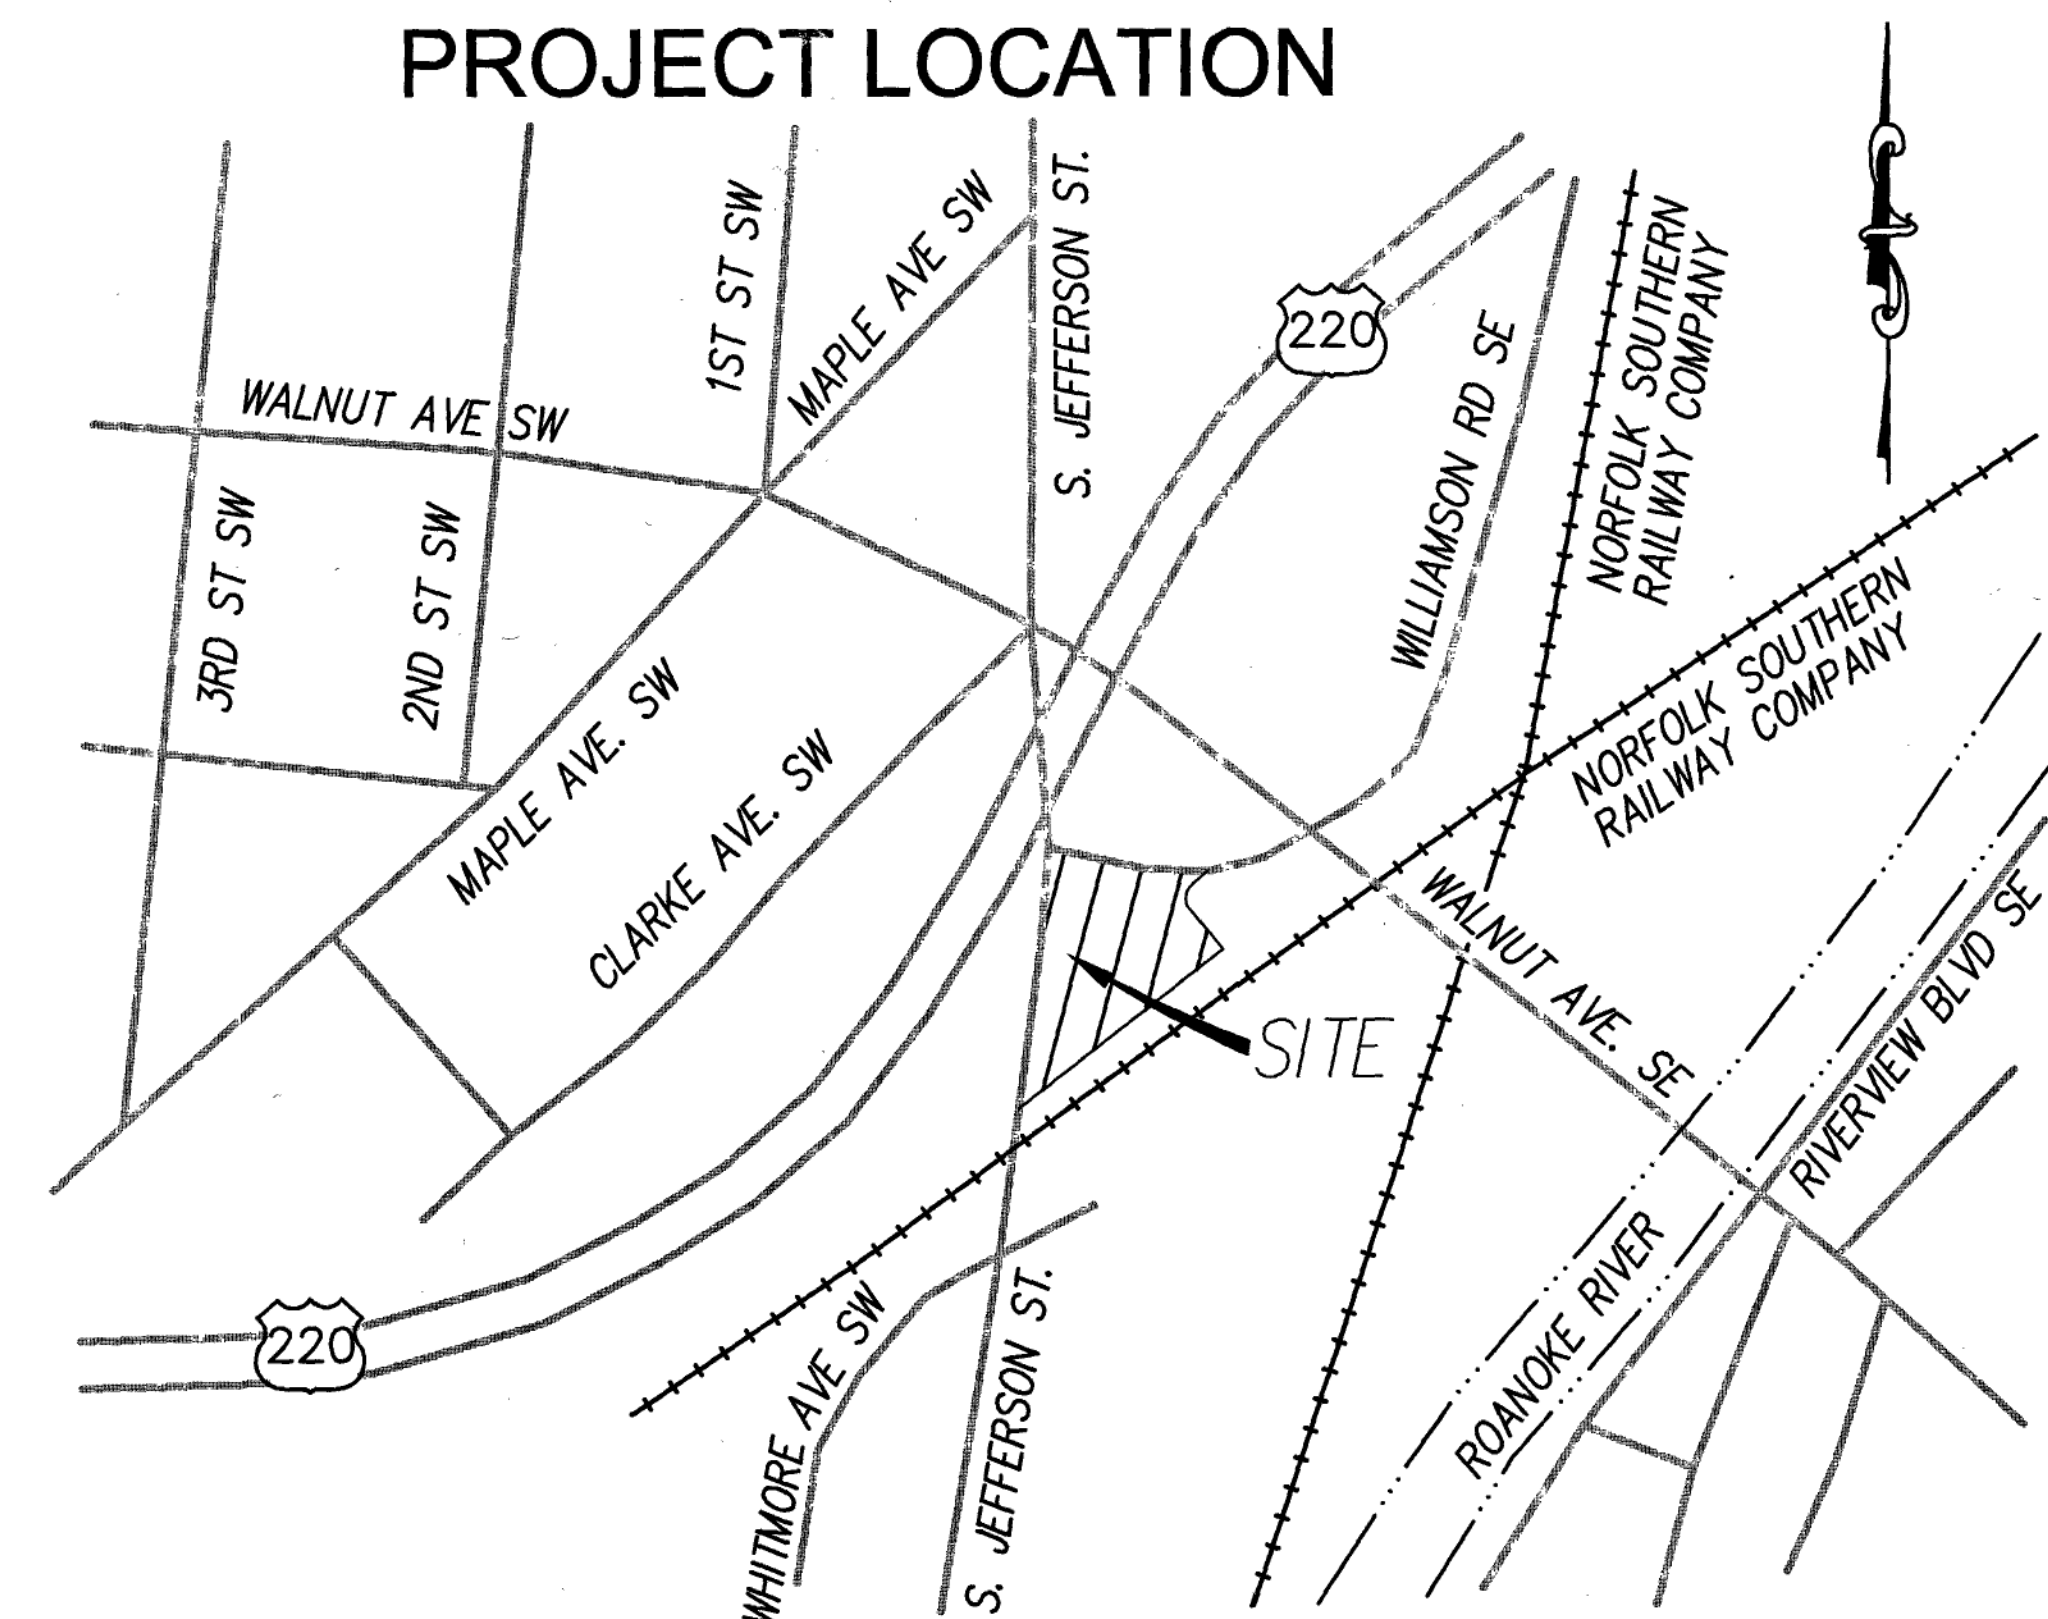

As-Built 12/29/2015