


PROJECT LOCATION MAP

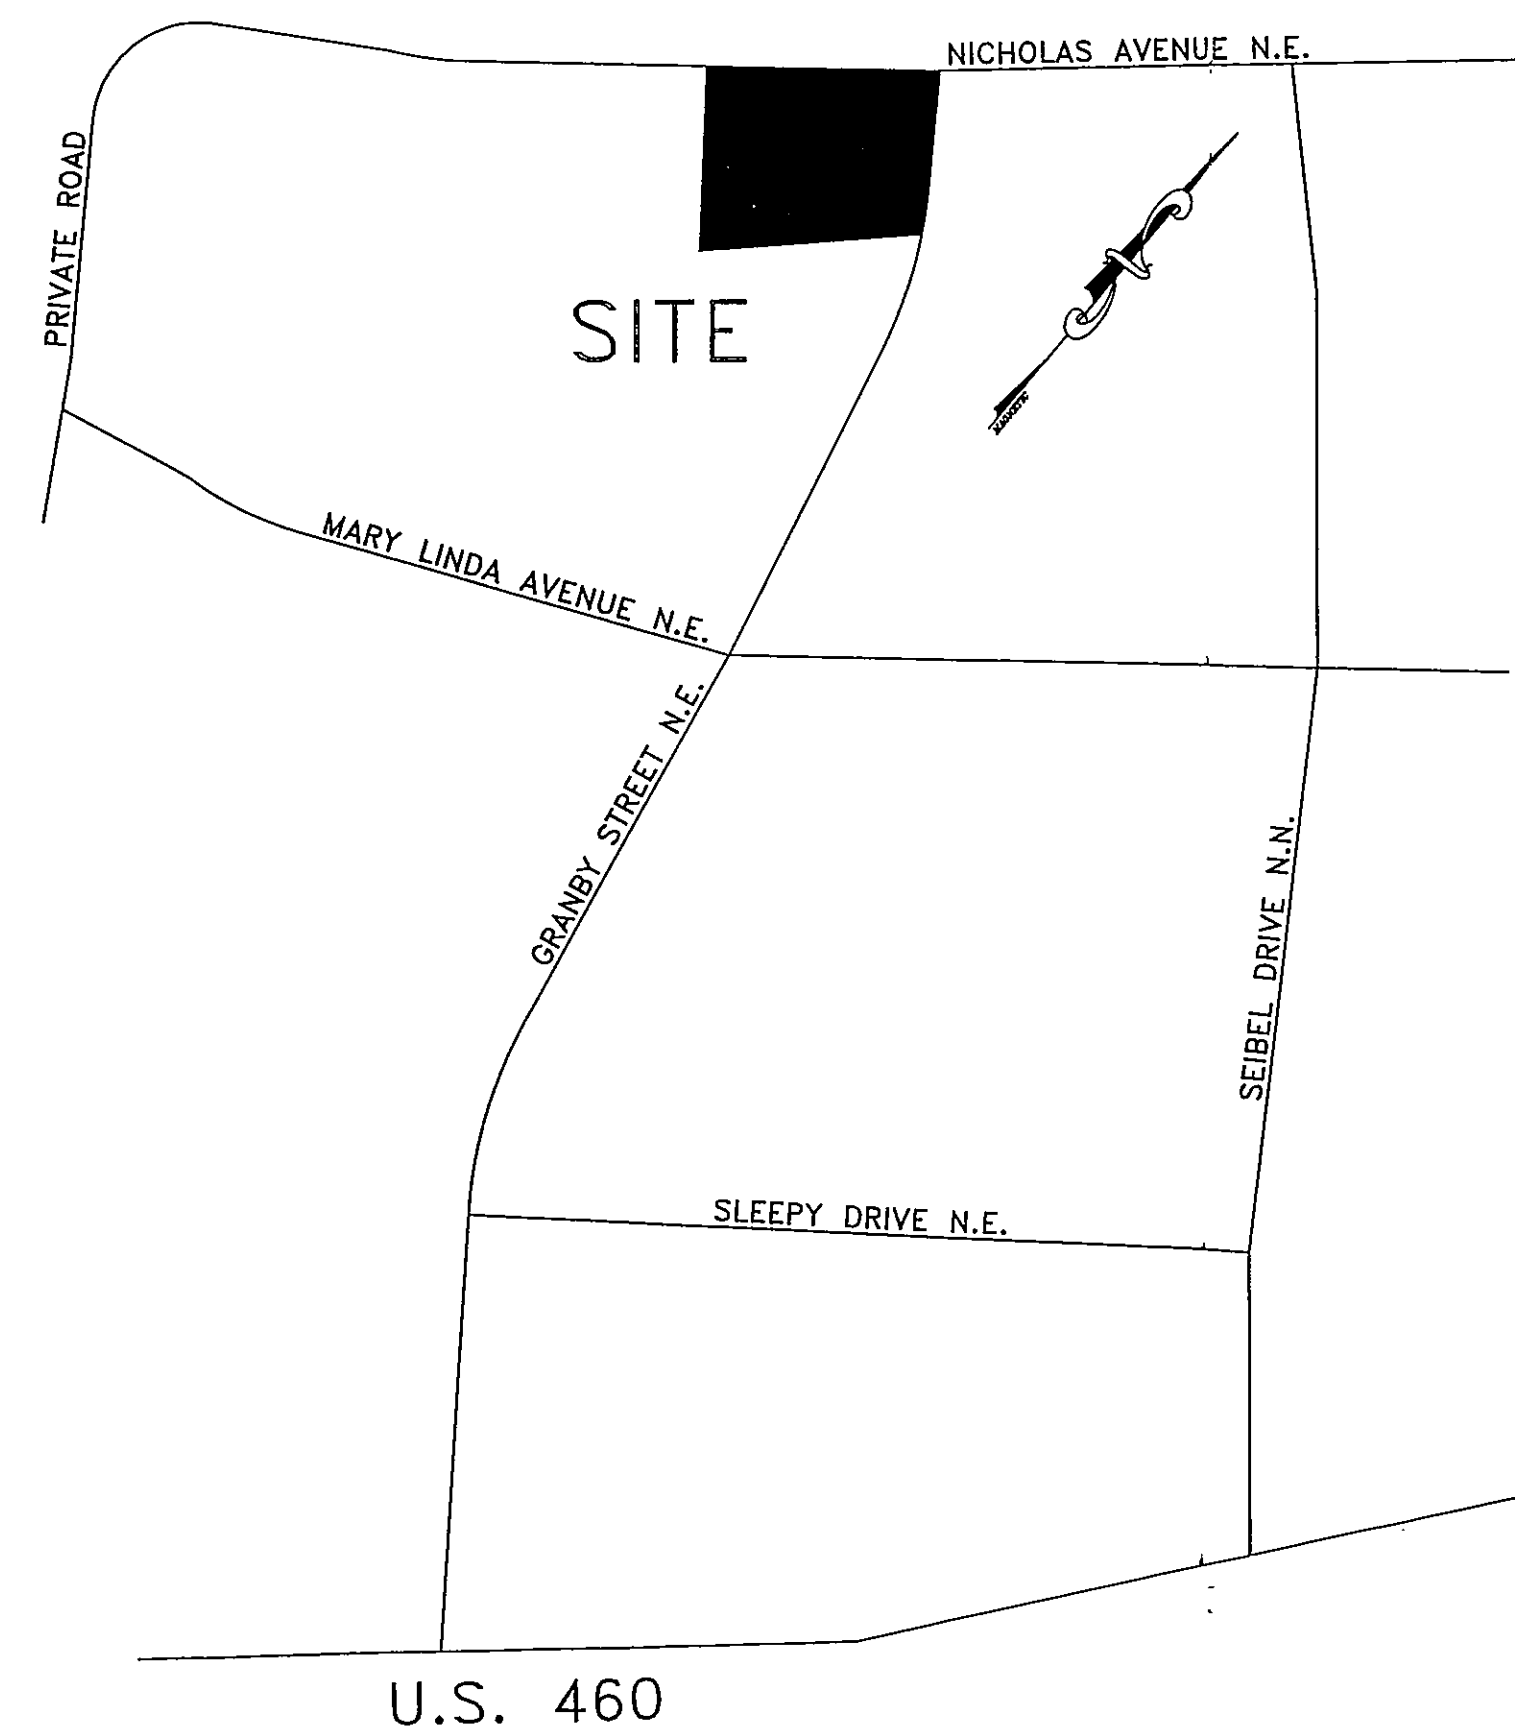

OFFICE OF CITY ENGINEER
ROOM 350
MUNICIPAL BUILDING
215 CHURCH AVENUE, S.W.
ROANOKE, VIRGINIA 24011

INDEX OF SHEETS

INDEX

- 1 - COVER SHEET
- 2 - EXISTING SITE
- 3 - PLAN SHEET
- 4 - GRADING / E & S SHEET
- 5 - LANDSCAPING SHEET
- 6 - E & S NARRATIVE
- 7 - MISCELLANEOUS DETAILS
- 8 - LOCAL FIRE HYDRANT LOCATION & ENTRANCE LOCATIONS

DEVELOPMENT PLAN APPROVED	
Date	8-22-06
Agent, Planning Commission	B. Townsend
Development Engineer	Carley Taylor 2/18/06
Zoning Administrator	AKH 8/22/06
Any changes to this approved plan must be coordinated with the agent to the Planning Commission and revisions approved prior to construction.	

RECEIVED

AUG 02 2006


CITY OF ROANOKE
PLANNING BUILDING AND DEVELOPMENT

AS-BUILT
8.6.07

CONSULTING ENGINEERS

PIERSON ENGINEERING & SURVEYING
P.O. BOX 311
1324 ROANOKE ROAD
DALEVILLE, VA 24083
540.966.3027
540.966.5906 (FAX)

COMMISSION NUMBER: R2006

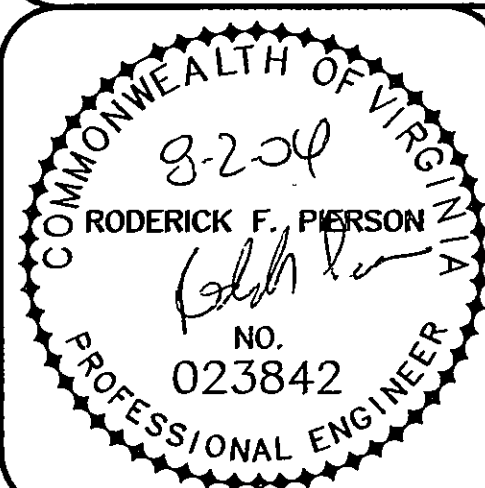

PROJECT NAME

NEW MANUFACTURING BUILDING
FOR
VISTA PROPERTIES, LLC

PROJECT NUMBER: _____

RFP REVISION BY	DESCRIPTION: PER CITY COMMENTS	06/16/06 DATE
RFP REVISION BY	DESCRIPTION: PER CITY COMMENTS	08/02/06 DATE
REVISION BY	DESCRIPTION:	DATE
REVISION BY	DESCRIPTION:	DATE

APPROVED FOR CONSTRUCTION

ROANOKE CITY ENGINEER

DATE

DIRECTOR OF PUBLIC WORKS

DATE

DIRECTOR OF UTILITIES AND OPERATIONS

DATE

DATE

DATE

ADVERTISED DATE: _____

SET NUMBER: _____

SHEET NUMBER: 1 OF 8