

PRE-CONSTRUCTION MEETING AND CONSTRUCTION COMMENCEMENT:

1. All construction methods and materials shall conform to the Construction Standards and Specifications of Roanoke County, the Western Virginia Water Authority, and the Virginia Department of Transportation.
2. Stormwater Management Agreements with an attached 8 1/2" x 11" or 8 1/2" x 14" plat must be approved and recorded prior to the pre-construction meeting.
3. Once all required items are submitted to Roanoke County, the developer must contact the Development Review Coordinator to indicate that a pre-construction meeting needs to be scheduled. The pre-construction meeting will be scheduled with the owner/developer two (2) working days later.
4. All land disturbing projects that require approval of an erosion and sediment control plan, grading or clearing permit shall require that the applicant provide the name of an individual who will be responsible for land disturbing activities and that this individual hold a Responsible Land Disturber (RLD) Certificate from the Department of Environmental Quality. The Responsible Land Disturber can be anyone from the Project team that is certified by the Commonwealth of Virginia to be in charge of carrying out the land disturbing activity for the project.
5. It is the responsibility of the owner/developer to notify the certified Responsible Land Disturber and the Utility Contractor to attend the pre-construction meeting.
6. The Development Review Coordinator will schedule the pre-construction meeting with the County Review Engineer, the County Inspector, and the Western Virginia Water Authority and the Town of Vinton Public Works Department if applicable.
7. An approved set of plans, Storm Water Pollution Prevention Plan (SWPPP), VSPMP coverage letter, and all permits must be available at the construction site at all times.
8. The developer and/or contractor shall supply all utility companies with copies of approved plans, advising them that all grading and installation shall conform to approved plans.
9. The project engineer will inform the owner/developer verbally and in writing of the County's obligation to perform inspections on site. Everyone in the meeting will be required to sign a pre-construction checklist indicating their knowledge of Roanoke County's obligation to perform inspections on site.
10. The Erosion Control Permit or Combined Erosion Control & VSPMP Permit is given to the developer at this pre-construction meeting.
11. Notify Roanoke County prior to beginning installation of ESC measures. The County will inspect initial installations to ensure compliance with approved plan prior to start of grading. The developer SHALL contact the project inspector 24 hours before beginning any grading or construction on the property.
12. County inspectors must inspect storm drain / stormwater management / BMP installations during the process of installation. Please contact the site inspector 24 hours in advance.
13. All work shall be subject to inspection by Roanoke County, the Western Virginia Water Authority and the Virginia Department of Transportation Inspectors.
14. Contractors shall notify utilities of proposed construction at least two (2), but not more than ten (10) working days in advance. Area public utilities may be notified thru "Miss Utility," 1-800-552-7001 or VA 811.
15. The 100 year Floodway shall be staked prior to any construction.
16. Grade stakes shall be set for all curb and gutter, culvert, sanitary sewer and storm sewer at all times of construction.
17. Roanoke County shall be notified when a spring is encountered during construction.
18. Construction debris shall be containerized in accordance with the Virginia Litter Control Act. No less than one litter receptacle shall be provided on site.
19. The contractor shall provide adequate means of cleaning mud from trucks and/or other equipment prior to entering public streets or rights of ways. It is the contractors responsibility to insure that the streets are in a clean, mud and dust free condition at all times.
20. Plan approval in no way relieves the developer or contractors of the responsibilities contained within the erosion and sediment control or stormwater management policies.
21. Field construction shall honor proposed drainage divides as shown on plans.
22. Field corrections shall be approved by the Roanoke County and/or the Western Virginia Water Authority and the Professional of Record, prior to such construction.
23. The developer or contractor shall supply the County and the Western Virginia Water Authority with correct As-Built plans before final acceptance.

VIRGINIA DEPARTMENT OF TRANSPORTATION:

1. Plan approval by Roanoke County does not guarantee issuance of any permits by the Virginia Department of Transportation.
2. A permit must be obtained from the Virginia Department of Transportation, Salem Residency Office prior to construction in the highway right-of-way.
3. The preliminary pavement designs should be based on a predicted sub-grade CBR value of 7.0 and with a Resiliency Factor (RF) of 2.0 as shown in the current edition of the Virginia Department of Transportation Pavement Design Guide for Subdivision Secondary Roads. The sub-grade soil is to be tested by an independent laboratory and the results submitted to the Virginia Department of Transportation prior to base construction. Should the sub-grade CBR value and/or the RF value be less than the predicted values, additional base material will be required in accordance with Departmental specifications. Refer to the same manual as the number and locations of the required soil samples to be tested. All pavement designs shall be submitted to the Department for review and approval. The sub-grade shall be approved by the Virginia Department of Transportation prior to placement of the base. Base shall be approved by the Virginia Department of Transportation for depth, template, and compaction before surface is applied.
4. Standard guardrail with safety end sections may be required on fills or in areas where hazards exist as deemed necessary. After completion of rough grading operations, the County Engineer and Virginia Department of Transportation shall be contacted to schedule a field review. Where guard rail is warranted, the standard shoulder width shall be provided and the guard rail shall be installed in accordance with the current edition of the VDOT Road and Bridge Standards as part of this development.
5. Standard street and traffic control signs shall be erected at each intersection by the developer prior to final street acceptance.
6. All traffic devices shall be in accordance with current edition of the "Manual on Uniform Traffic Control Devices" (MUTCD).
7. All unsuitable material shall be removed from the construction limits of the roadway before placing embankment.

See Sheet 4 for Stormwater Site Statistics Table.
See Sheet 4 for New BMP Information Table.

The Project Engineer shall provide electronic copies of the approved plans to the Development Review Coordinator within 5 working days of the pre-construction meeting.

The notes on this sheet shall not be modified.



COUNTY OF ROANOKE, VA


Inspector: Bruce Peters
Contractor: Jack St. Clair

NAME OF DEVELOPMENT	SITE DEVELOPMENT PLAN FOR VISTAR EYE CENTER		I, <u>H. H. H.</u> OWNER/DEVELOPER, AM AWARE OF THE SITE DESIGN REQUIREMENTS IMPOSED BY THIS SITE DEVELOPMENT PLAN, ALL REVISIONS THEREOF, AND OTHER APPLICABLE ROANOKE COUNTY CODES AND ORDINANCES.
MAGISTERIAL DISTRICT(S)	HOLLINS MAGISTERIAL DISTRICT		I HEREBY CERTIFY THAT I AGREE TO COMPLY WITH THESE REQUIREMENTS SHOWN ON THIS COVER SHEET UNLESS MODIFIED IN ACCORDANCE WITH LOCAL LAW.
OWNER (name, address, telephone)	RETINA LAND I, LLC ATTN: Herby Pierce (540) 855-5134		
DEVELOPER (name, address, telephone)	SAME AS OWNER		
ENGINEER, ARCHITECT OR SURVEYOR (name, address, telephone)	LUMSDEN ASSOCIATES, P.C. (540) 774-4411		
TAX MAP NO(S)	027.17-04-13.07-0000		1819 ELECTRIC RD. SUITE 1B ROANOKE, VA 24018 4664 BRAMBLETON AVENUE ROANOKE, VA 24018

WATER AND SEWER NOTES

1. All construction methods and materials shall conform to the latest edition of the Design and Construction Standards and Specifications of the Western Virginia Water Authority (WVWA) available at www.westernvawater.org or by contacting the authority at 540-853-5700. The project shall also comply with the governing jurisdiction's standards and other agency standards (e.g. VDOT, DEQ, DCR, VDH, etc.) where applicable.
2. A minimum cover of three (3) feet is required on all WVWA water and sewer lines.
3. All existing utilities may not be shown in their exact locations. The contractor shall notify Miss Utility and shall verify location and elevation of all underground utilities in the areas of construction prior to starting work.
4. Please show all WVWA water and sewer utilities on any development plan.
5. The location of existing utilities across or along the line of proposed work are not necessarily shown on the plans and where shown are only approximately correct. The contractor shall on his own initiative and at no extra cost, locate all underground lines and structures and potholes as necessary. The contractor shall be responsible for any damage to underground utilities and all damage incurred to existing utilities during construction shall be repaired at the contractor's expense.
6. Plan approval by the WVWA does not remove the contractor's responsibility to remove or relocate any existing conflicts found during construction.
7. The contractor shall maintain a minimum of 18" clearance vertically and two (2) feet minimum horizontally from the outside of pipe to outside of pipe with all other underground utilities. Where this cannot be achieved, additional measures in accordance with the WVWA standards shall be enforced.
8. All utility grade adjustments shall be in accordance with WVWA standards and are the responsibility of the contractor.
9. Field changes shall be submitted by the engineer of record to the locality and approved by the WVWA.

Western Virginia Water Authority
Availability letter number: _____

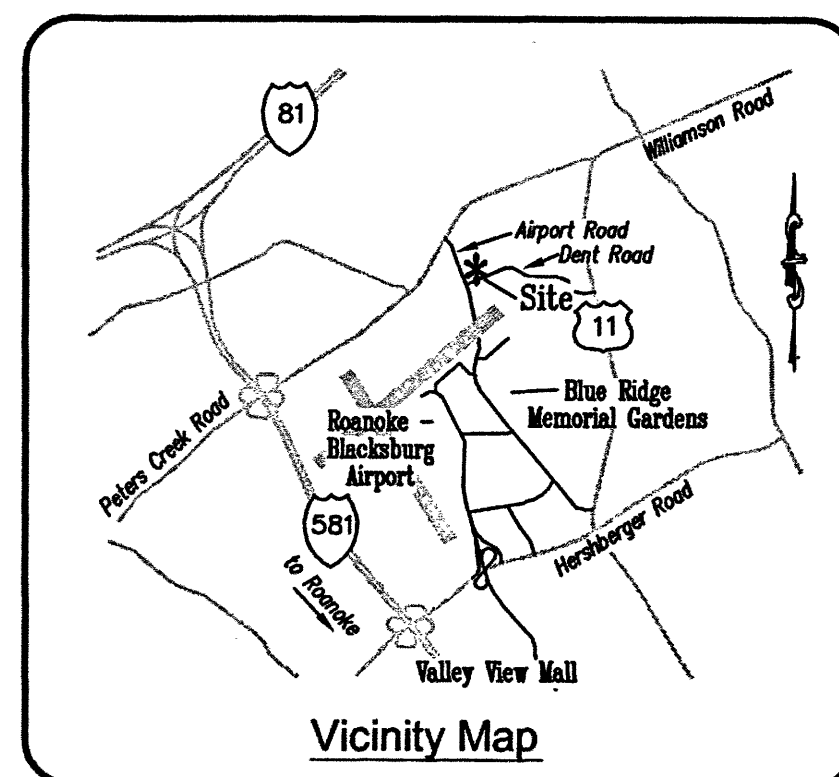

LEGEND

PRIVATE UTILITIES

Underground utilities installed on private property or in private utility easements and building related storm drains shall be designed and installed per the current edition of the Virginia Uniform Statewide Building Code (including amendments). Design and installation requirements issued by the Western Virginia Water Authority that meet or exceed the USBC requirements are acceptable for private utilities. All private utilities are to be permitted through and inspected by the Roanoke County Inspections Office. Vaults, valves and other devices installed by or under the control of the Western Virginia Water Authority may not substituted for the code required devices.

PR #:	NOTES:
Revision Table	

Revision Table

SHEET No.	DESCRIPTION
1....	ROANOKO COUNTY COVER SHEET
2....	NOTES & DETAILS
3....	EXISTING CONDITIONS AND DEMOLITION PLAN
4....	DIMENSIONAL LAYOUT
5....	GRADING PLAN
6....	STORM DRAIN, WATER & SANITARY SEWER PROFILES
7....	RETAINING WALL PROFILE
8....	LANDSCAPE PLAN
9....	PHASE I EROSION & SEDIMENT CONTROL PLAN
10....	PHASE II EROSION & SEDIMENT CONTROL PLAN
11...	EROSION & SEDIMENT CONTROL NOTES & DETAILS
12...	MAINTENANCE OF TRAFFIC PLAN
13...	VVWA DETAILS
14...	CONSTRUCTION DETAILS

Sheet Index

SURVEY INFORMATION

Horizontal and vertical control surveys were performed in year: 2020
by: Lumsden Associates, P.C.

All vertical elevations must be referenced to the National Geodetic Vertical Datum of 1929 or 1988. All horizontal elevations must be referenced to the North American Datum of 1927 or 1983.

Source of topographic mapping is dated: 2020

Boundary was performed by: Lumsden Associates, P.C., dated: 2020

Benchmark Information: See Sheet 3

The professional seal and signature certifies the boundary survey and topographic mapping to be accurate and correct.

QUANTITY & COST ESTIMATE					
ITEM	QUANTITY	UNIT	UNIT PRICE	COST	BONDABLE
CLEARING AND GRUBBING	3.9	ACRES	\$1,500.00	\$5,850.00	\$5,850.00
EARTHWORK	24,000	C.Y.	\$10.00	\$240,000.00	\$240,000.00
CURB INLET DI-3	7	EACH	\$2,000.00	\$14,000.00	\$14,000.00
GRATE INLET DI-1	0	EACH	\$1,200.00	\$0.00	\$0.00
GRATE INLET DI-7	0	EACH	\$1,500.00	\$0.00	\$0.00
STORM DRAIN MANHOLE	2	EACH	\$1,200.00	\$2,400.00	\$2,400.00
15 IN. SD	674	L.F.	\$25.00	\$16,850.00	\$16,850.00
18 IN. SD	10	L.F.	\$35.00	\$350.00	\$350.00
24 IN. SD	69	L.F.	\$50.00	\$3,450.00	\$3,450.00
12 IN. ENDWALL EW-1	0	EACH	\$700.00	\$0.00	\$0.00
15 IN. ENDWALL EW-1	0	EACH	\$800.00	\$0.00	\$0.00
18 IN. ENDWALL EW-1	0	EACH	\$1,000.00	\$0.00	\$0.00
24 IN. ENDWALL EW-1	0	EACH	\$1,300.00	\$0.00	\$0.00
30 IN. ENDWALL EW-1	0	EACH	\$1,600.00	\$0.00	\$0.00
36 IN. ENDWALL EW-2	0	EACH	\$2,000.00	\$0.00	\$0.00
15 IN. END SECTION ES-1	0	EACH	\$500.00	\$0.00	\$0.00
18 IN. END SECTION ES-1	0	EACH	\$700.00	\$0.00	\$0.00
24 IN. END SECTION ES-1	1	EACH	\$900.00	\$900.00	\$900.00
30 IN. END SECTION ES-1A	2	EACH	\$1,000.00	\$2,000.00	\$2,000.00
36 IN. END SECTION ES-1	0	EACH	\$1,600.00	\$0.00	\$0.00
CURB CG-2	1,858	L.F.	\$12.00	\$22,296.00	\$22,296.00
CURB & GUTTER CG-6	1,331	L.F.	\$16.00	\$21,296.00	\$21,296.00
8 IN. AGGREGATE BASE 21-B	3,468	S.Y.	\$10.00	\$34,680.00	\$34,680.00
10 IN. AGGREGATE BASE 21-B	4,517	S.Y.	\$8.00	\$36,136.00	\$36,136.00
2 IN. ASPHALT PAVEMENT SM-9.5A	7,985	S.Y.	\$6.00	\$47,910.00	\$47,910.00
3 IN. ASPHALT PAVEMENT BM-25	4,517	S.Y.	\$5.00	\$22,585.00	\$22,585.00
6 IN. WATER LINE	563	L.F.	\$60.00	\$33,780.00	\$33,780.00
FIRE HYDRANT ASSEMBLIES	1	EACH	\$3,500.00	\$3,500.00	\$3,500.00
BLOW OFFS W/VAULT, FRAME & COVER	0	EACH	\$1,400.00	\$0.00	\$0.00
6 IN. GATE VALVES W/VAULT, FRAME & COVER	1	EACH	\$1,200.00	\$1,200.00	\$1,200.00
8 IN. SANITARY SEWER	0	L.F.	\$50.00	\$0.00	\$0.00
6 IN. SANITARY SEWER	341	L.F.	\$45.00	\$15,345.00	\$15,345.00
STANDARD MANHOLE W/FRAME & COVER	0	EACH	\$3,000.00	\$0.00	\$0.00
SANITARY SEWER CLEANOUT	8	EACH	\$750.00	\$6,000.00	\$6,000.00
SANITARY SEWER JACK & BORE	1	LUMP SUM	\$10,000.00	\$10,000.00	\$10,000.00
SITE LANDSCAPING	1	LUMP SUM	\$37,500.00	\$37,500.00	\$37,500.00
RETAINING WALL	1	LUMP SUM	\$110,000.00	\$110,000.00	\$110,000.00
CONCRETE SIDEWALKS	4,880	S.F.	\$5.00	\$24,400.00	\$24,400.00
CONCRETE DUMPSTER PADS	200	S.F.	\$8.00	\$1,600.00	\$1,600.00
CONCRETE ENTRANCE	1	LUMP SUM	\$5,000.00	\$5,000.00	\$5,000.00
EC-3 Type "A" GRASS DITCH	4560	S.F.	\$5.00	\$22,800.00	\$22,800.00
STORMWATER MANAGEMENT	1	LUMP SUM	\$65,000.00	\$65,000.00	\$65,000.00
AS-BUILT PLANS (STORM SEWER SYSTEMS)	1	LUMP SUM	\$2,500.00	\$2,500.00	\$2,500.00
AS-BUILT PLANS (STORMWATER MANAGEMENT)	1	LUMP SUM	\$2,500.00	\$2,500.00	\$2,500.00
SUBTOTAL				\$811,828.00	\$811,828.00
10% CONTINGENCY				\$81,183.00	\$81,183.00
ESTIMATED TOTAL				\$893,011.00	\$893,011.00
BY SEALING THE PLANS, THE DESIGN PROFESSIONAL HEREBY CERTIFIES THAT THE FOREGOING ESTIMATE REFLECTS THE CURRENT IMPROVEMENT COSTS OF THIS PROJECT.					

BY SEALING THE PLANS, THE DESIGN PROFESSIONAL HEREBY CERTIFIES THAT THE FOREGOING ESTIMATE REFLECTS THE CURRENT IMPROVEMENT COSTS OF THIS PROJECT.

PHONE: (540) 774-4411
FAX: (540) 772-9445
WWW.LUMSDENPC.COM


4664 BRAMBLETON AVENUE, SW
P.O. BOX 20669
ROANOKE, VIRGINIA 24018

LUMSDEN ASSOCIATES, P.C.
COMMISSION NUMBER:

2020-297

Lumsden Associates, P.C.
ENGINEERS | SURVEYORS | PLANNERS

ENGINEERS | SURVEYORS | PLANNERS

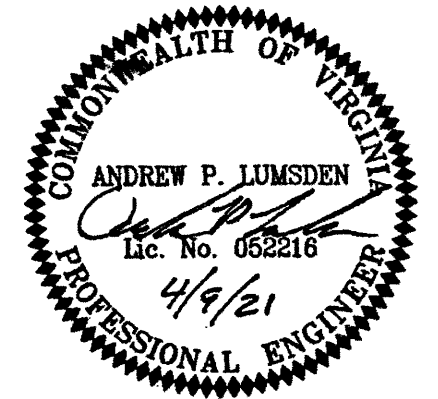

As built
7-13-2022

APPROVED

PLAN DATE:
April 9, 2021



PLAN APPROVED
Denise Saville
REVIEW COORDINATOR, 6/15/2021

**SITE DEVELOPMENT PLAN
PREPARED FOR
VISTAR EYE CENTER
PREPARED FOR
RETINA LAND I, LLC**

PREPARED FOR
RETINA LAND I, LLC
LOCATED AT THE INTERSECTION OF
AIRPORT ROAD & DENT ROAD
ROANOKE COUNTY, VIRGINIA

SHEET
1
OF
14