

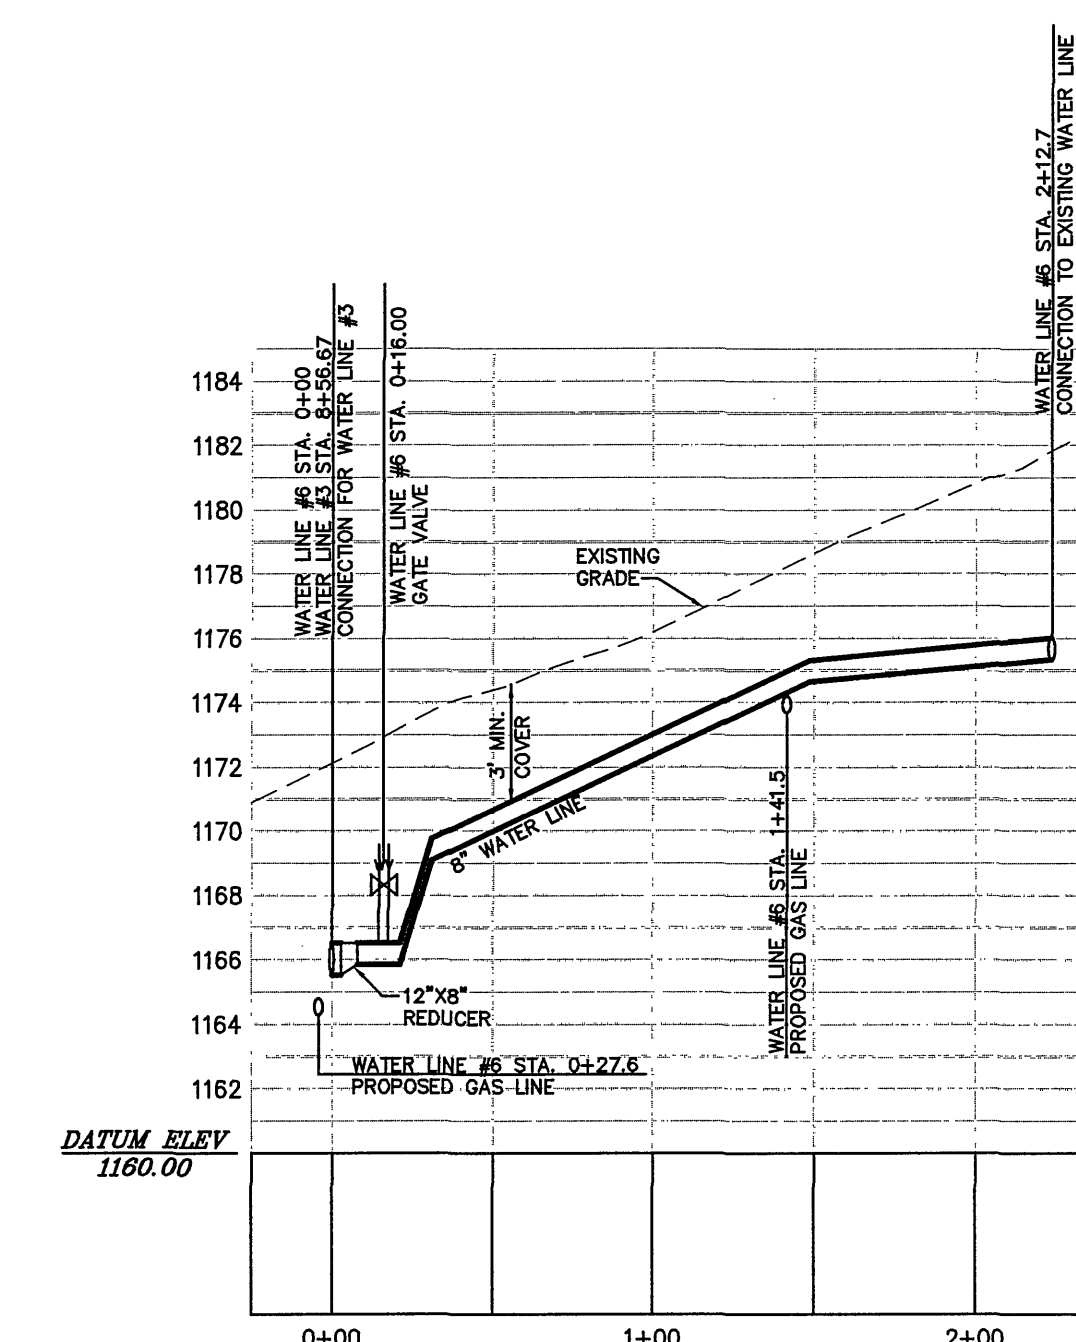


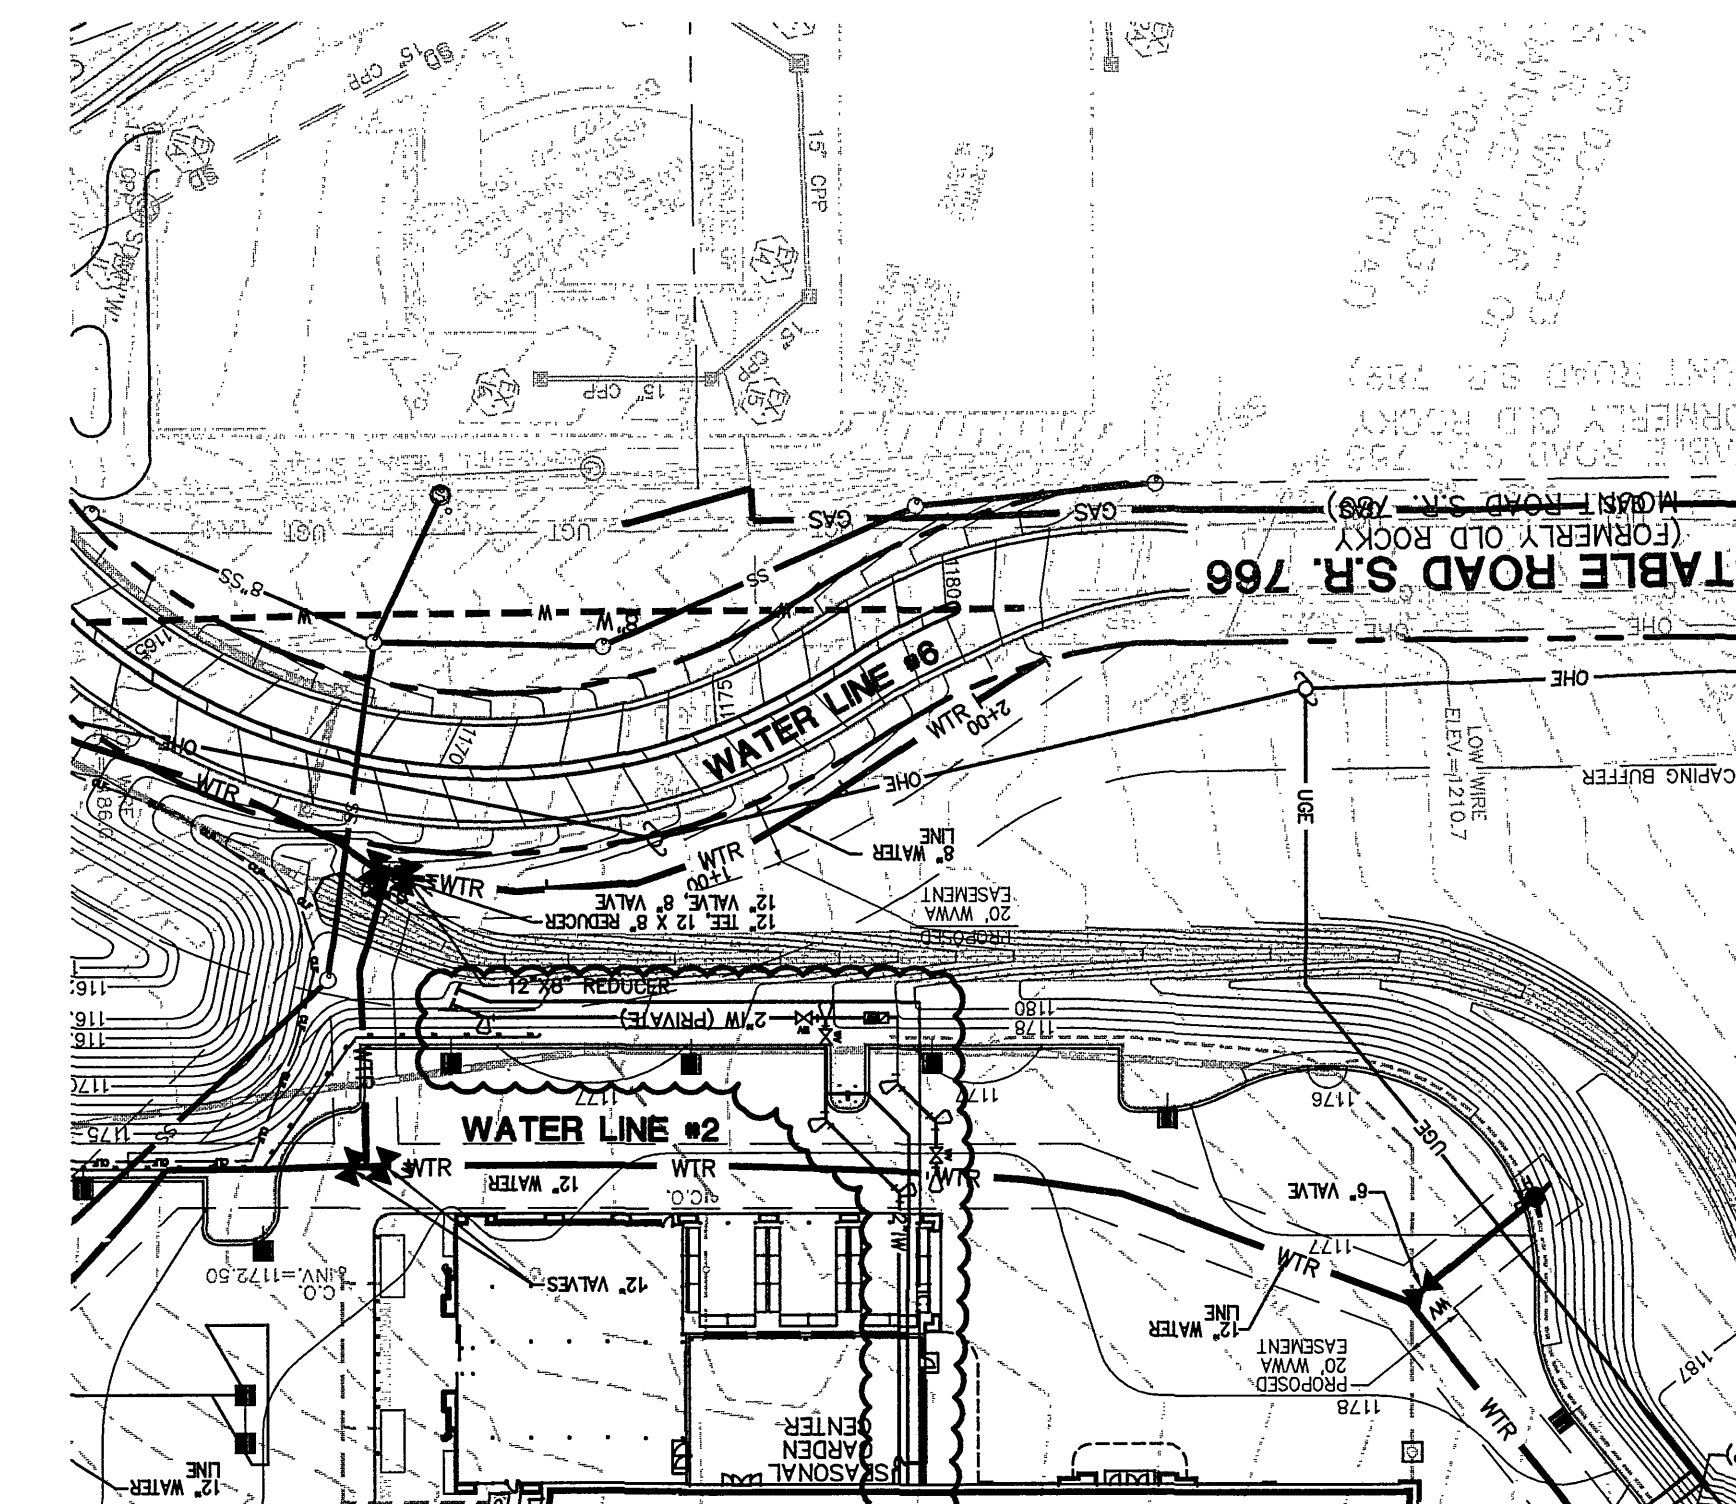


RECORD WATER LINE

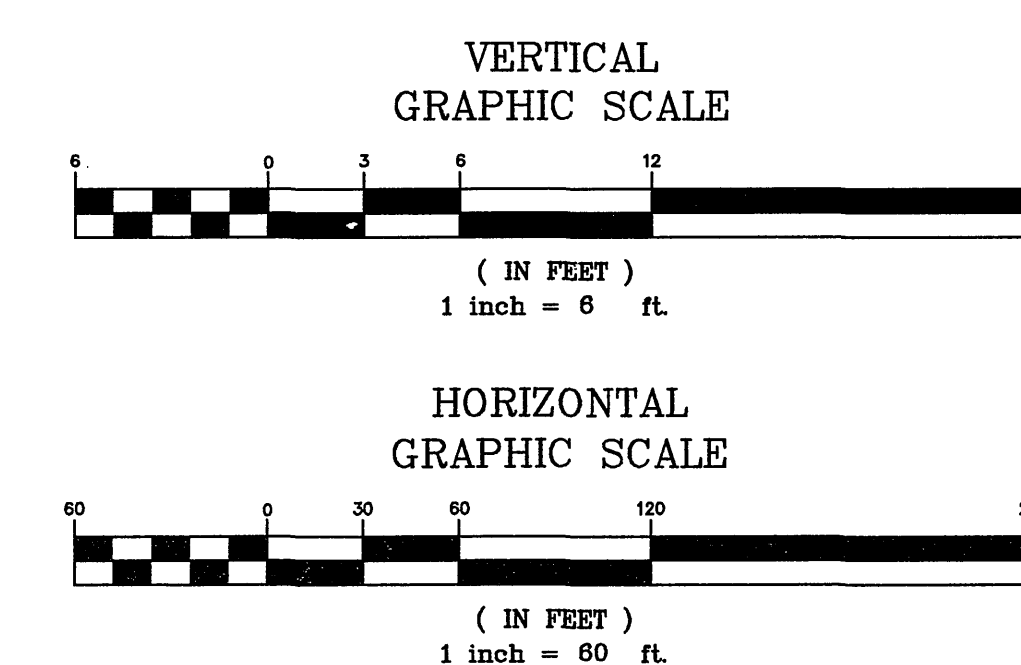

**DESIGN ELEVATIONS FOR ALL
WATERLINE PROFILES ARE
ASSUMED TO BE ACCURATE.
NO FIELD DATA PROVIDED**

W
Wolverton & Associates
Consulting Engineers + Land Surveyors
6745 Sugarloaf Parkway • Suite 100 • Duluth, Georgia 30097
Phone: (770) 487-8899 • Fax: (770) 487-8970
www.wolverton-assoc.com

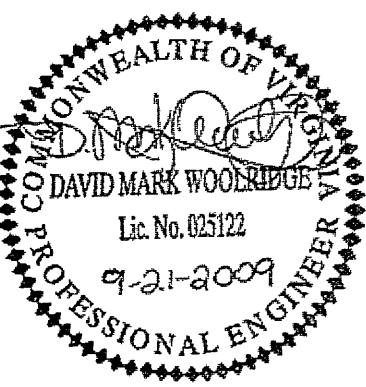

Project Title, Walmart  SUPERCENTER #1301-02
@ CLEARBROOK VILLAGE SHOPPING CENTER
ROANOKE COUNTY, VIRGINIA
BY: WAL-MART REAL ESTATE BUSINESS TRUST
BENTONVILLE, AR

[illegible]

DRAWN BY	RD
CHECKED BY	BGL
DATE:	9/21/2009
SCALE:	1"=60'H/1"-6"V
JOB No.	08-203
SHEET NUMBER	

WL-4

08-203V10-NOSHOPS RECORD DRAWINGS.DWG