


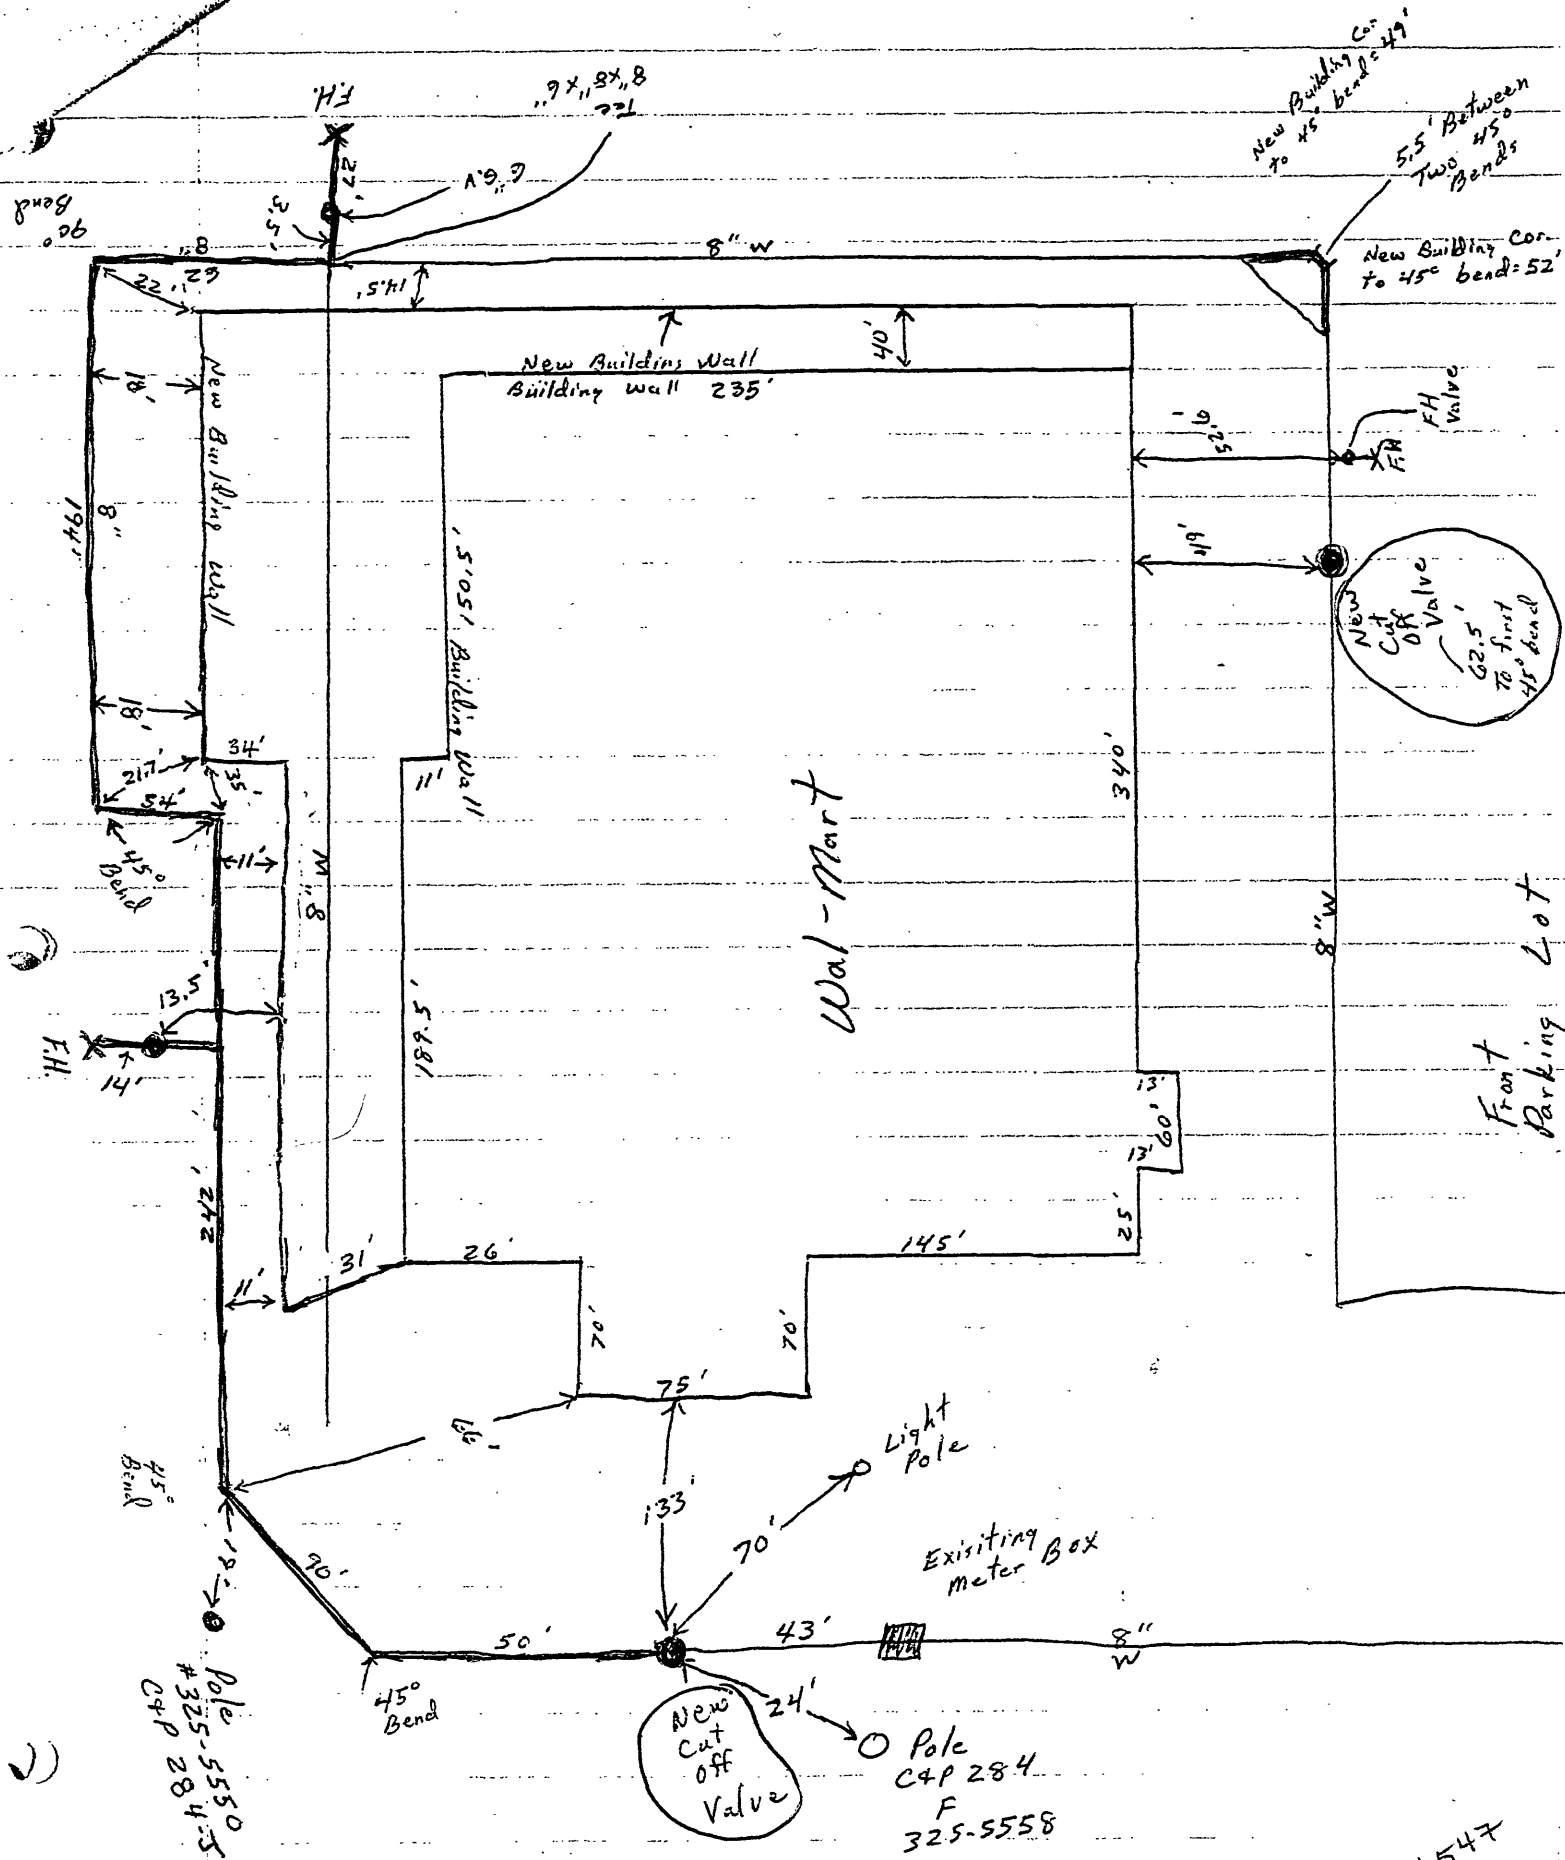

Wal-Mart (Water Line As Built) 6/14/1993
REPAIRING ROAD (25' 27' 00' S.W.)

7547