


DATE	NO.	SIZE	MAKE	OPEN	TURNS
90	1	6	Mueller	R	21

P. I. Measurements		
No.	Distance	Direction

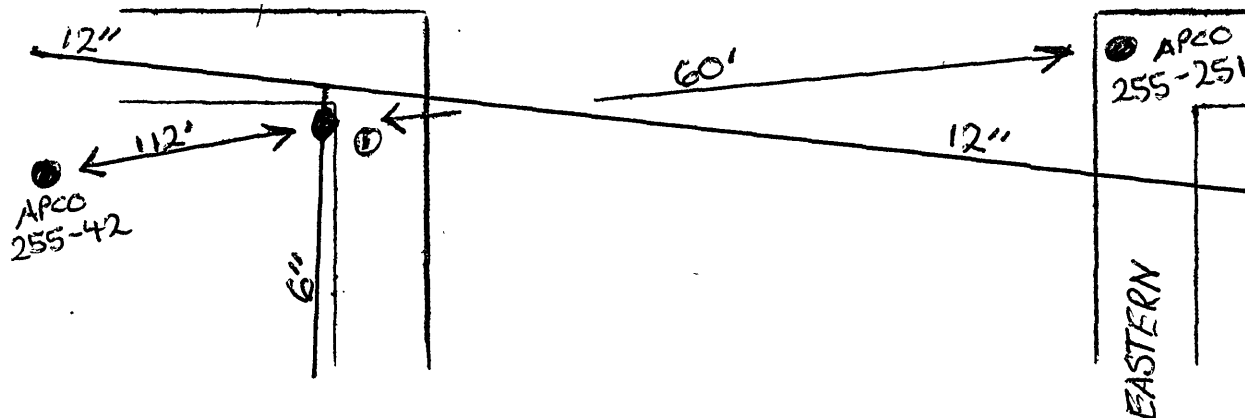

CITY OF ROANOKE - WATER DEPT.	
VALVE DIAGRAM	
W. 1st St. & N. 1st St. EASTERN	
N.E. + Gus Nicks Blvd NE	
Sec. Map 333	
Date:	Page No.