


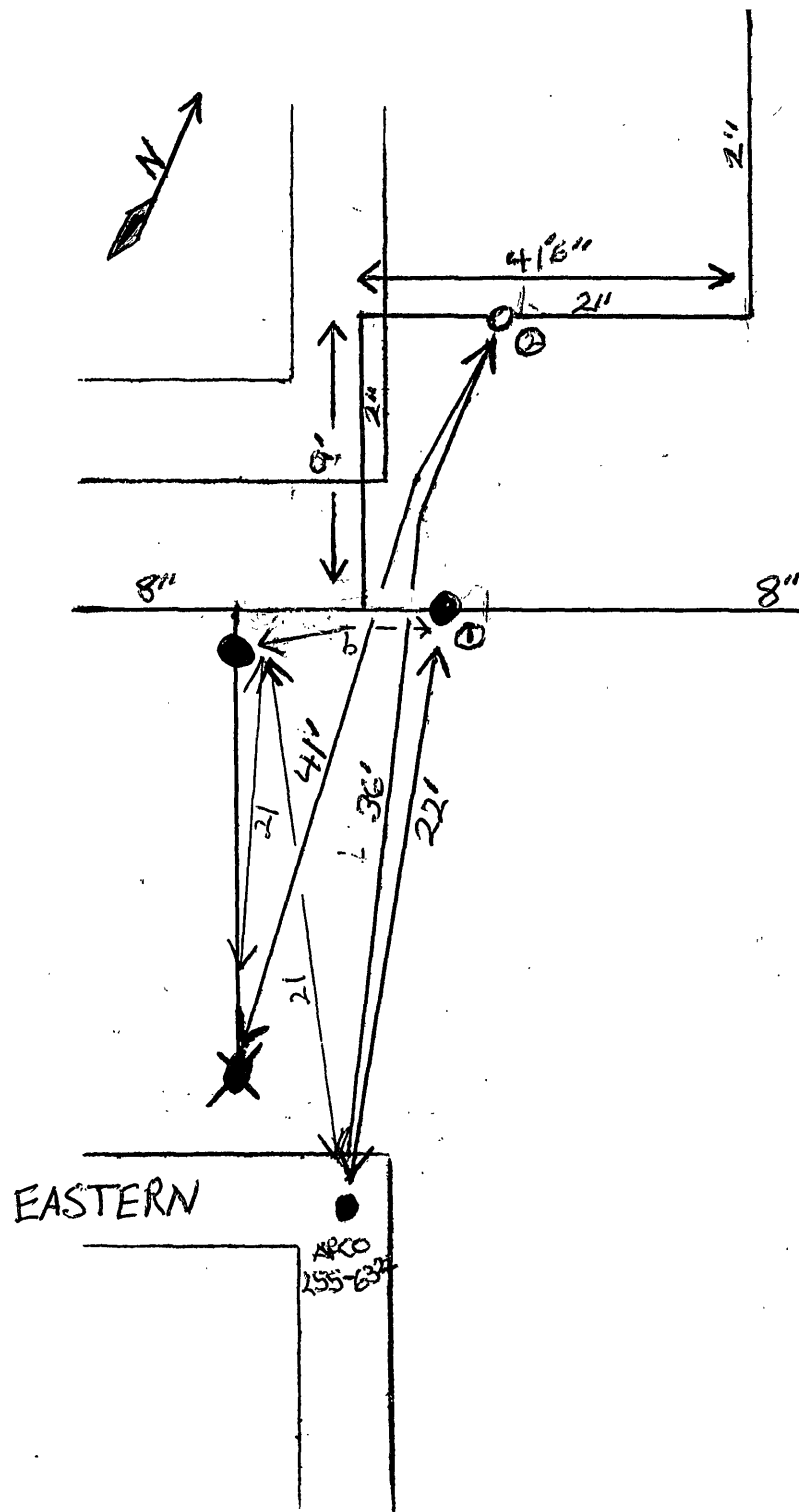

Light St

DATE	NO.	SIZE	MAKE	OPEN	TURNS
'59	1	8"	DARLING	R	27
90	2	2"	MISC	L	6 1/2
	3	8"		R	27

P. L. Measurements

No.	Distance	Direction

CITY OF ROANOKE - WATER DEPT.

VALVE DIAGRAM

EASTERN + Light St N.E.

Sec. Map 322

Date

Page No.