


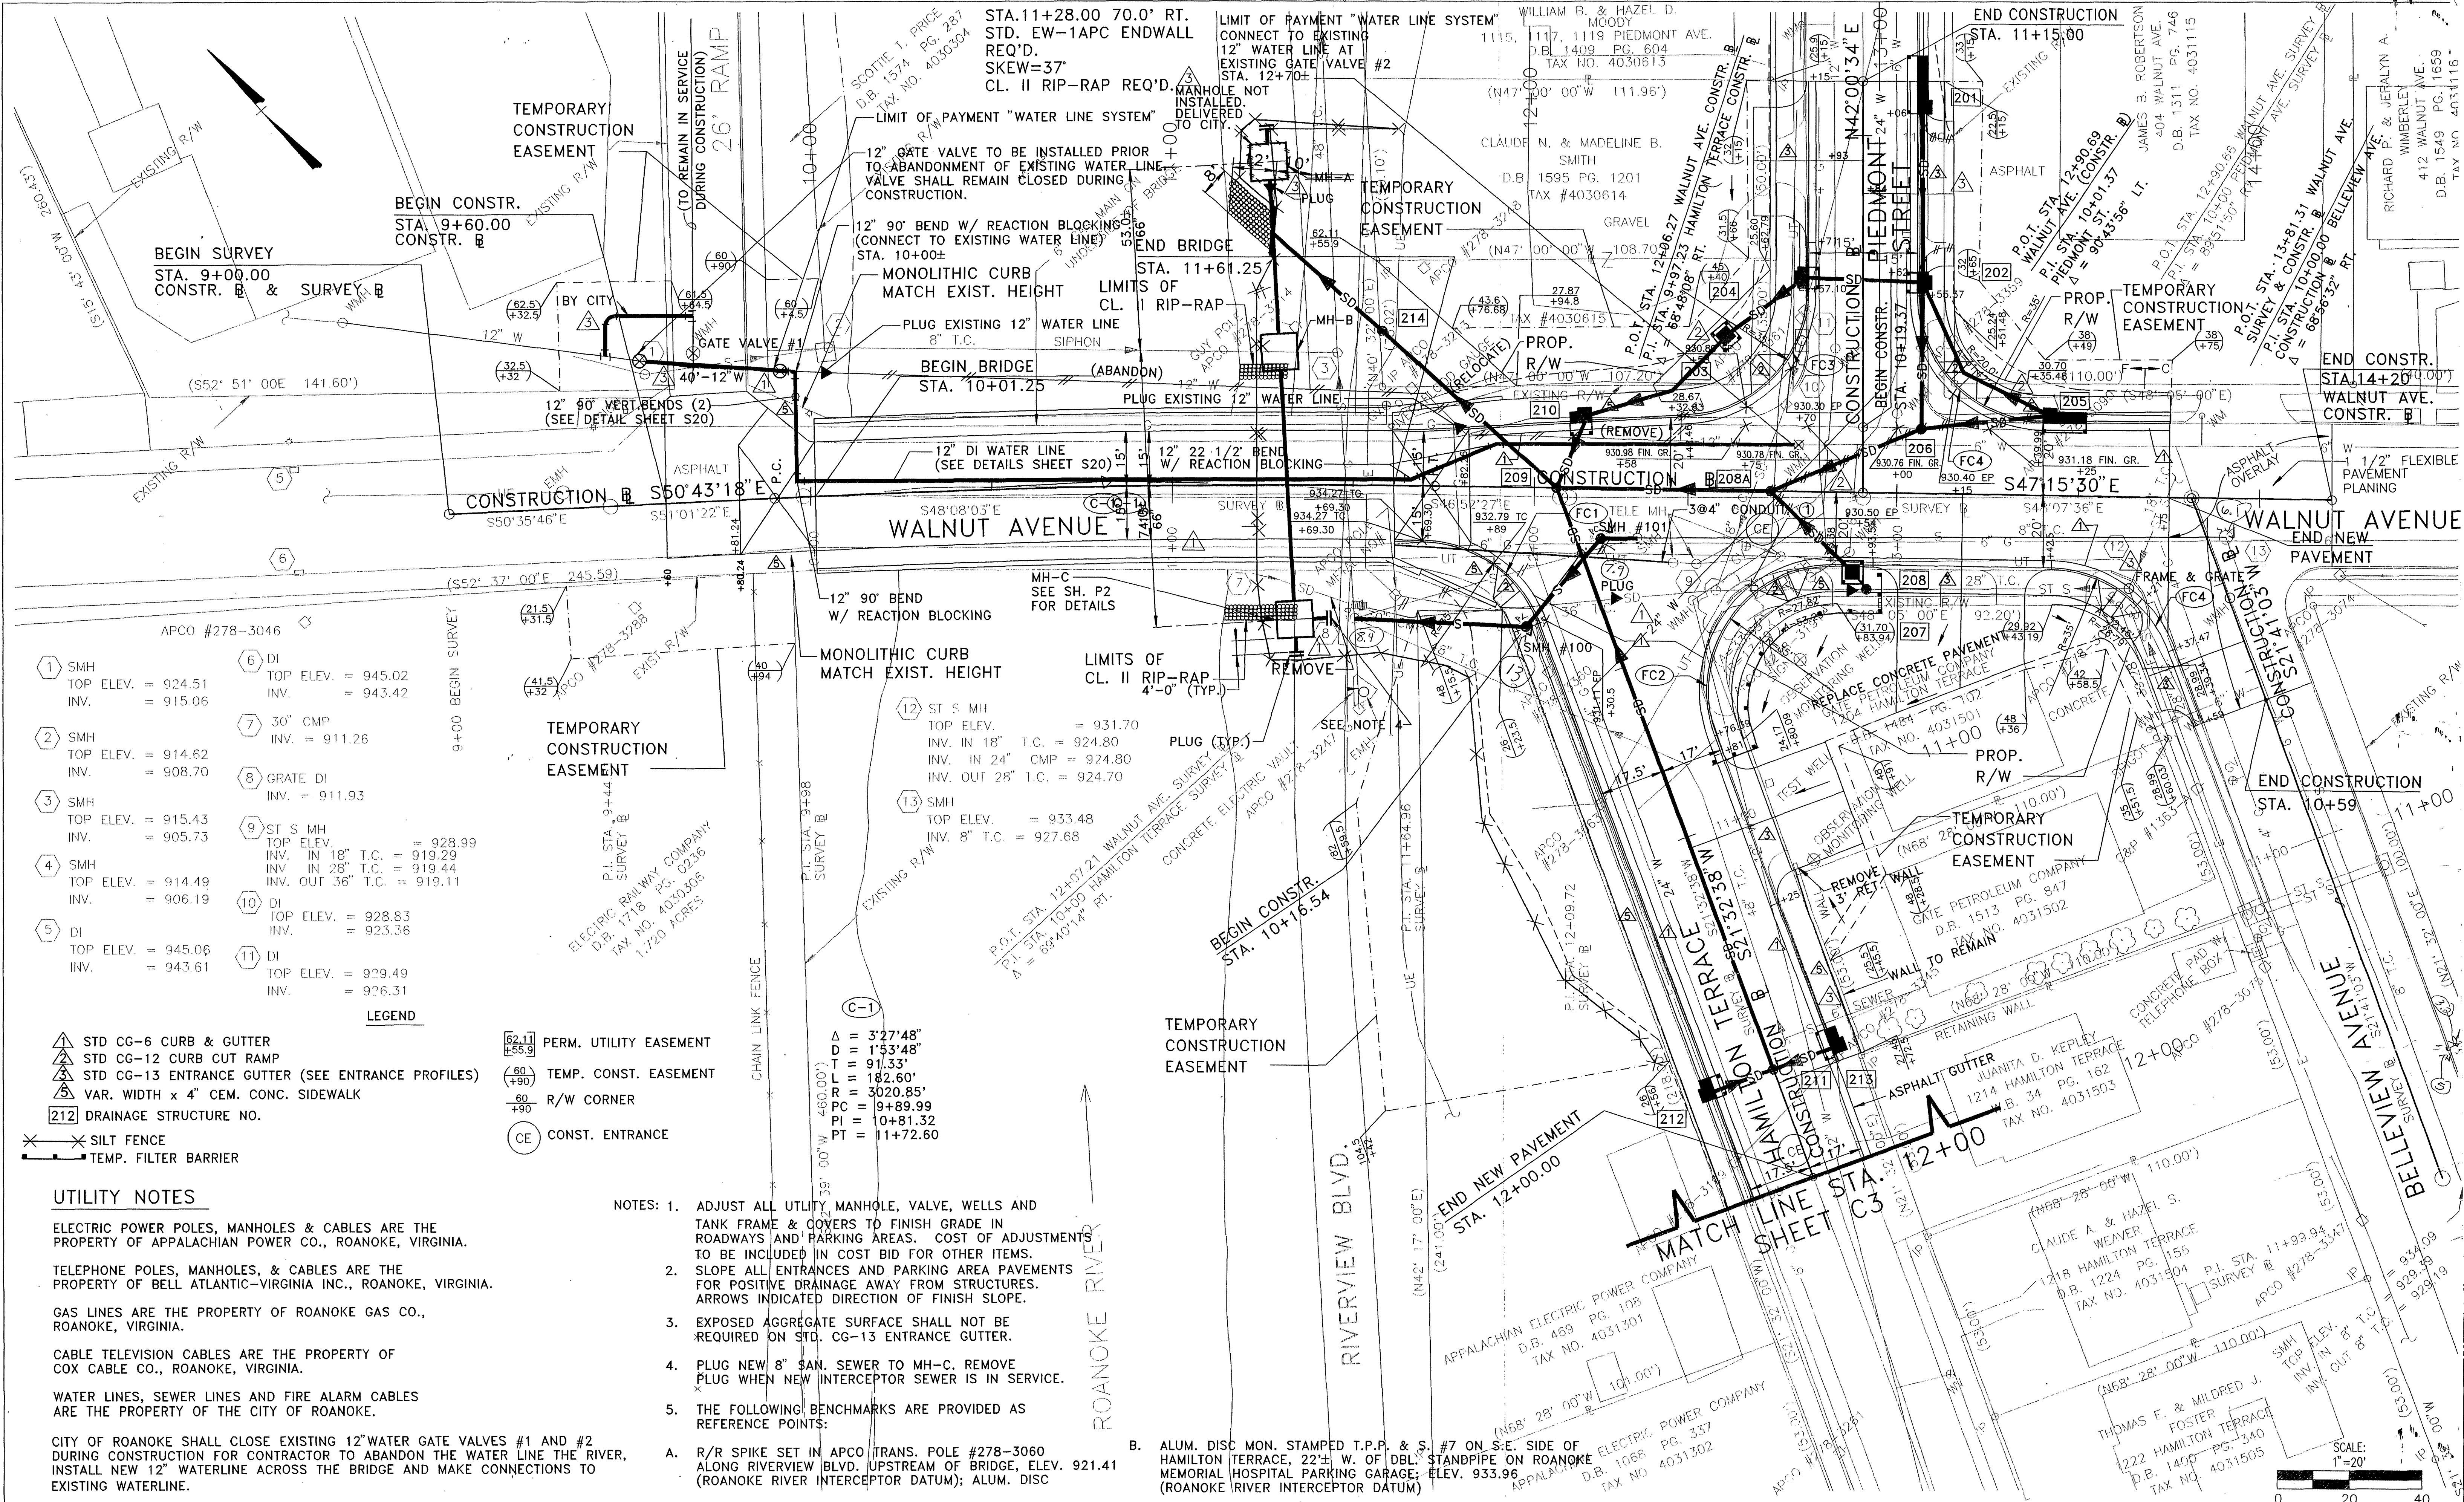

 Mattern & Craig CONSULTING ENGINEERS – SURVEYORS	DESIGNED:		REV.	DATE	DESCRIPTION	BY	APP.	DATE MARCH 1995 COMM. NO. 1200A	REPLACEMENT OF WALNUT AVENUE BRIDGE OVER ROANOKE RIVER CITY OF ROANOKE, VIRGINIA STREET IMPROVEMENT PLAN	SHEET C2
	MSA		1	9/20/95	ADDITION OF EXIST. 24" WATERLINE, NEW 12" GATE VALVE, STUB & PLUG 8" FOR SANITARY SEWER INTERCEPTOR	SMM	MSA			
	DRAWN:		2	10/24/96	STORM DRAINAGE REVISED	JMB	MSA			
	JLJ/FMP		3	7/14/97	RECORD DRAWINGS,	JMC	SAC			
CHECKED:	JMB									

PROJECT NO. 6238
As-Built

11-15-05 LBR
9.14.05