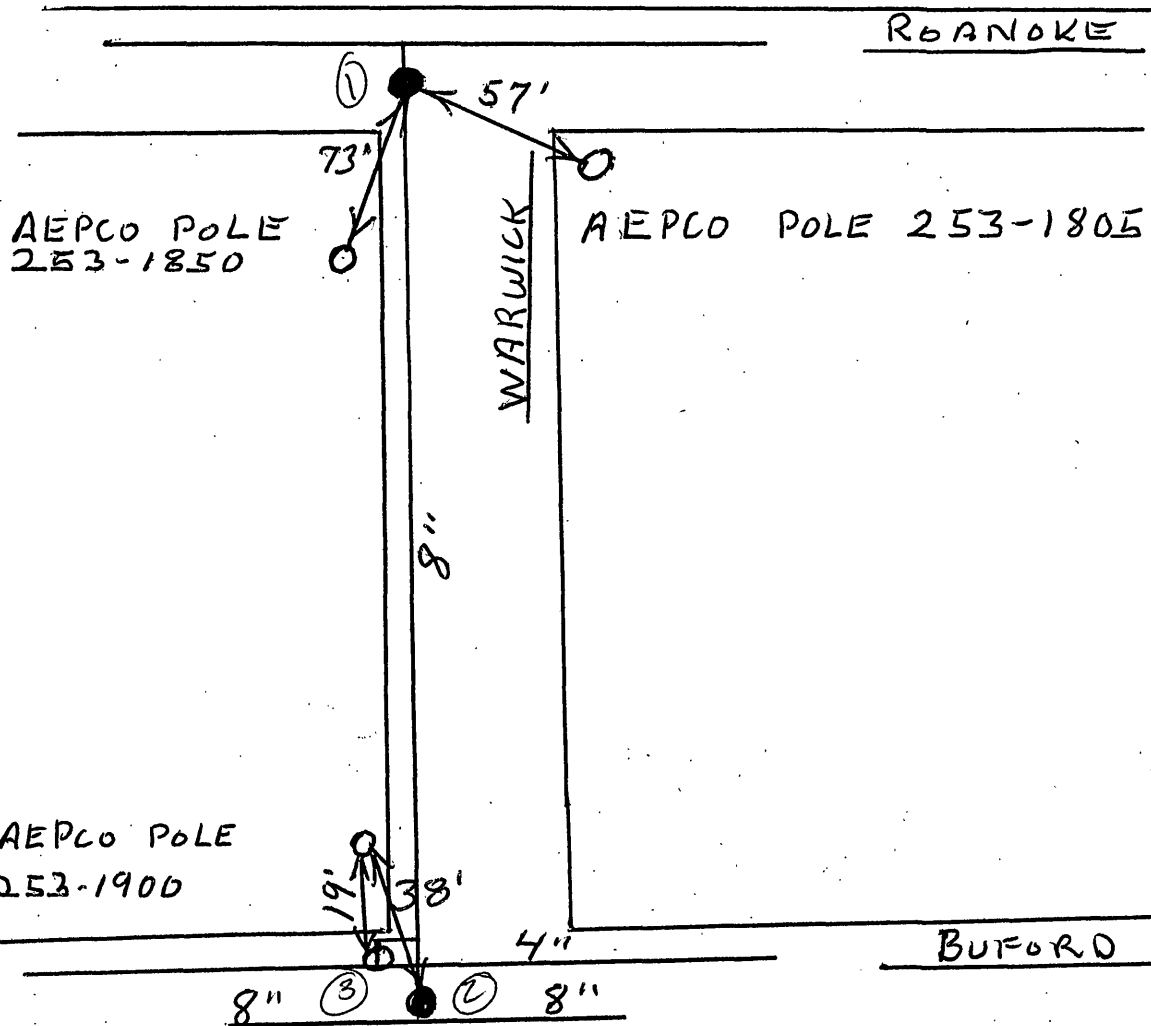


[illegible]

CITY OF ROANOKE—WATER DEPT
VALVE DIAGRAM

Buford Peanok, Warwick,

SEC. MAP

142

DATE

PAGE NO.